




1. SEE SHEET 16 OF 26 FOR CURB & GUTTER DETAIL.
2. ALL DIMENSIONS ARE TO BACK OF CURB UNLESS OTHERWISE NOTED.



This drawing is a compilation of the original sealed engineering drawing and modifications by addenda, change orders and information furnished by the contractor. Information shown that was provided by the contractor and others not associated with the design engineer cannot be verified for accuracy or completeness. Original sealed drawing is on file at the office of AECOM Technical Services, Inc.,
TBPE REG. NO. F-3580

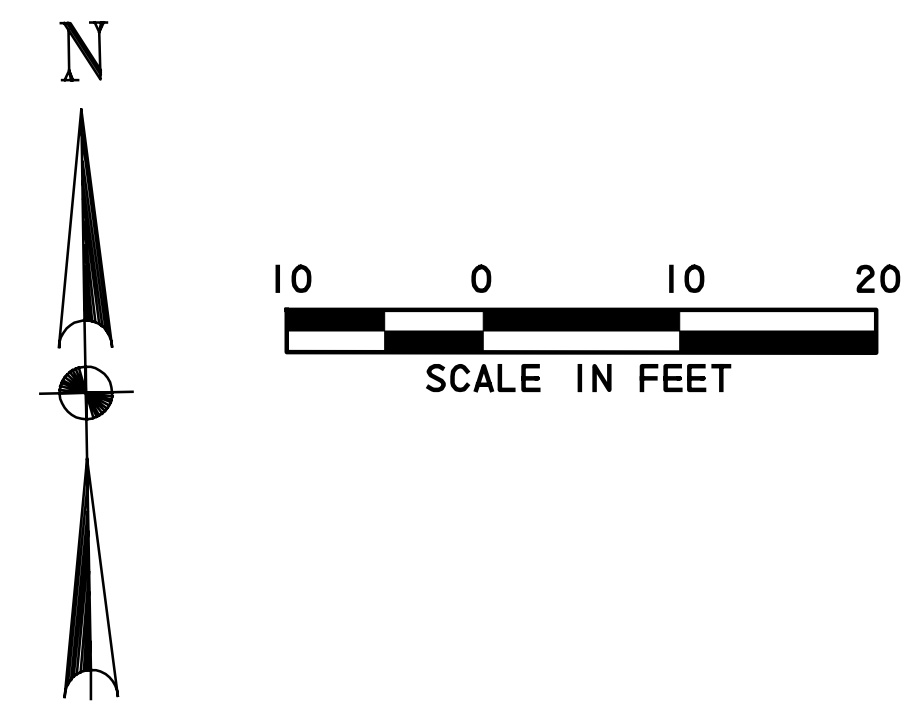

☐	DRIVEWAY ENTRANCE ADDED	THG	4/2010
NO.	REVISION	BY	DATE
AIRPORT ROAD			
BALLPARK PARKING LOT TO SERVICE CENTER DRIVEWAY			
 City of Rockwall, Texas			
 AECOM TECHNICAL SERVICES, INC. 16000 DALLAS PARKWAY, SUITE 350 DALLAS TEXAS 75248 WWW.AECOM.COM TBPE REG. NO. F-3580			
Unit	PW-DAL	Scale: Horiz AS Vert AS	SHOWN SHOWN
Designed	Checked	THG	Project No. 60004153
Drawn	Approved	THG	Sheet 16A of 26