


BREWER PROPERTIES, L.P.
VOLUME 2930 PAGE 187
D.R.R.C.T.
16.84 ACRES

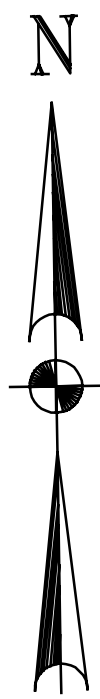

20 0 20 40
SCALE IN FEET
HORIZONTAL

5 0 5 10
SCALE IN FEET
VERTICAL

LEGEND

- PROPOSED CONCRETE PAVEMENT
- REMOVE & REPLACE ASPHALT PAVEMENT
- EXISTING CONCRETE TO BE REMOVED
- CURB INLET
- MANHOLE
- DRAINAGE FLOW
- SPOT ELEV. (PROP.)

NOTE:

- ALL DIMENSIONS ARE TO BACK OF CURB UNLESS OTHERWISE NOTED.
- SALVAGE EXIST. CONCRETE WHEEL STOPS AND REINSTALL ON NEW PAVEMENT.
- PAINT PARKING SPACE STRIPES. MATCH EXISTING STRIPING FOR COLOR, LINE WIDTH, LENGTH AND SPACING. STRIPING PAINT SHALL BE PERMA-STRIP STRIPING PAINT AS MANUFACTURED BY TEXAS REFINERY CORP. OR APPROVED EQUAL.

NO.	REVISION	BY	DATE

AIRPORT ROAD

BALLPARK PARKING LOT MODIFICATIONS





City of Rockwall, Texas


AECOM

AECOM TECHNICAL SERVICES, INC.
16000 DALLAS PARKWAY, SUITE 350
DALLAS TEXAS 75248
WWW.AECOM.COM
TBPE REG. NO. F-3580


Unit	PW-DAL	Scales	Horz AS SHOWN Vert AS SHOWN	Date	8/2/2012
Designed	THG	Checked	THG	Project No.	60004153
Drawn	JJ	Approved	THG	Sheet	16 of 26

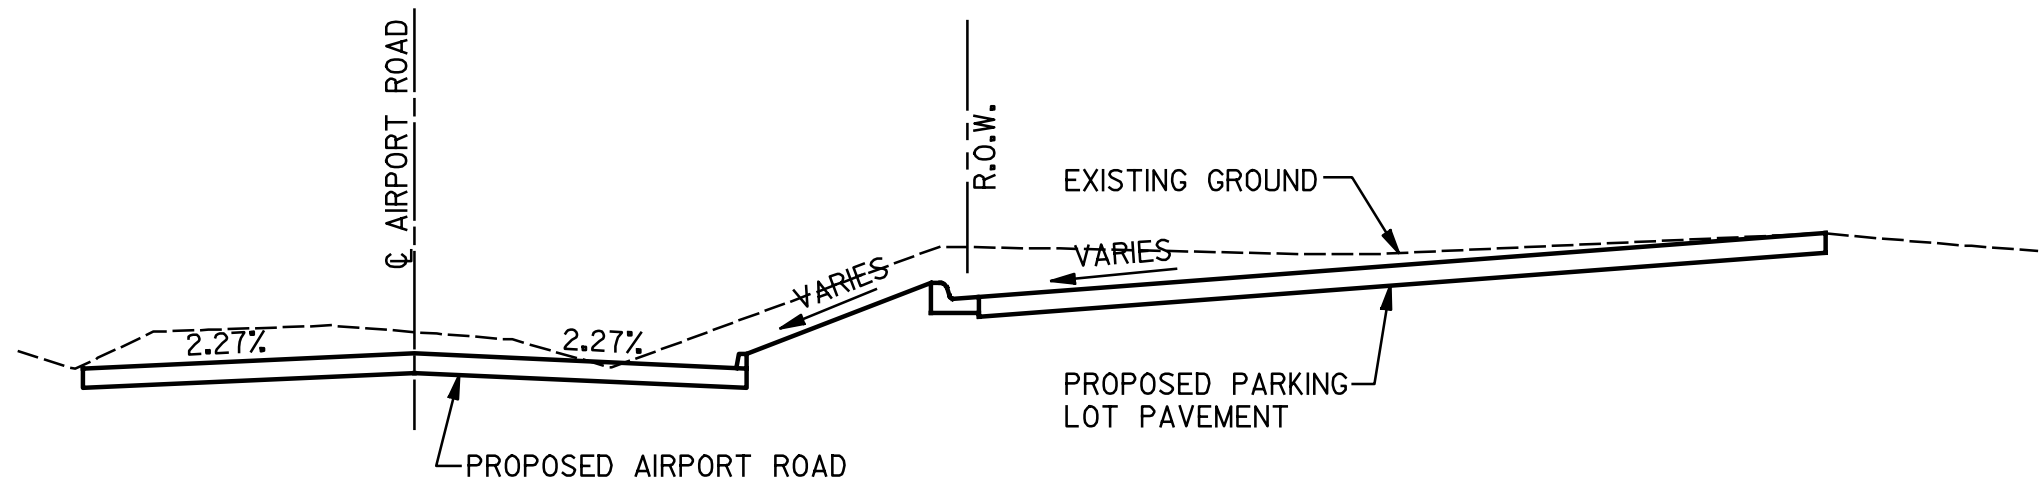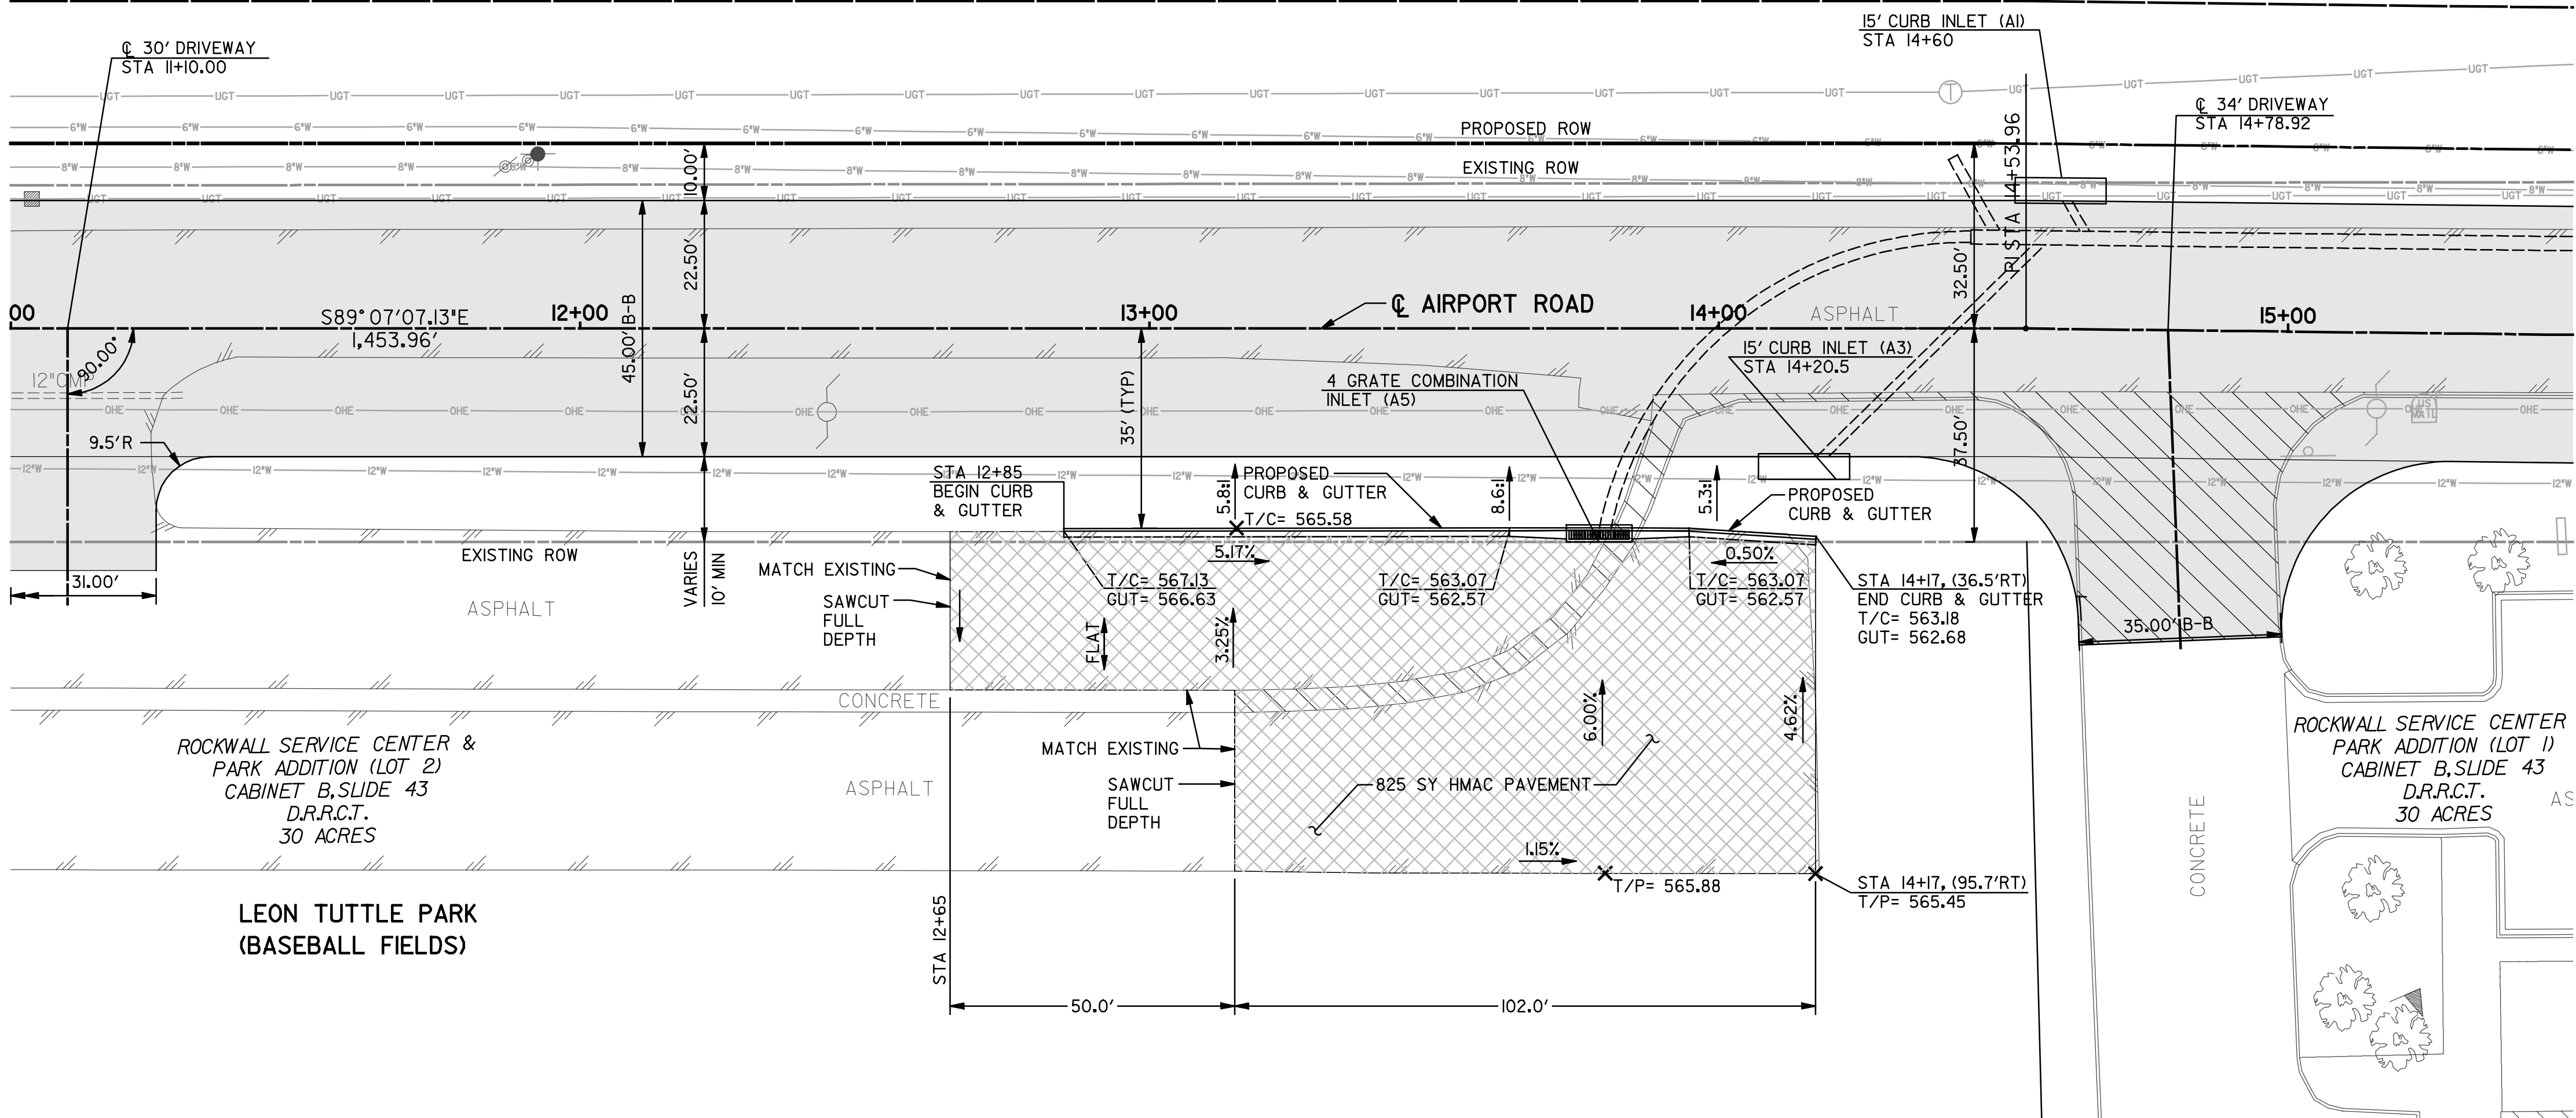

TYPICAL PARKING LOT SECTION
NTS

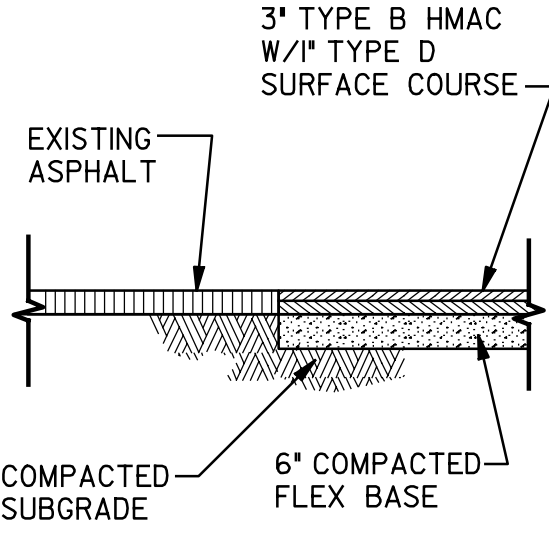

PAVEMENT SECTION
NTS

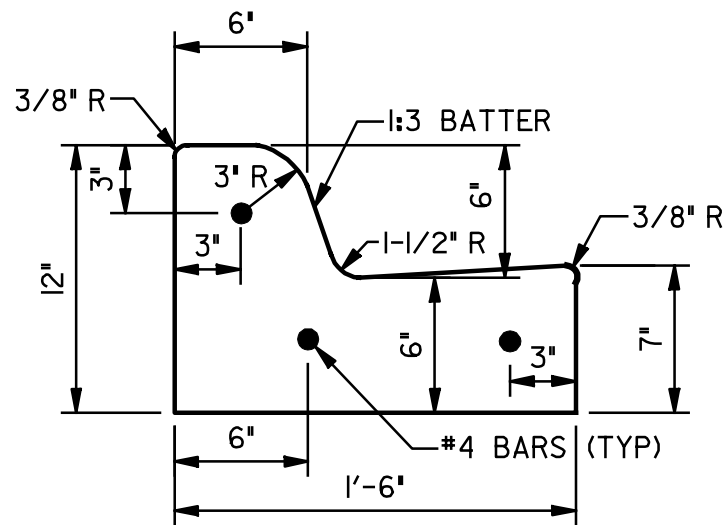

PROPOSED CURB & GUTTER
NTS

RECORD DRAWING

This drawing is a compilation of the original sealed engineering drawing and modifications by addenda, change orders and information furnished by the contractor. Information shown that was provided by the contractor and others not associated with the design engineer cannot be verified for accuracy or completeness. Original sealed drawing is on file at the office of AECOM Technical Services, Inc., TBPE REG. NO. F-3580

ORIGINAL DRAWING
SEALED & SIGNED BY
T.H. Gaertner, P.E.
TX NO. 37124