



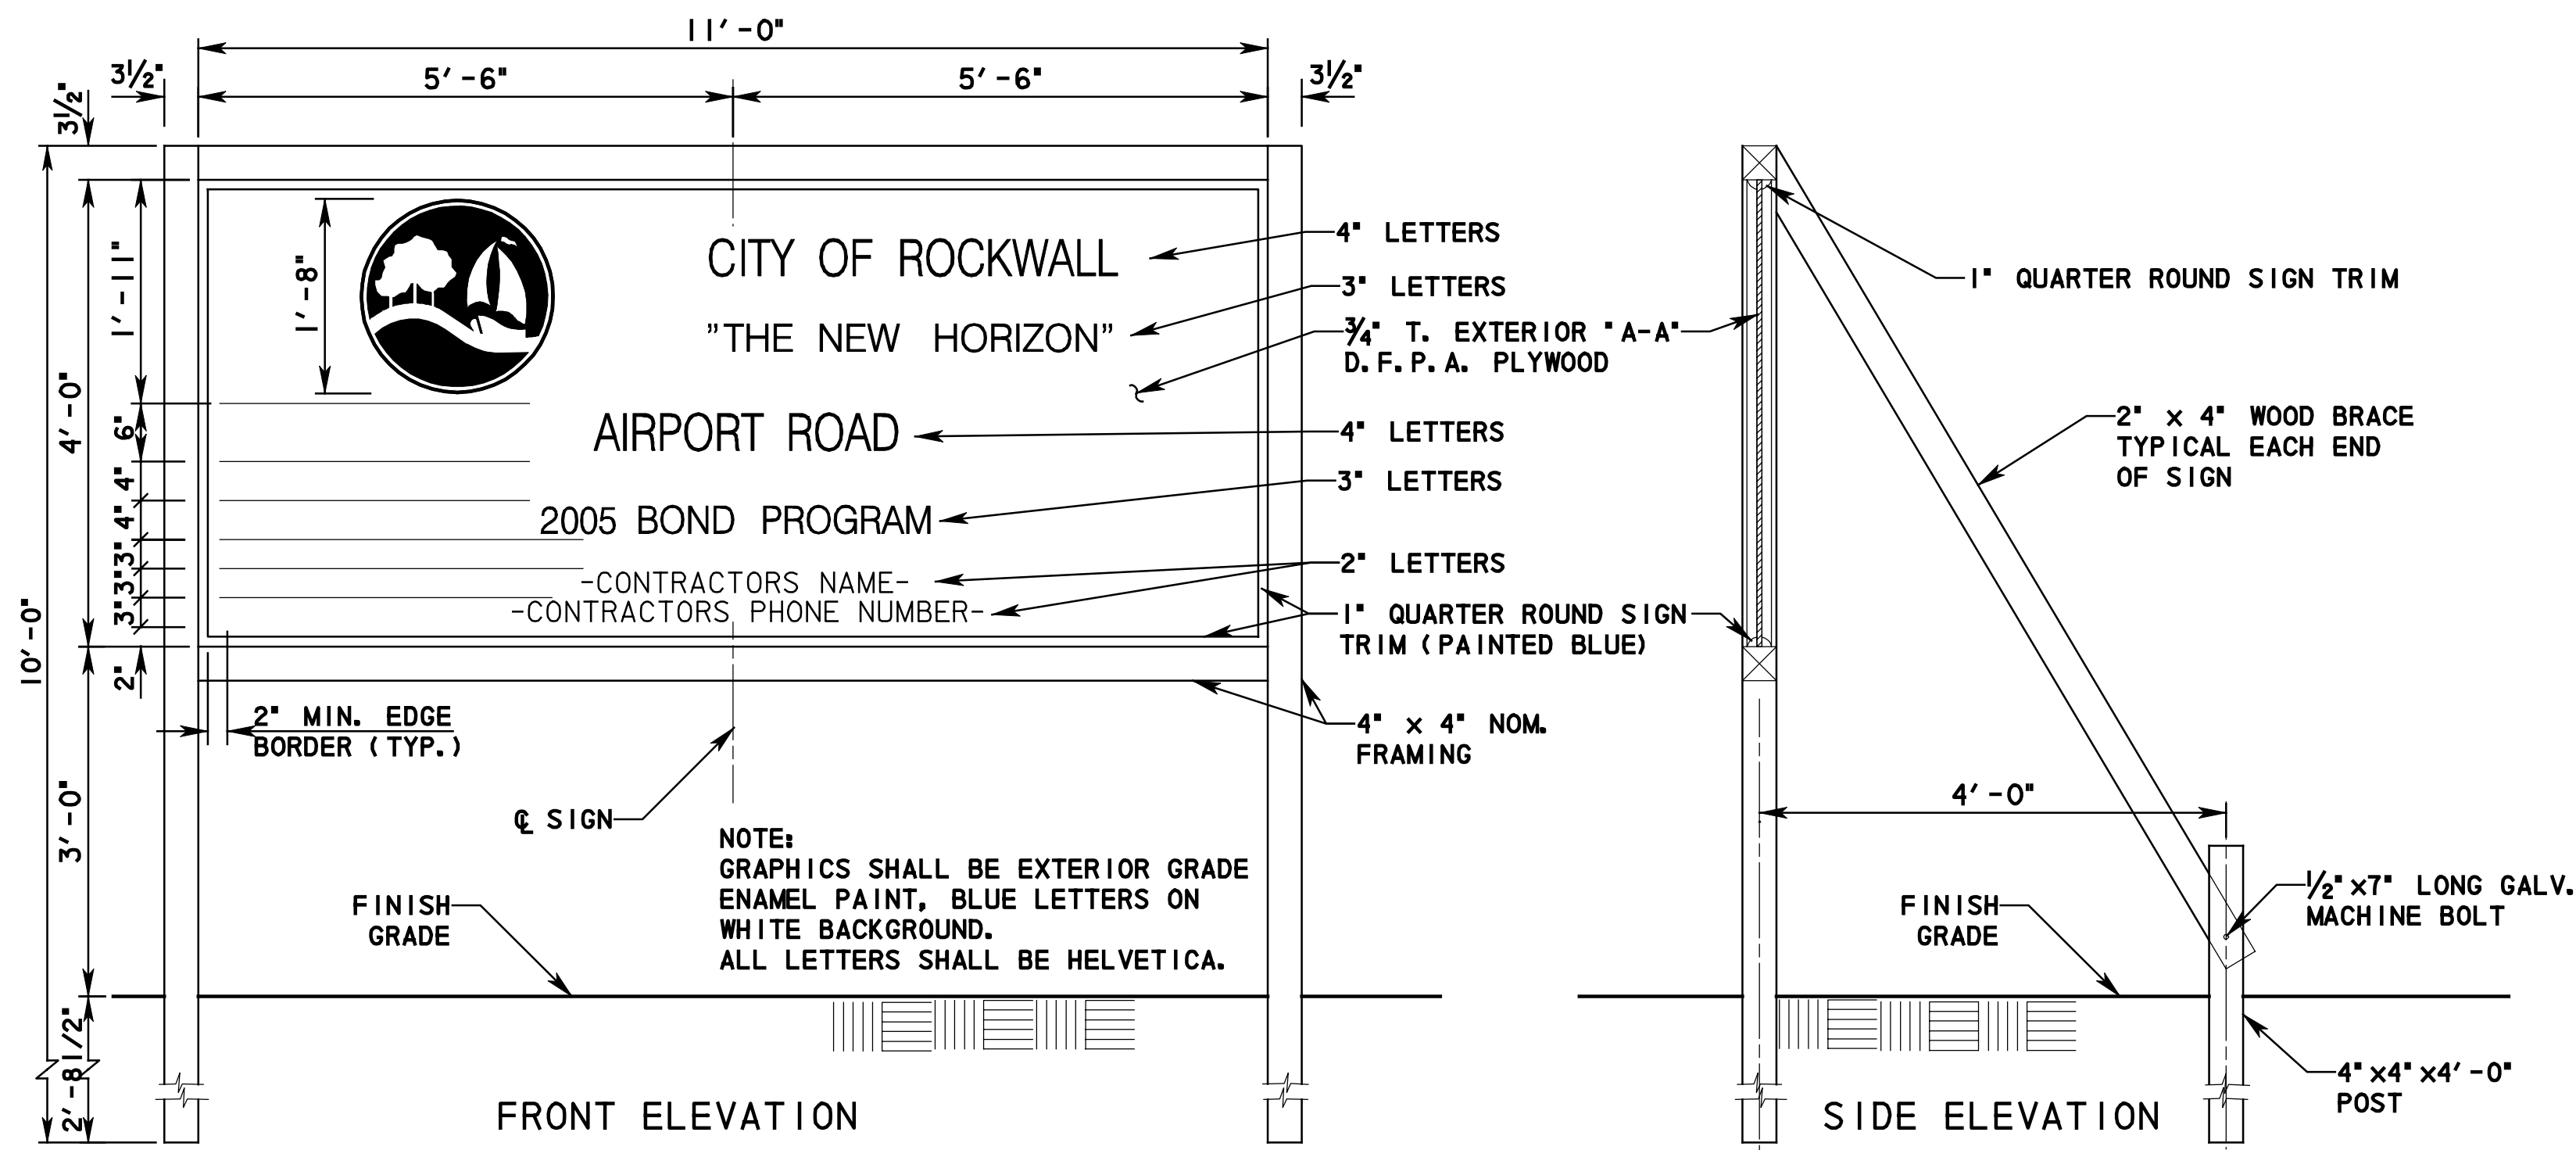

PROJECT SIGN DETAILS
N. T. S.

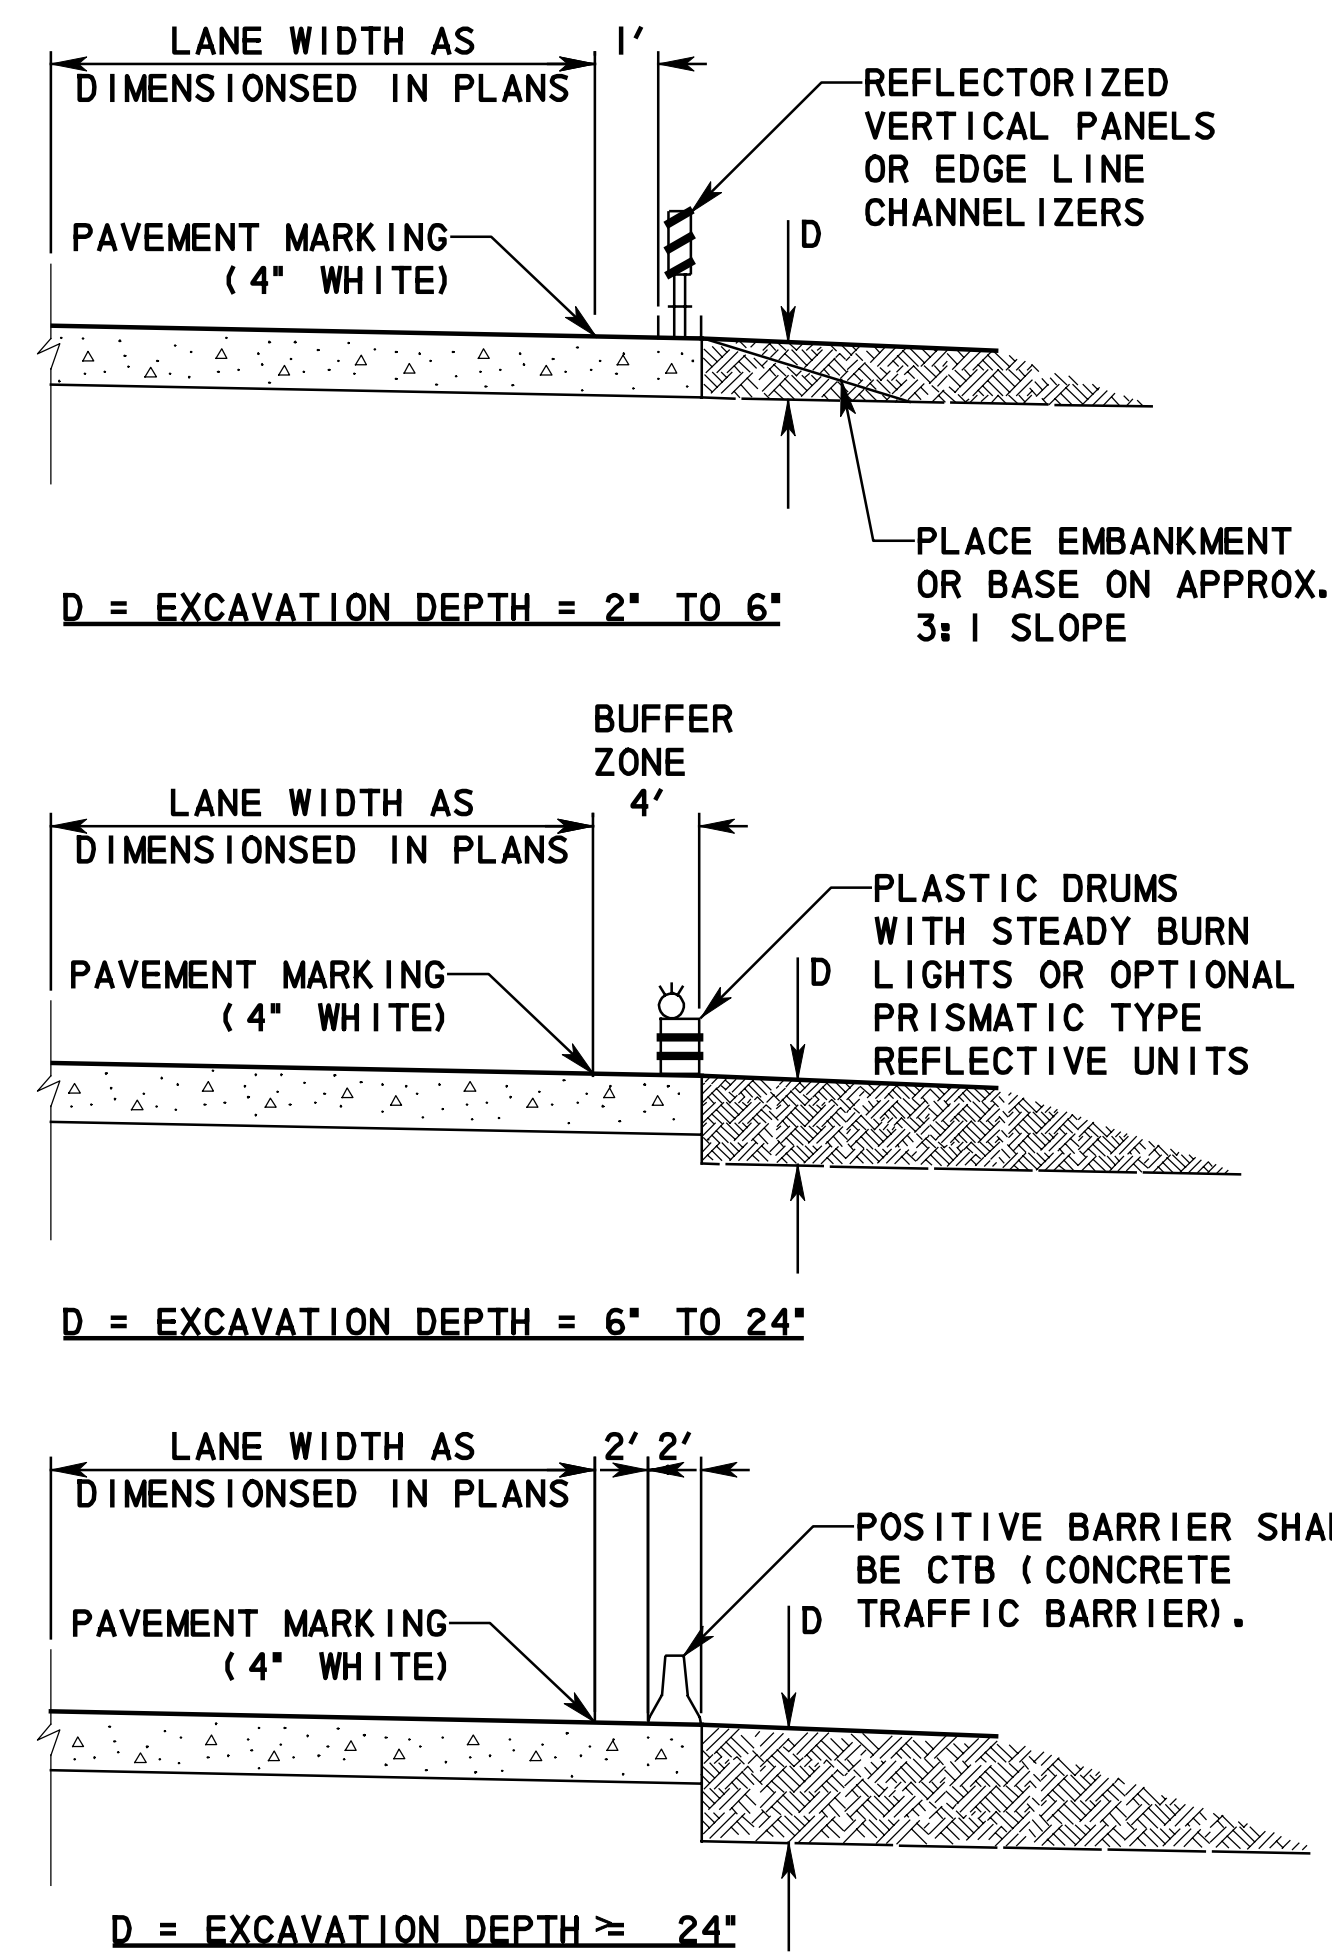

TREATMENT FOR PAVEMENT DROP-OFFS
NOTE: TREATMENTS SHOWN ARE MINIMUM. ACTUAL TREATMENT SHALL BE AS DESIGNATED BY THE ENGINEER.



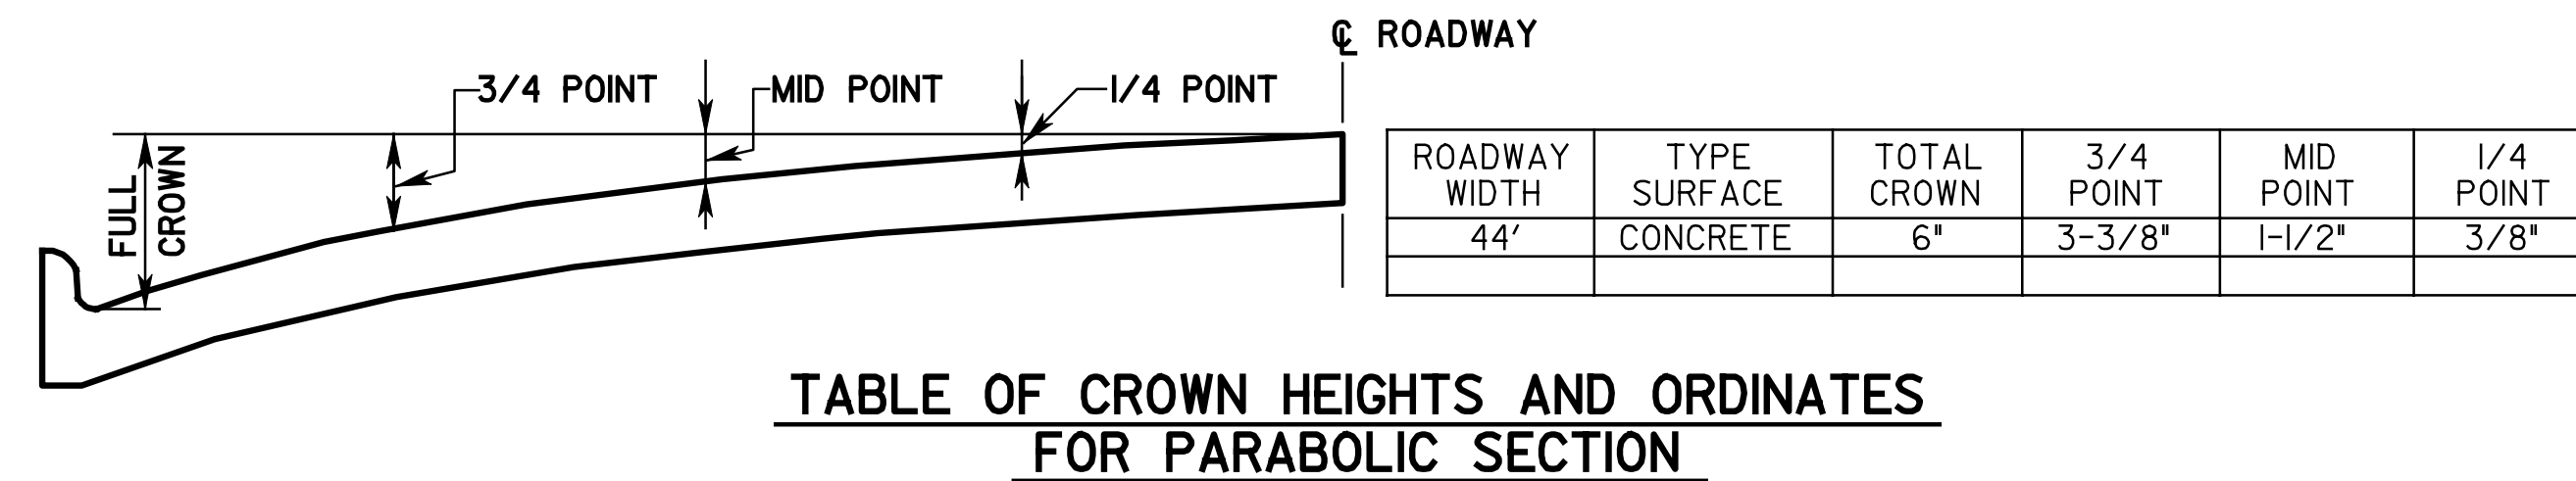




TABLE OF CROWN HEIGHTS AND ORDINATES
FOR PARABOLIC SECTION

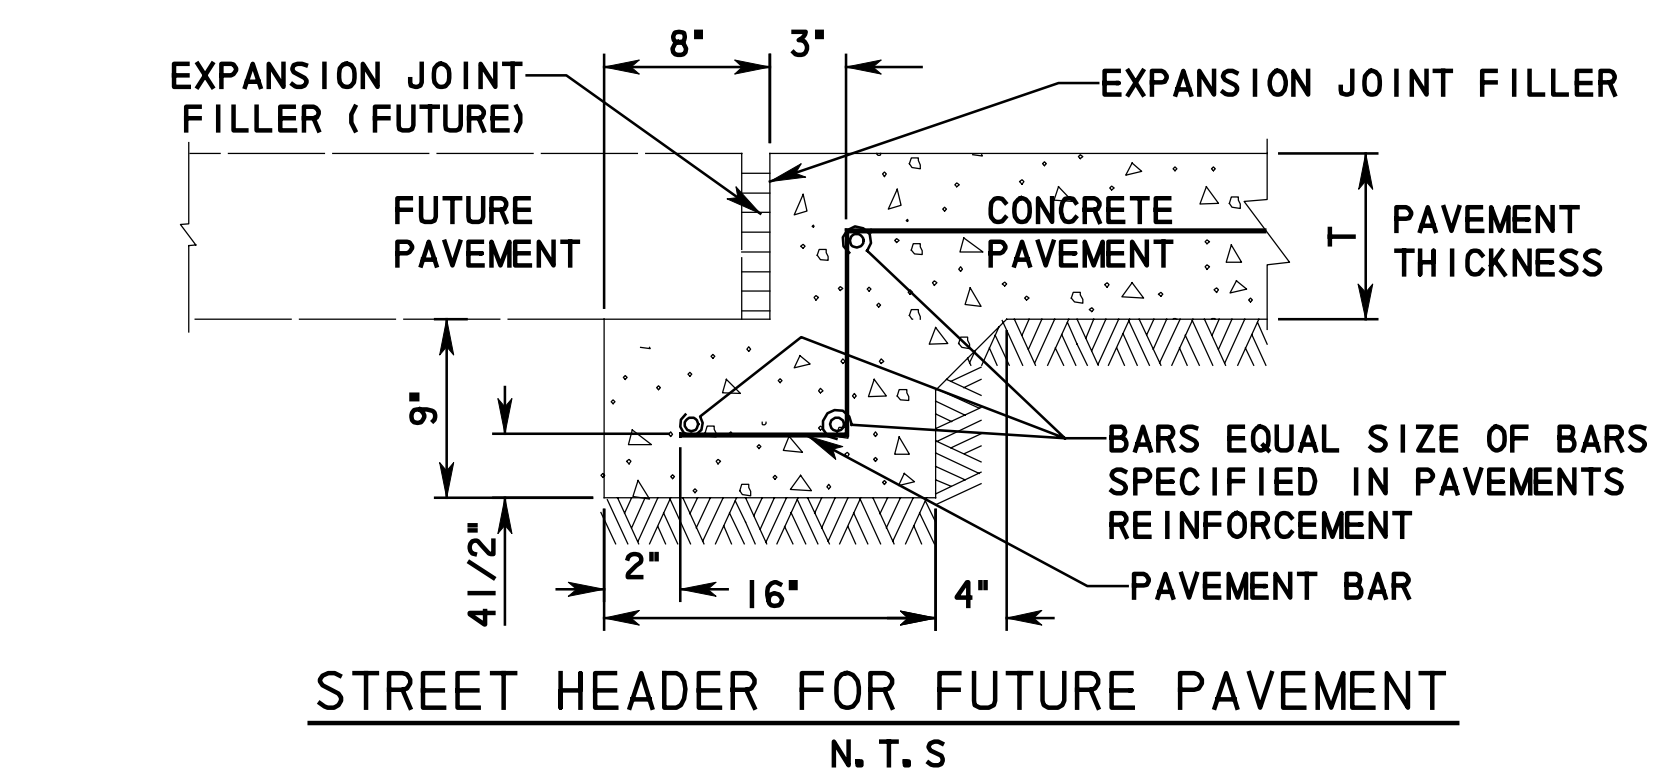


STREET HEADER FOR FUTURE PAVEMENT
N. T. S.

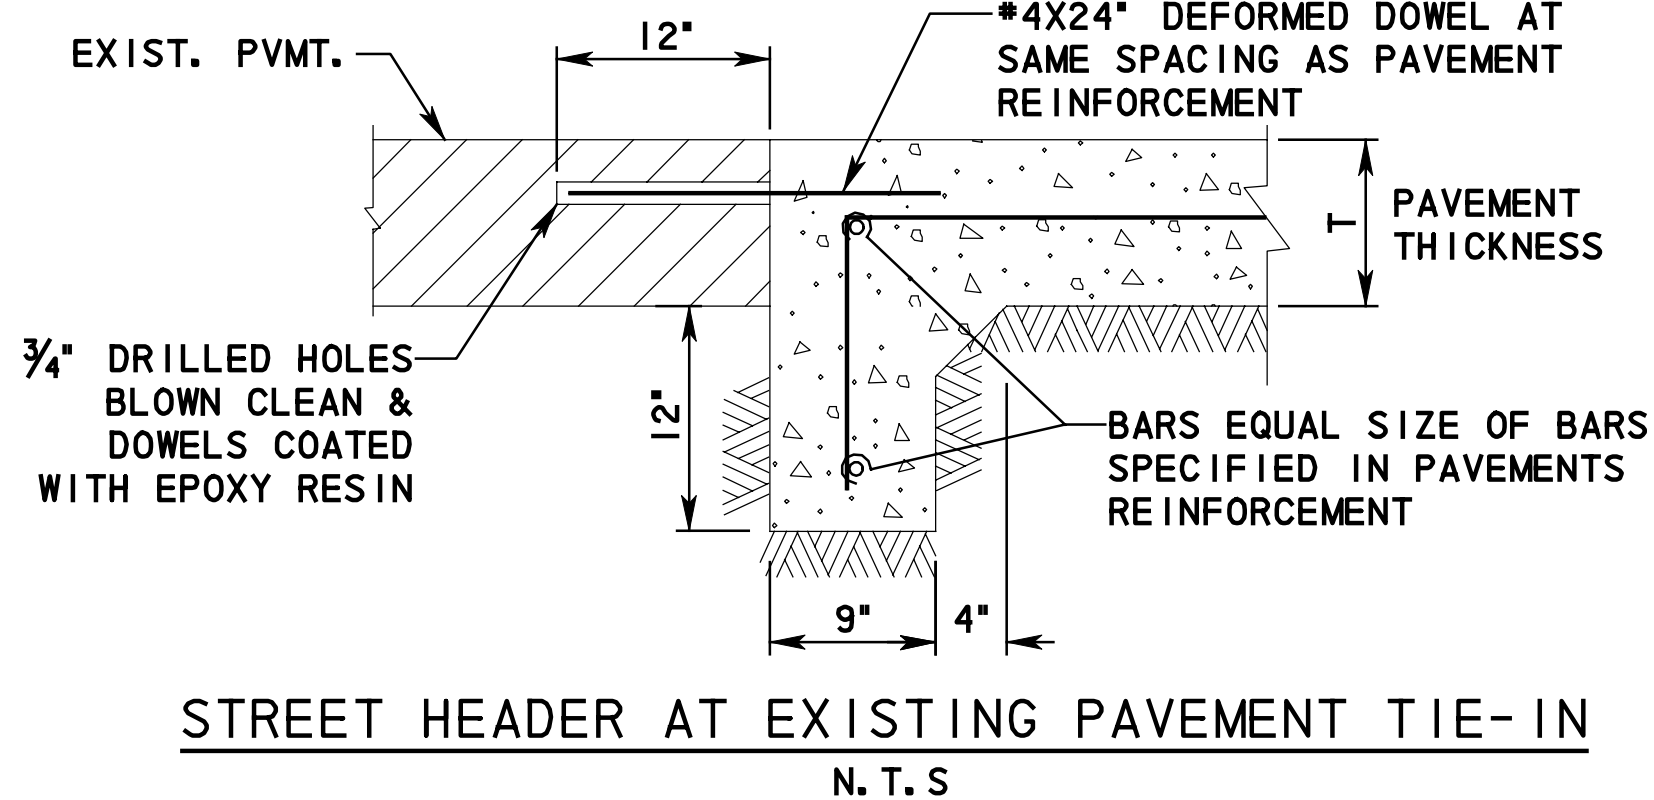


STREET HEADER AT EXISTING PAVEMENT TIE-IN
N. T. S.

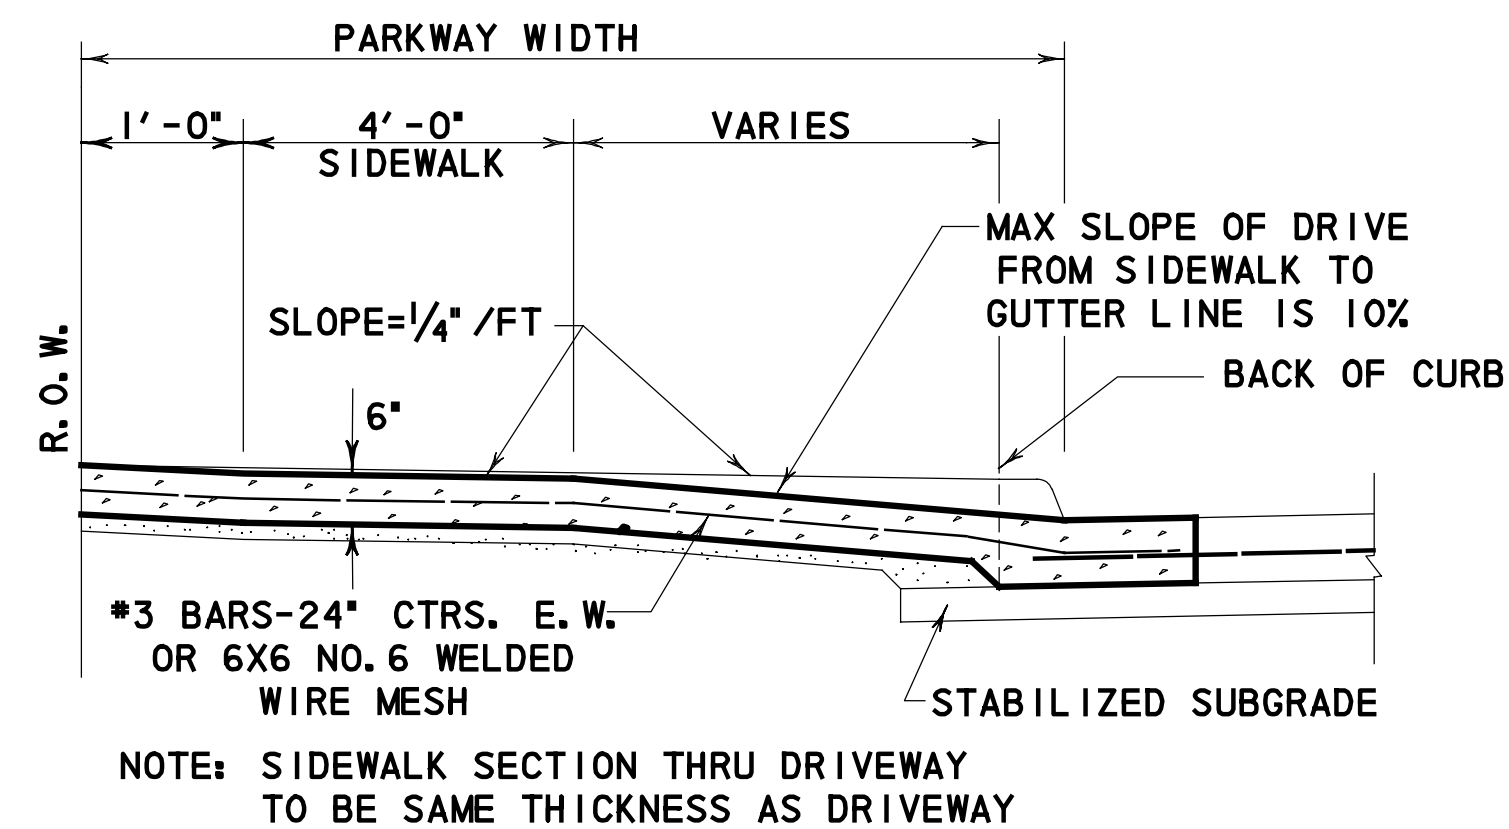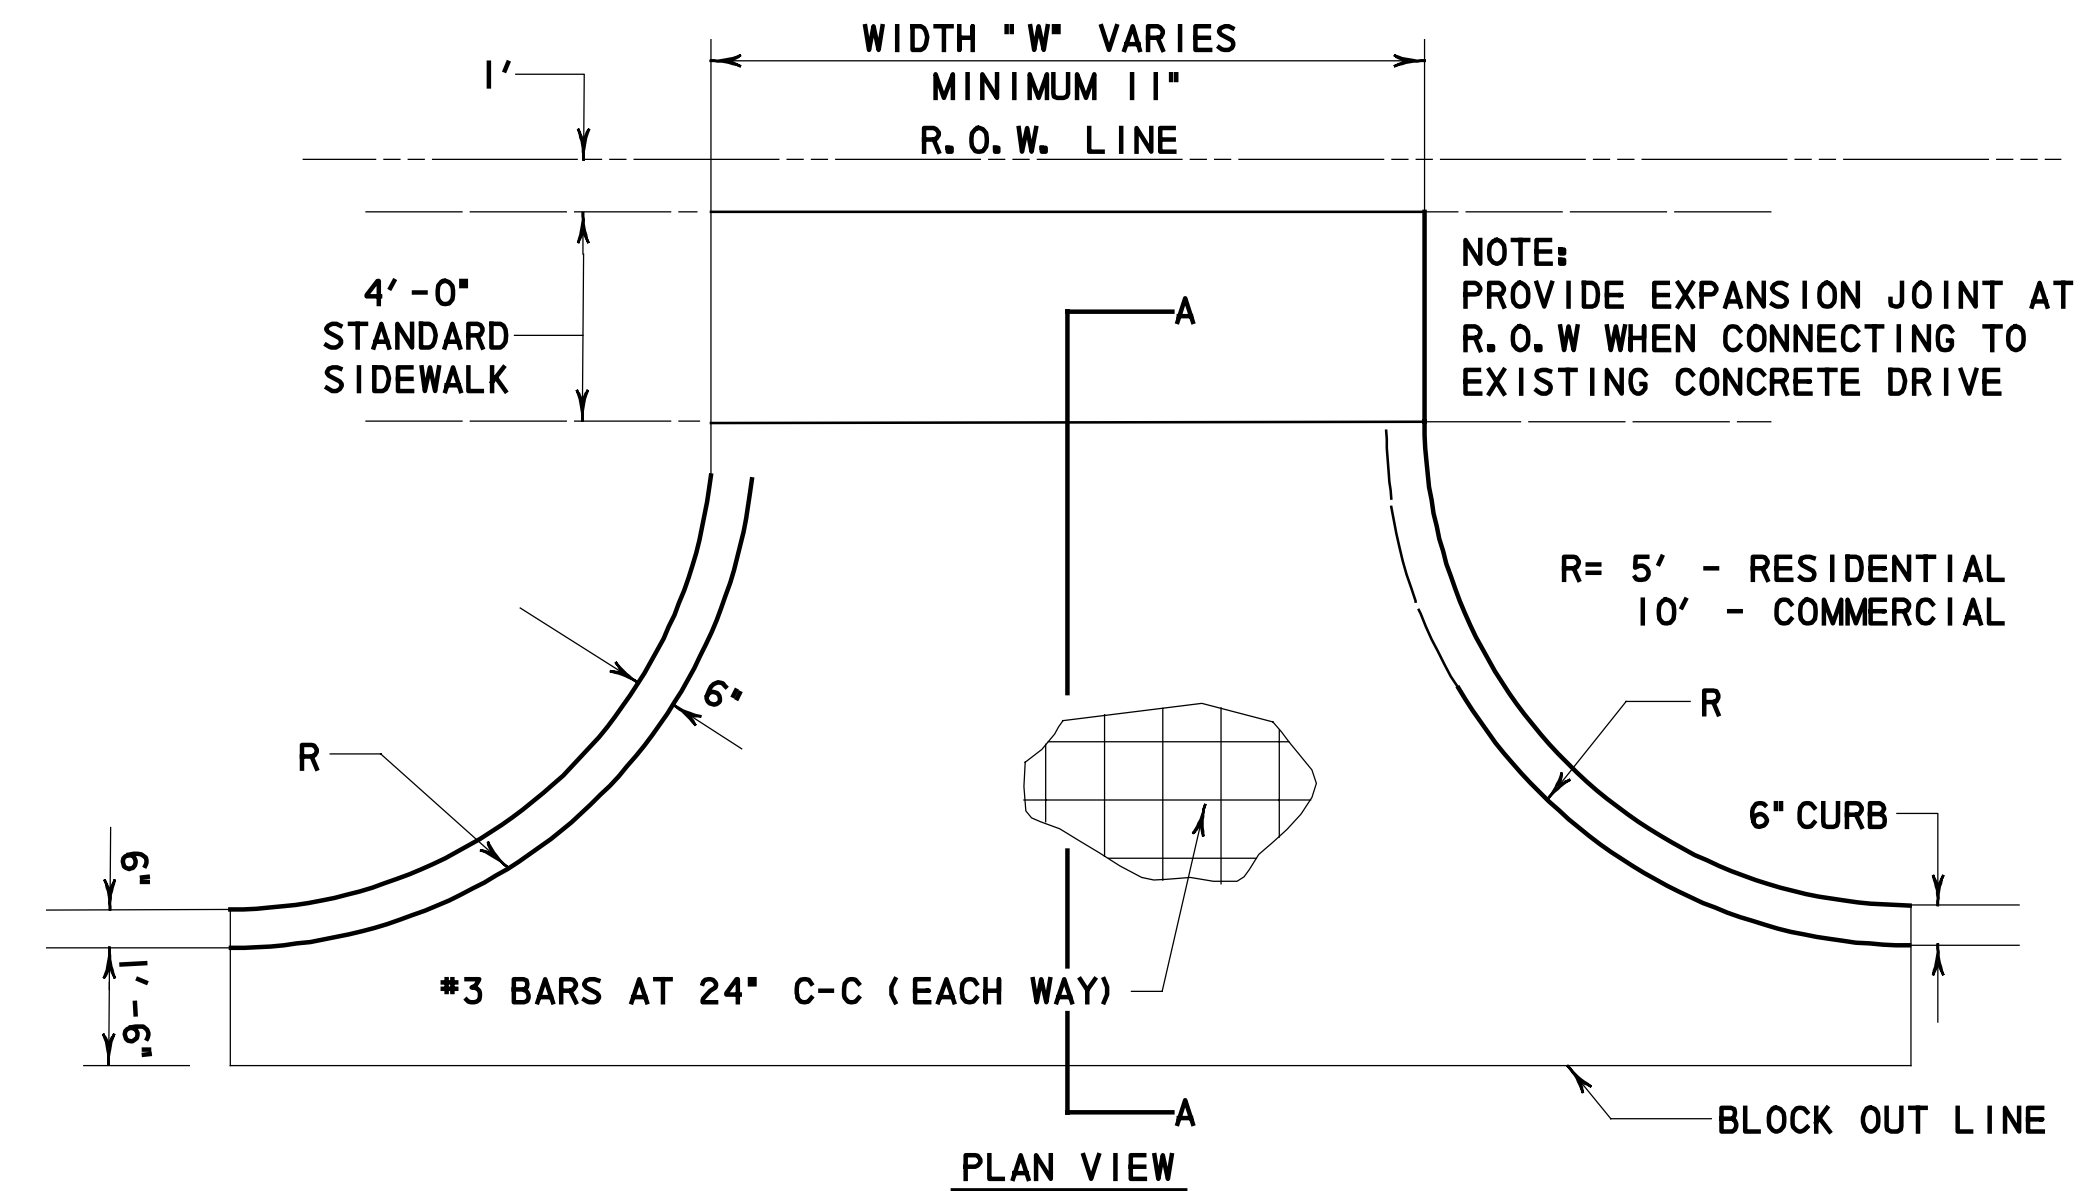


SECTION A-A
DRIVEWAY DETAIL
N.T.S.

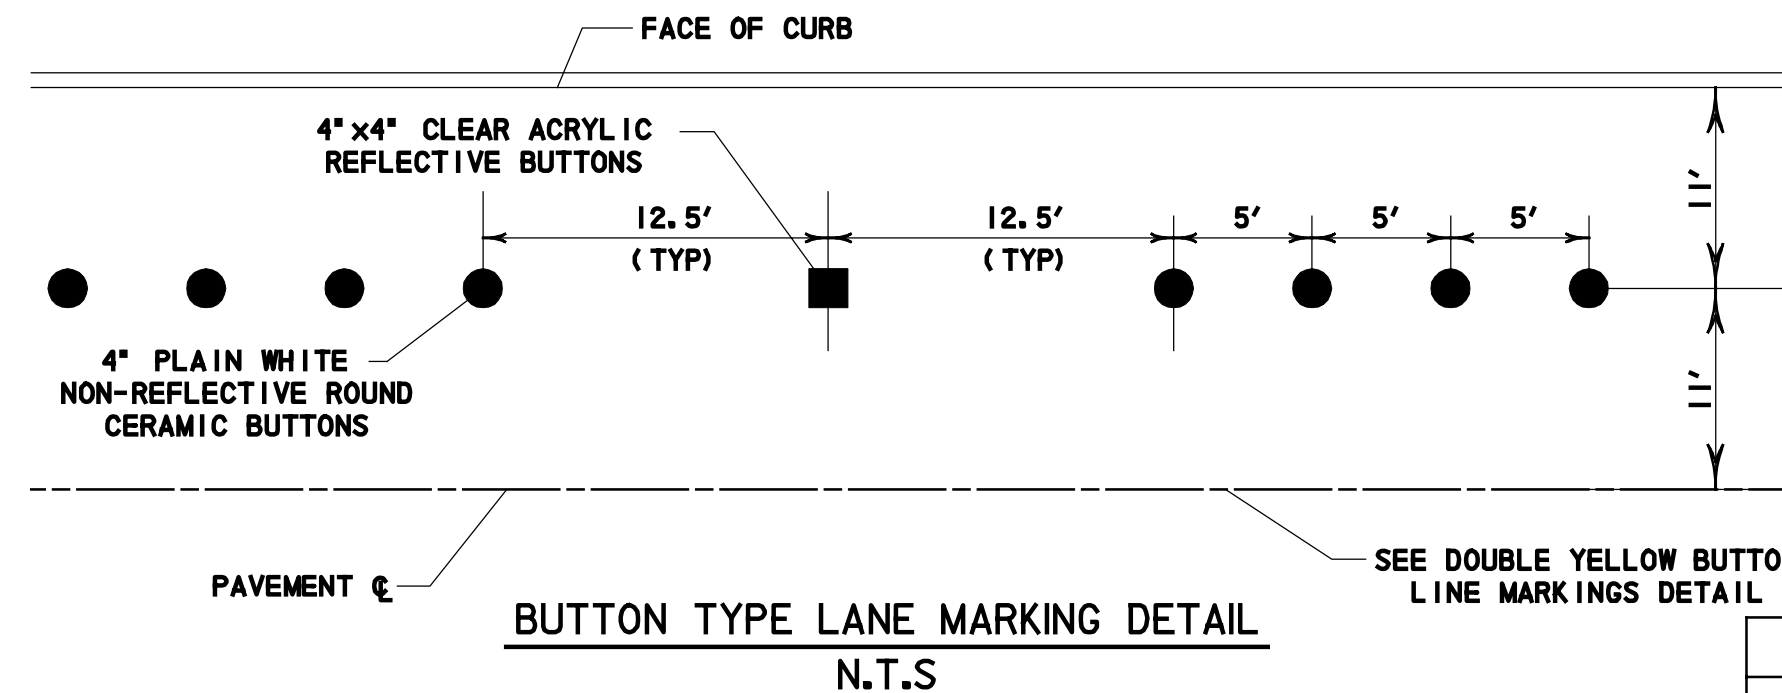

BUTTON TYPE LANE MARKING DETAIL
N.T.S.

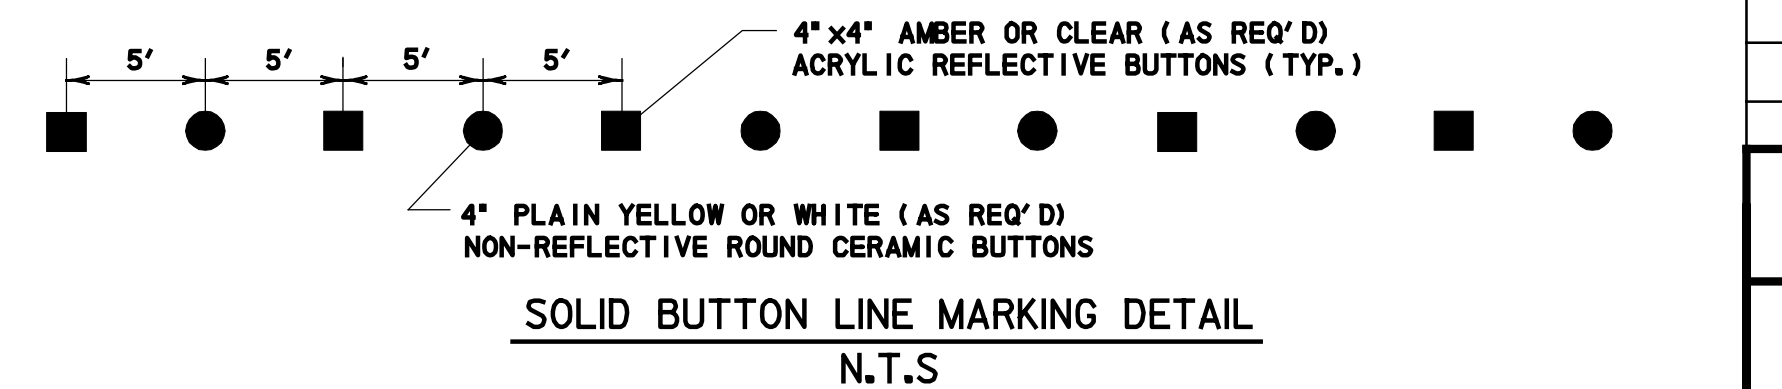

SOLID BUTTON LINE MARKING DETAIL
N.T.S.

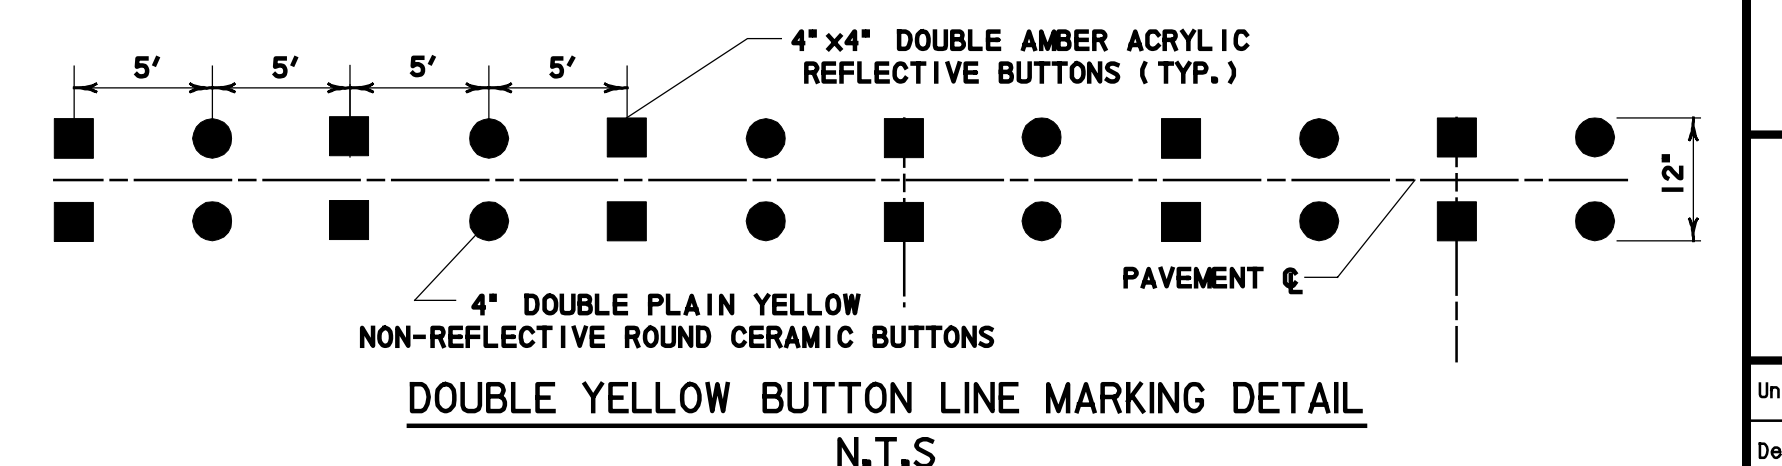

DOUBLE YELLOW BUTTON LINE MARKING DETAIL
N.T.S.

RECORD DRAWING
This drawing is a compilation of the original sealed engineering drawing and modifications by addenda, change orders and information furnished by the contractor. Information shown that was provided by the contractor and others not associated with the design engineer cannot be verified for accuracy or completeness. Original sealed drawing is on file at the office of AECOM Technical Services, Inc., TBPE REG. NO. F-3580

ORIGINAL DRAWING SEALED & SIGNED BY
T.H. Gaertner, P.E.
TX NO. 37124

AIRPORT ROAD			
MISCELLANEOUS ROADWAY DETAILS			
City of Rockwall, Texas			
AECOM			
Unit	PW-DAL	Scales	Horz AS SHOWN Vert AS SHOWN
Designed	THG	Checked	THG
Drawn	FG	Approved	THG
Date	8/2/2012	Project No.	60004153
Sheet	17	of	26