
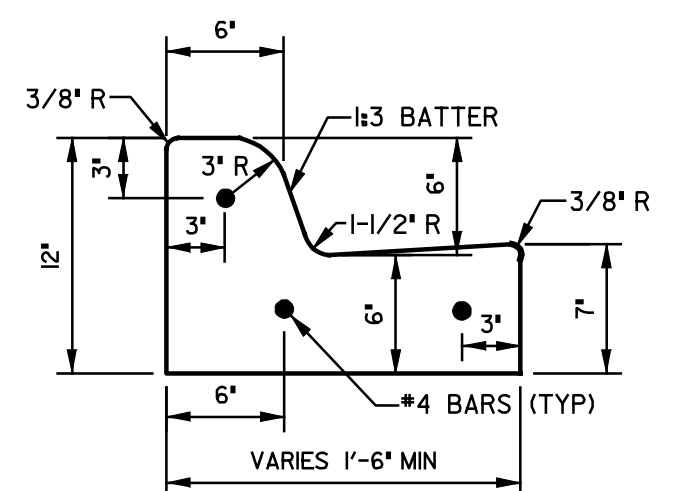
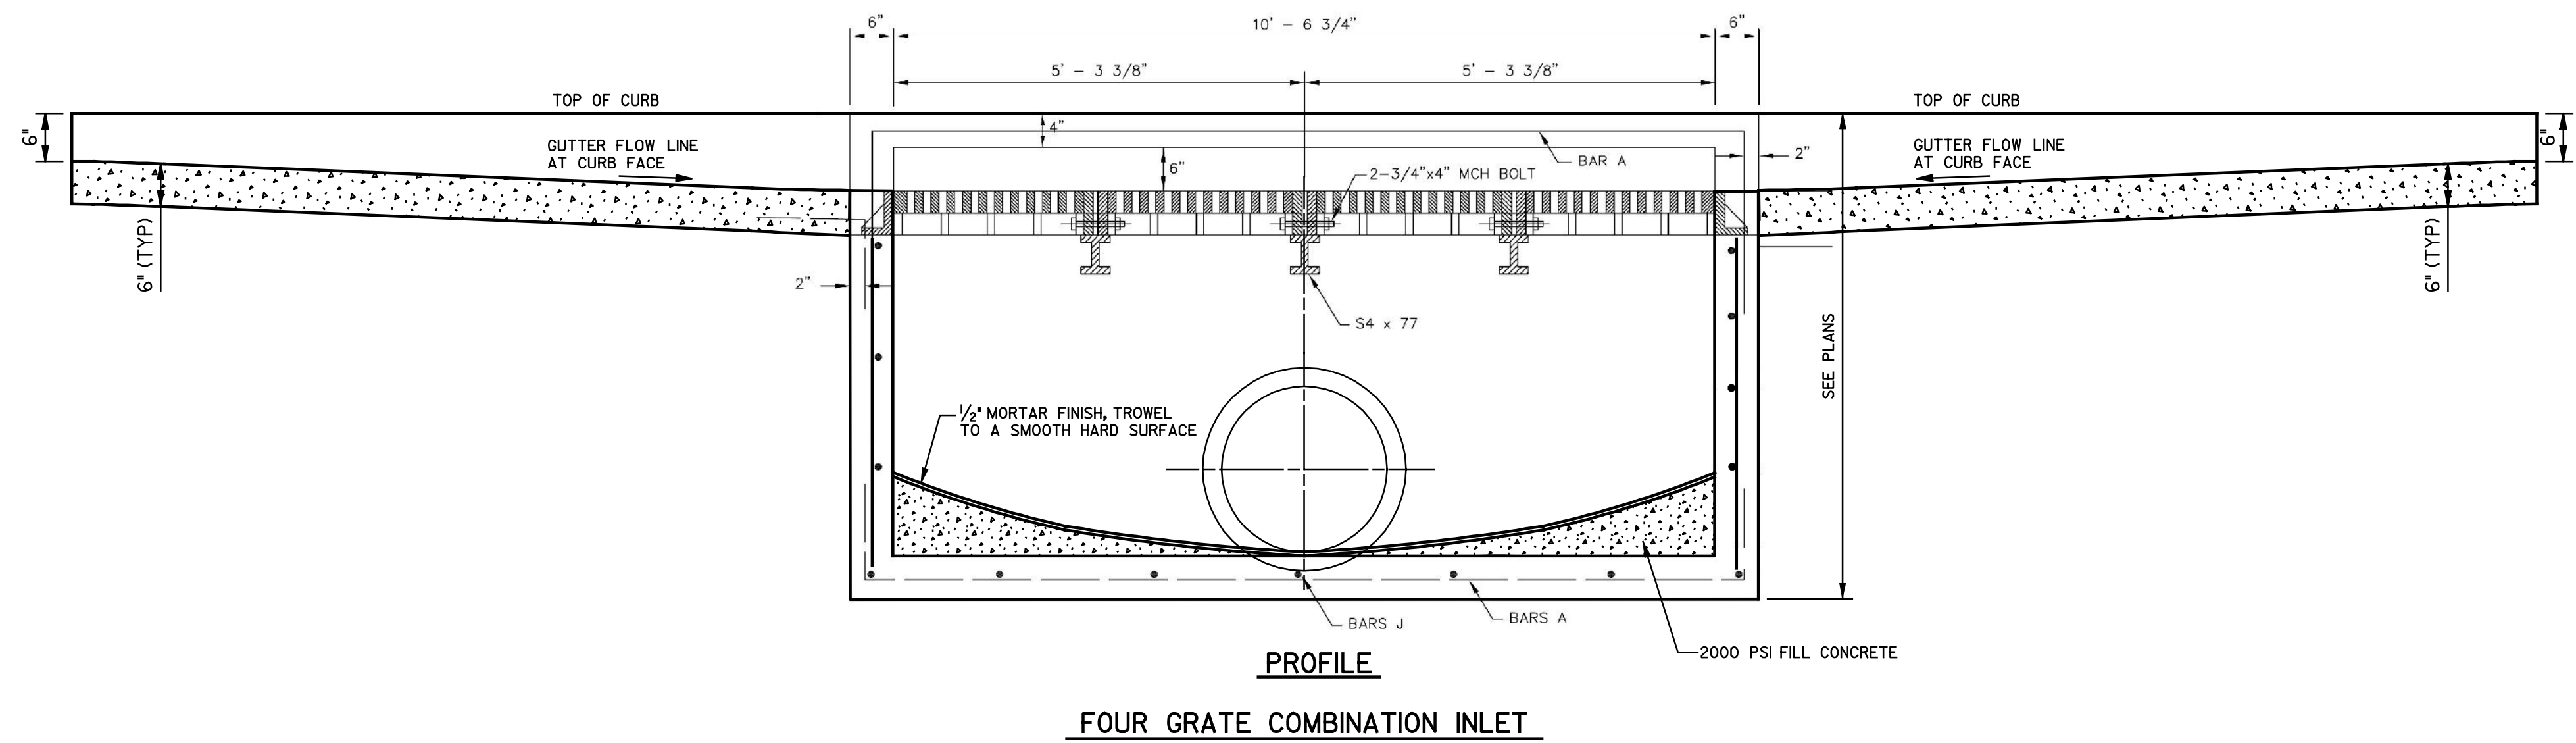


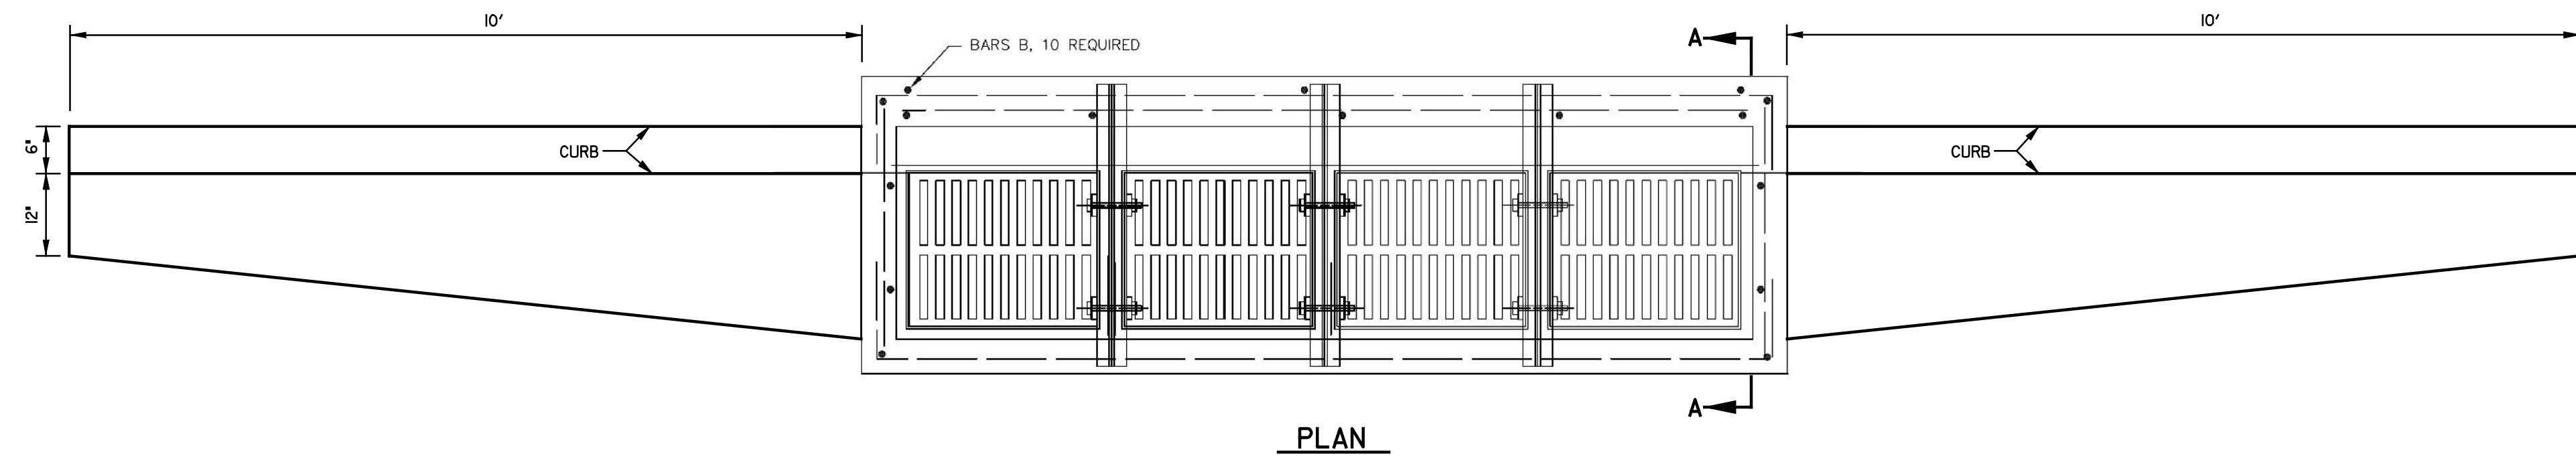

PROPOSED CURB & GUTTER

NTS

RECORD DRAWING

This drawing is a compilation of the original sealed engineering drawing and modifications by addenda, change orders and information furnished by the contractor. Information shown that was provided by the contractor and others not associated with the design engineer cannot be verified for accuracy or completeness. Original sealed drawing is on file at the office of AECOM Technical Services, Inc.,
TBPE REG. NO. F-3580

ORIGINAL DRAWING

T.H. Gaertner, P.E.

T.H. Gaertner, P.E.

TX NO. 37124

NO.	REVISION	BY	DATE




AIRPORT ROAD

FOUR GRATE COMBINATION INLET

**AECOM**

AECOM TECHNICAL SERVICES, INC.
16000 DALLAS PARKWAY, SUITE 350
DALLAS TEXAS 75248
WWW.AECOM.COM
TBPE REG. NO. F-3580

Unit	PW-DAL	Scale:	Horz Vert	AS AS	SHOWN SHOWN	Date	8/2/2012
Designed	THG	Checked		THG		Project No.	60004153
Drawn	FG	Approved		THG		Sheet	22 of 26

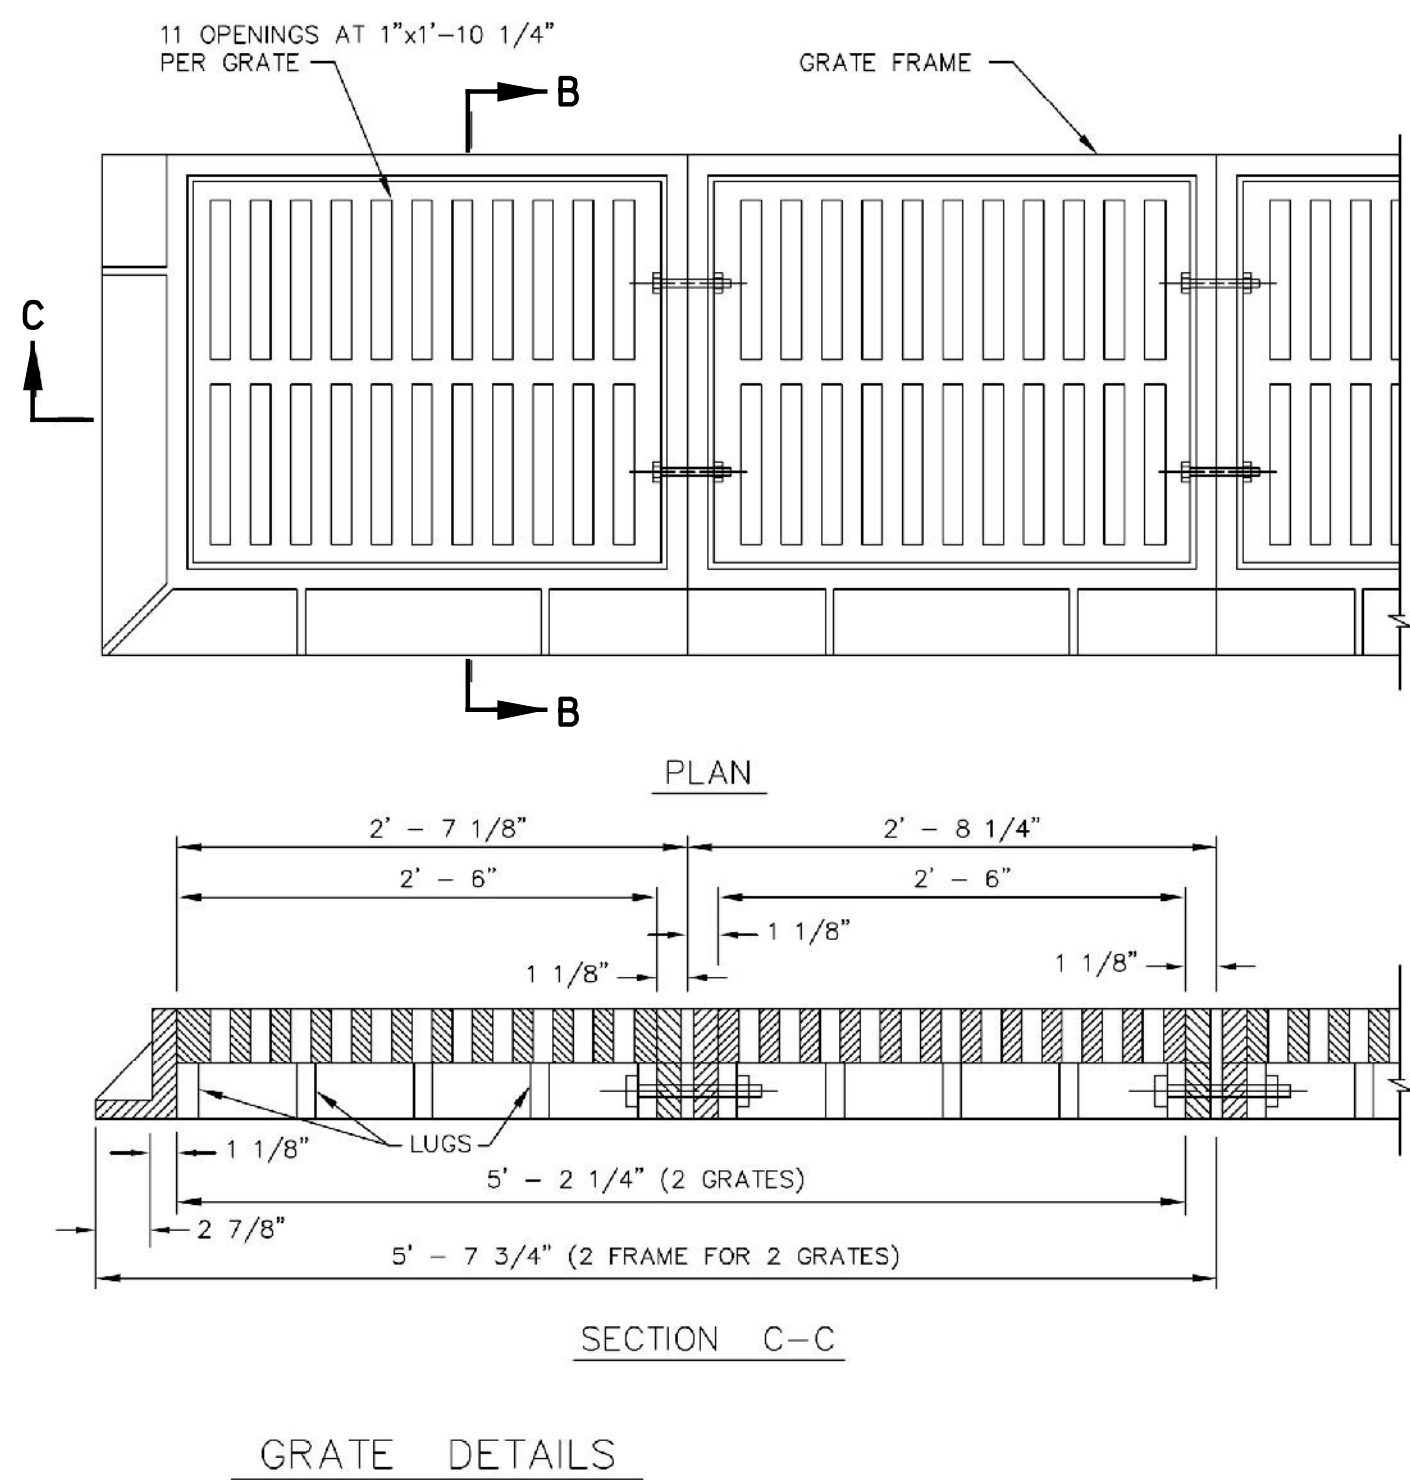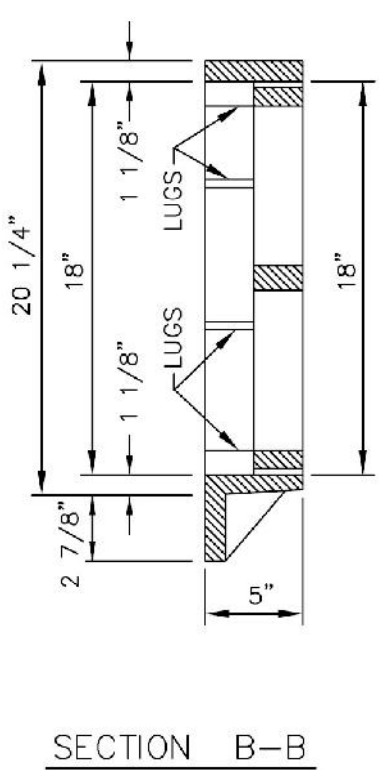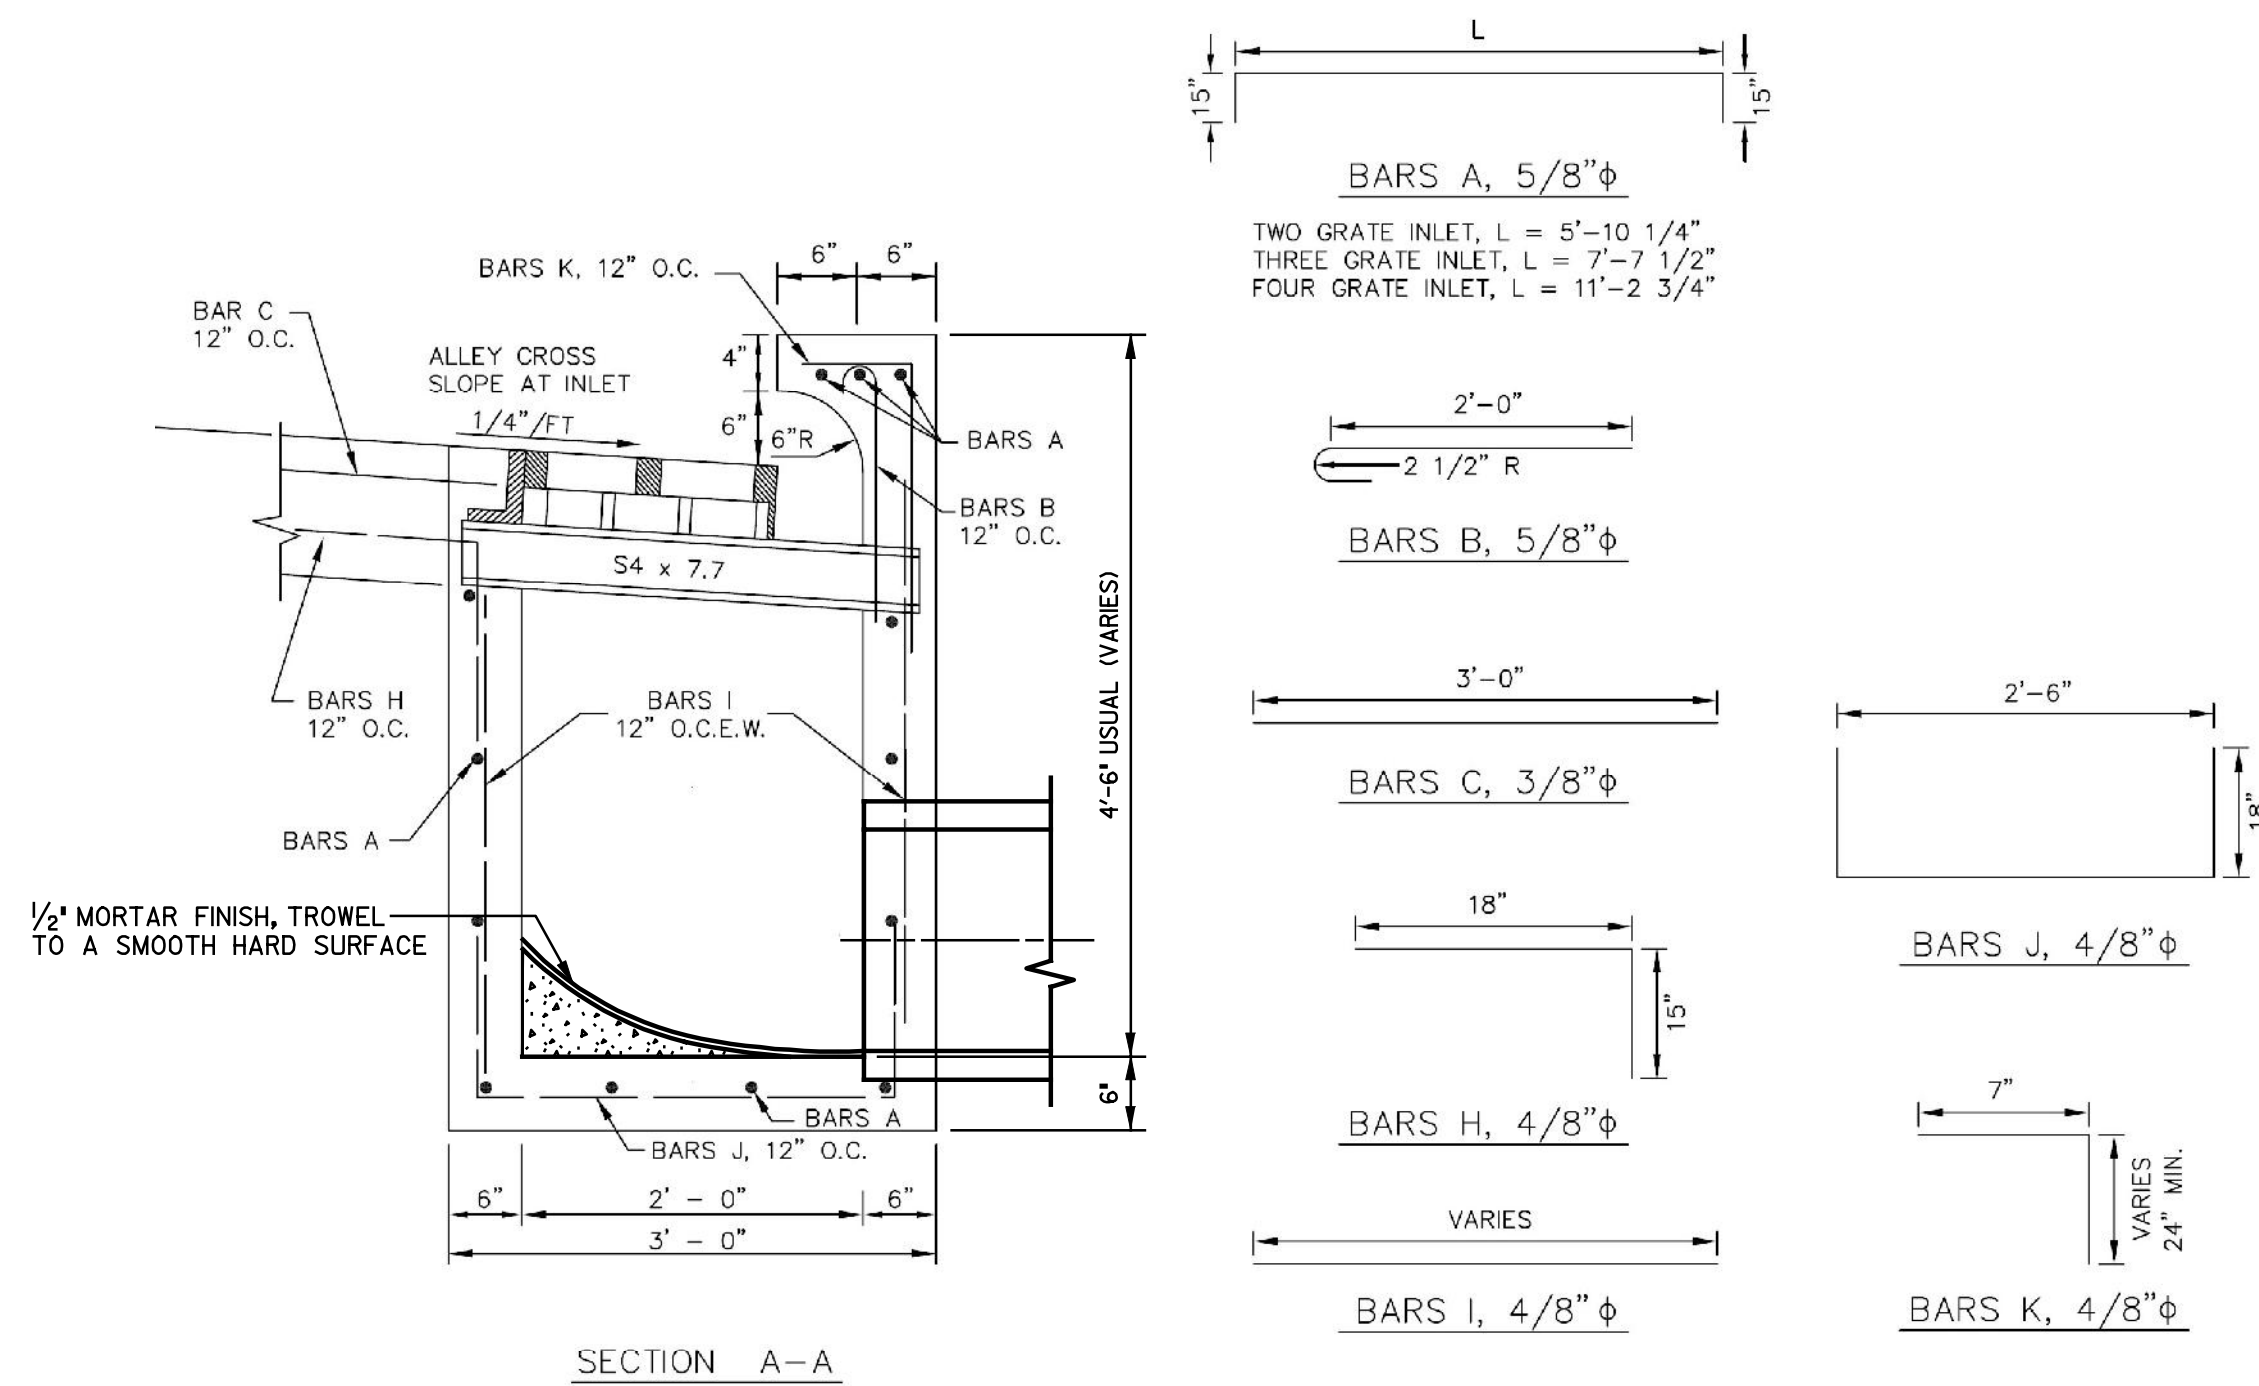

\\usda1\fp002\PW4328\Airport_Road\CADD\Sheet\Airport_Road_Record_Drawings_8-3-10\22-4 GRATE_Details.dgn
8/7/2012