



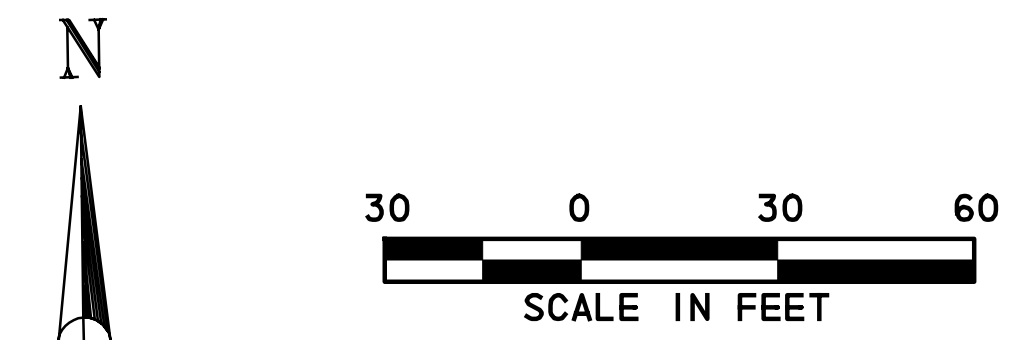

- NOTE:
- SEE MISCELLANEOUS ROADWAY DETAILS SHEET
FOR PAVEMENT MARKING DETAILS.

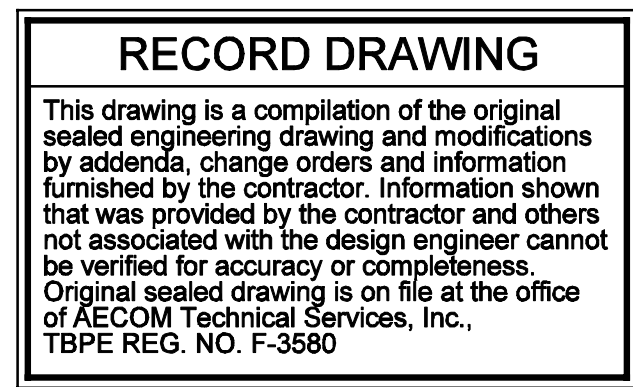

NO.	REVISION	BY	DATE

PAVEMENT MARKINGS & SIGNING

STA. 0+00 TO STA. 13+00

**AECOM**

Unit	PW-DAL	Scale:	Horz: AS SHOWN Vert: AS SHOWN	Date	8/2/2012
Designed	THG	Checked	THG	Project No.	60004153
Drawn	FG	Approved	THG	Sheet	23 of 26