


This Record Drawing is a combination of the project, modified by information furnished by the contractor reflecting changes in the field. The Engineer is not responsible for any errors or omissions in the field drawings are on file at the offices of FREESE AND NICHOLS, INC. 4055 INTERNATIONAL PLAZA, SUITE 200 DALLAS, TEXAS 75244 (817) 735-7300 RECORD DRAWINGS PREPARED ON: 3/23/2013

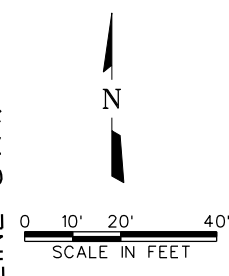

CURVE DATA
 R=700.00
 L=18.13
 TAN=9.06
 Δ=1° 29' 02.89"

NOTE:
 SEE SHEETS WT-1 THROUGH WT-6 FOR WATERLINE DETAILS AND REMOVALS.

FREESE AND NICHOLS
 1701 N. Market Street, Suite 500, LB 51
 Dallas, TX 75201-2900
 Phone - (214) 217-2200
 Fax - (214) 217-2201
 Web - www.freese.com

AIRPORT ROAD RECONSTRUCTION
 PAVING PLAN AND PROFILE
 STA 6+00 TO STA 11+00

NO. ISSUE	BY	DATE	DESCRIPTION
1	DPH	01/21/2013	DESIGNED
2	KRJ	02/23/2011	DRAWN
3	KRJ	02/23/2011	CHECKED

FILE NAME: cv-trt-pp-road02.sht

MicroStation V8 User: 02069\Office: Dallas
 ROK08461 N:\V\Drawings\CV-TRT-PP-ROAD02.sht
 Plot Scale: 40.0000 N:\V\Market\Drawings\CV-TRT-PP-ROAD02.dwg
 Date: Jan 29, 2013 08:12:19 AM Project: Freese and Nichols, Inc.\trt-pp-road02.dwg

