


REVISD: 12/17/12 - Kevin Anderson
H:\Projects\Rockwall\4055-21B Airport Road Lift Station Improv\Sheets\4055-21B-01 COVER.dwg
PLOT SCALE: 1:2
PLOT STYLE: 11x17.ctb PLOTTED BY: Kevin Anderson ON 12/17/2012

CITY OF ROCKWALL, TEXAS

CONSTRUCTION PLANS FOR

AIRPORT ROAD LIFT STATION IMPROVEMENTS

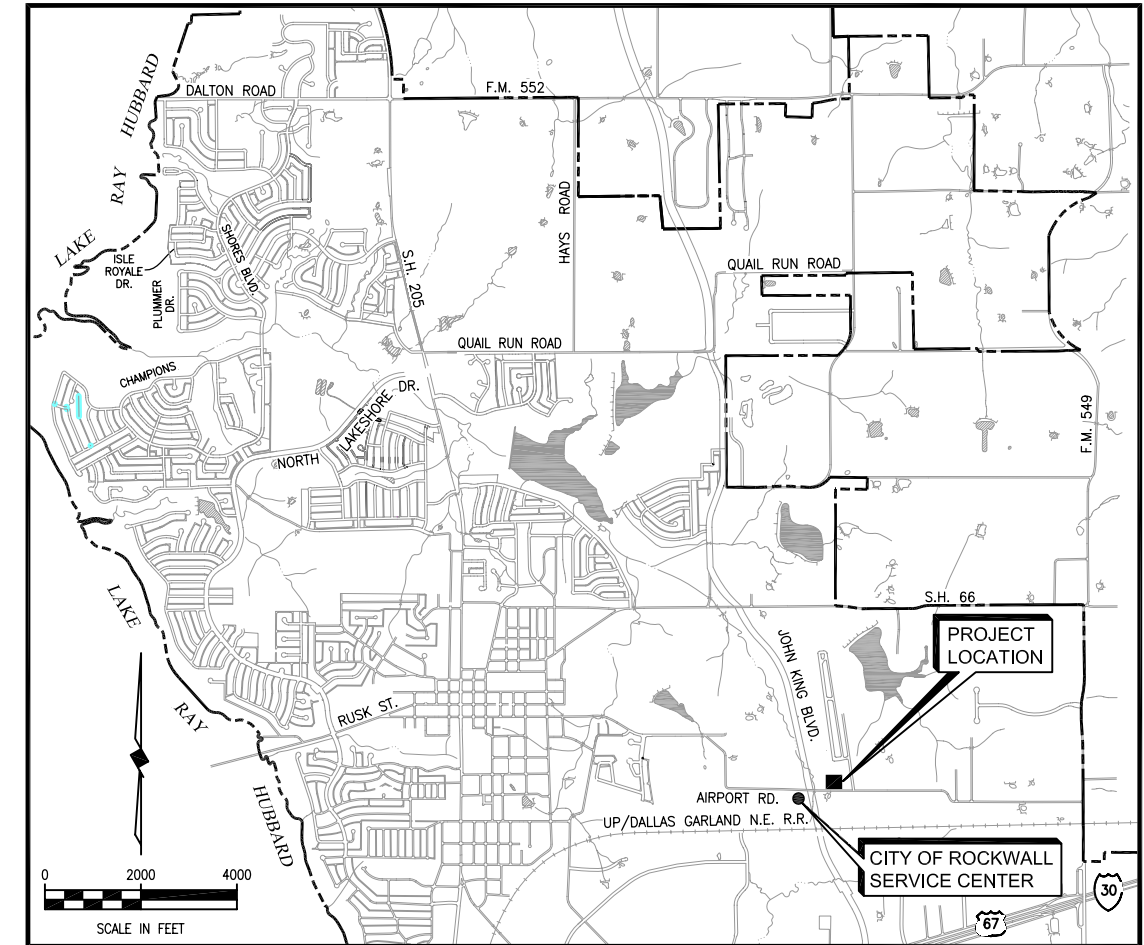

LOCATION MAP

COUNCIL MEMBERS

- BILL CECIL, MAYOR**
- DAVID SWEET, MAYOR PRO-TEM**
- MATT SCOTT**
- CLIFF SEVIER**
- GLEN FARRIS**
- MARK RUSSO**
- MARGO NIELSEN**

CITY MANAGER

JULIE COUCH

ASSISTANT CITY MANAGER

RICHARD CROWLEY

CITY ENGINEER

CHUCK TODD, P.E.



BIRKHOFF, HENDRICKS & CARTER, L.L.P.
PROFESSIONAL ENGINEERS
Texas Firm F526
Dallas, Texas

DECEMBER 2010



SHEET INDEX

<u>SHEET NO.</u>	<u>SHEET DESCRIPTION</u>
1	COVER SHEET AND LOCATION MAP
2	DEMOLITION PLAN, PLAN & SECTION
3	LIFT STATION IMPROVEMENTS PLAN & SECTION
4	MISCELLANEOUS DETAILS

This record drawing is a compilation of the sealed engineering drawing for this project; modified by addenda, change orders and information furnished by the contractor. The information shown on the record drawings that was provided by the contractor or others not associated with the design engineer cannot be verified for accuracy or completeness. This original sealed drawings are on file at the offices of Birkhoff, Hendricks & Carter, L.L.P.

BY P.A.C. DATE 12/17/12