

0+00 - LINE "A" - OPEN CUT
 2' 6" DIA. & INSTALL
 1' 6" PRECAST MANHOLE
 OVER EXIST. 6" S.W. SEW.

LINE "A"

INSTALL 40 LF 6" MAIN
 BY OTHER THAN OPEN
 CUT. INSTALL 40 LF 10"
 STEEL ENCASUREMENT PIPE

PLUG EXISTING 6" CLAY
 PIPE AT M.H. AFTER
 COMPLETION OF PROPOSED
 6" MAIN

EXISTING 6" CLAY MAIN TO
 BE REMOVED AFTER COMPLETION
 OF PROPOSED 6" P.V.C. MAIN

CONNECT TO EXISTING 6"
 WATER MAIN
 INSTALL:
 1-6" x 6" TAPPING SLEEVE
 & 6" VALVE

CONNECT EXISTING 4" CLAY
 PIPE TO PROPOSED 6" MAIN

2'-50 - L.L. "A" END
 & CONSTRUCT CLEANOUT

INSTALL 2" x 3/4" WATER SERVICES &
 CONNECT TO EXISTING METERS

EXISTING 2" WATER SERVICE TO BE
 REMOVED AFTER COMPLETION OF
 6" P.V.C. WATER MAIN

INSTALL 6" P.V.C. WATER

CONNECT TO EXISTING 6"
 WATER MAIN
 INSTALL:
 1-6" x 6" TAPPING SLEEVE
 & 6" VALVE

LEGEND

- POWER POLE
- TELEPHONE BOX
- TELEPHONE M.H.
- GAS METER
- FIRE HYDRANT
- WATER METER
- WATER VALVE
- SEWER M.H.


NOTE:
 CONTRACTOR SHALL MAINTAIN
 ONE LANE OF TRAFFIC FLOW AT
 ALL TIMES

NOTE:
 ALL WATER MAINS TO BE
 INSTALLED 48" BELOW GRADE

NOTE:
 CONTRACTOR TO LOCATE &
 VERIFY ALL EXISTING UTILITIES
 PRIOR TO CONSTRUCTION

NOTE:
 RECONNECT ALL EXISTING
 SEWER LATERALS & WATER SERVICES
 TO PROPOSED 6" WATER & SEWER MAINS

NOTE:
 ALL UTILITY CONSTRUCTION SHALL
 MEET CITY OF ROCKWALL SPECIFICATIONS

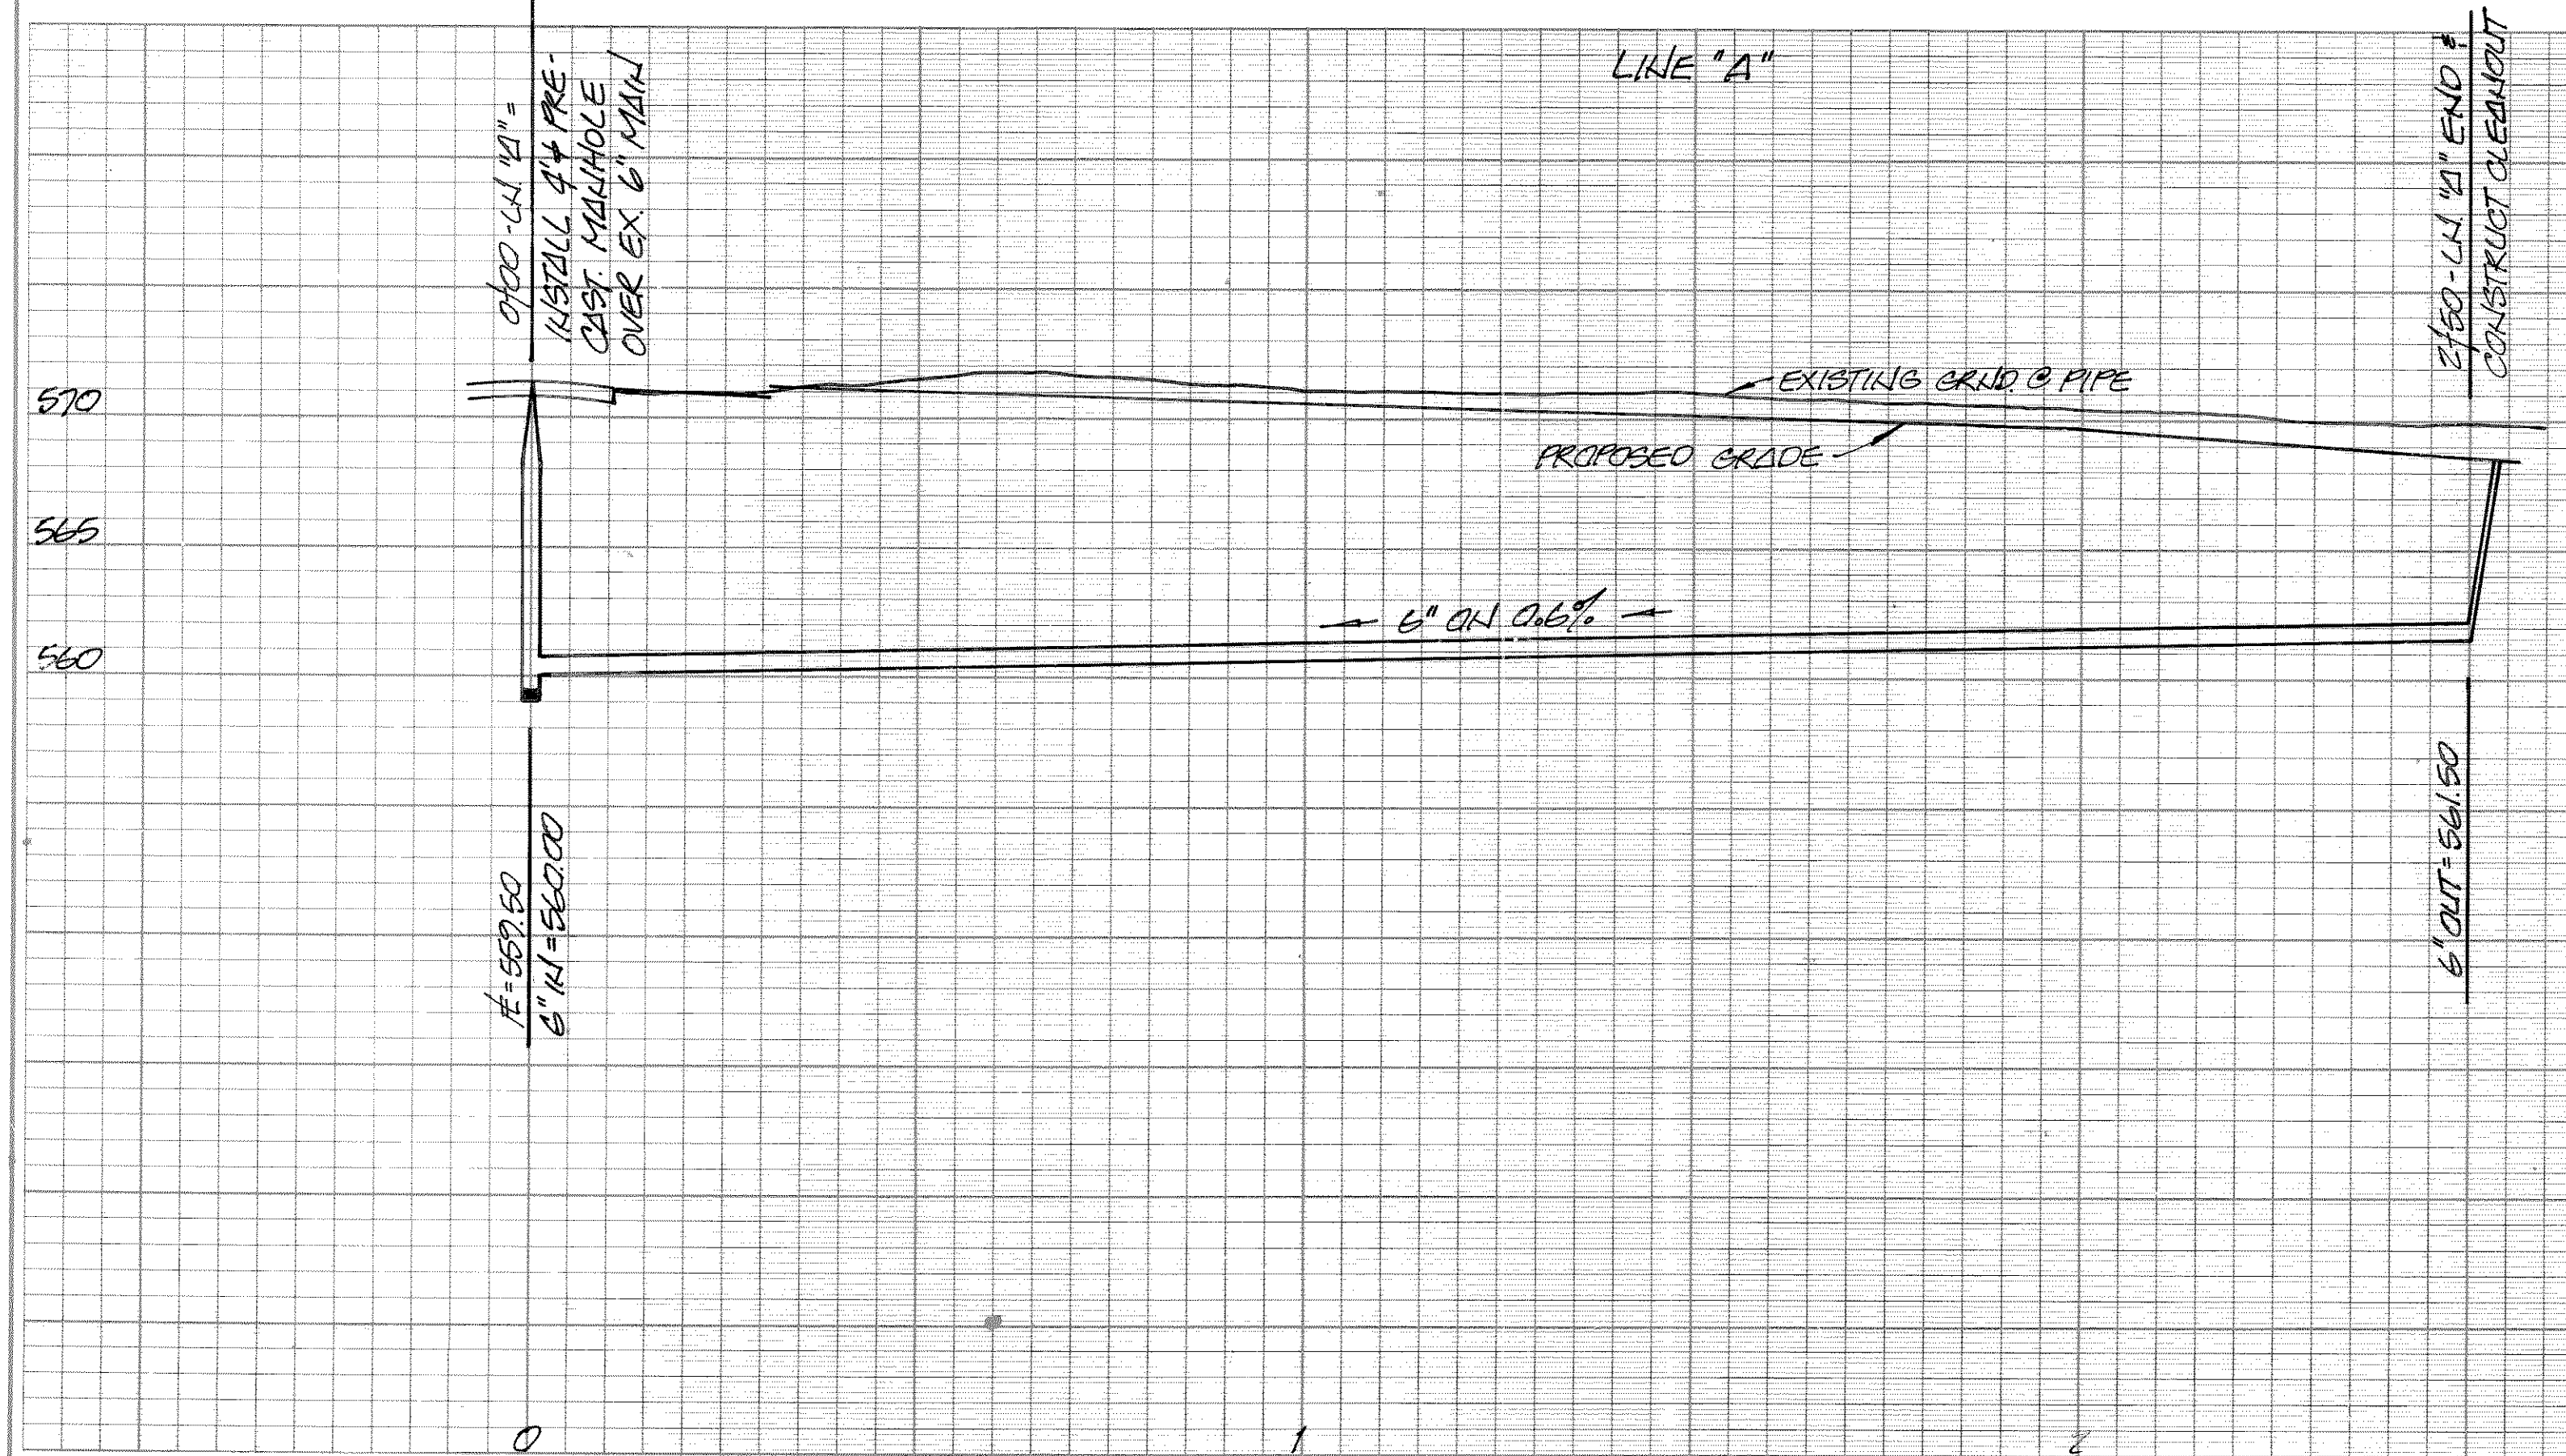

BENCH MARK:
 BOLT ON P.H. ON S. SIDE OF
 WILLIAMS @ INT. OF WILLIAMS &
 AUSTIN
 ELEV. = 571.94

REVISION: 5/16/87
 REVISED LOCATION OF LINE "A" FROM
 STA. 0+00 TO STA. 0+50. ADDED A 1' x
 1' PRECAST MANHOLE OVER 6" MAIN &
 DELETED A CONNECTION TO EX. M.H.
 REVISED OPEN CUT TO BORE & ENCASE.

REVISION NO.	REMARKS	DATE
UTILITY IMPROVEMENTS AUSTIN STREET		
CITY OF ROCKWALL, TEXAS 205 W. RUSK STREET 214-722-1111		
DESIGNED: W.L.D.	SCALE: NOTED	
DRAWN: W.L.D.	APPROVED: <i>W.L. Dougherty</i>	
JOB NO. 87004	DATE 3-87	SHEET NO. 39

