


CAUTION !!
 UNDERGROUND GAS MAIN IN THIS AREA. CONTACT JOE CABEZUELA w/ LONE STAR GAS COMPANY • 12-41573-8718 OR 12141382-6498 (PAGER) PRIOR TO CONSTRUCTION

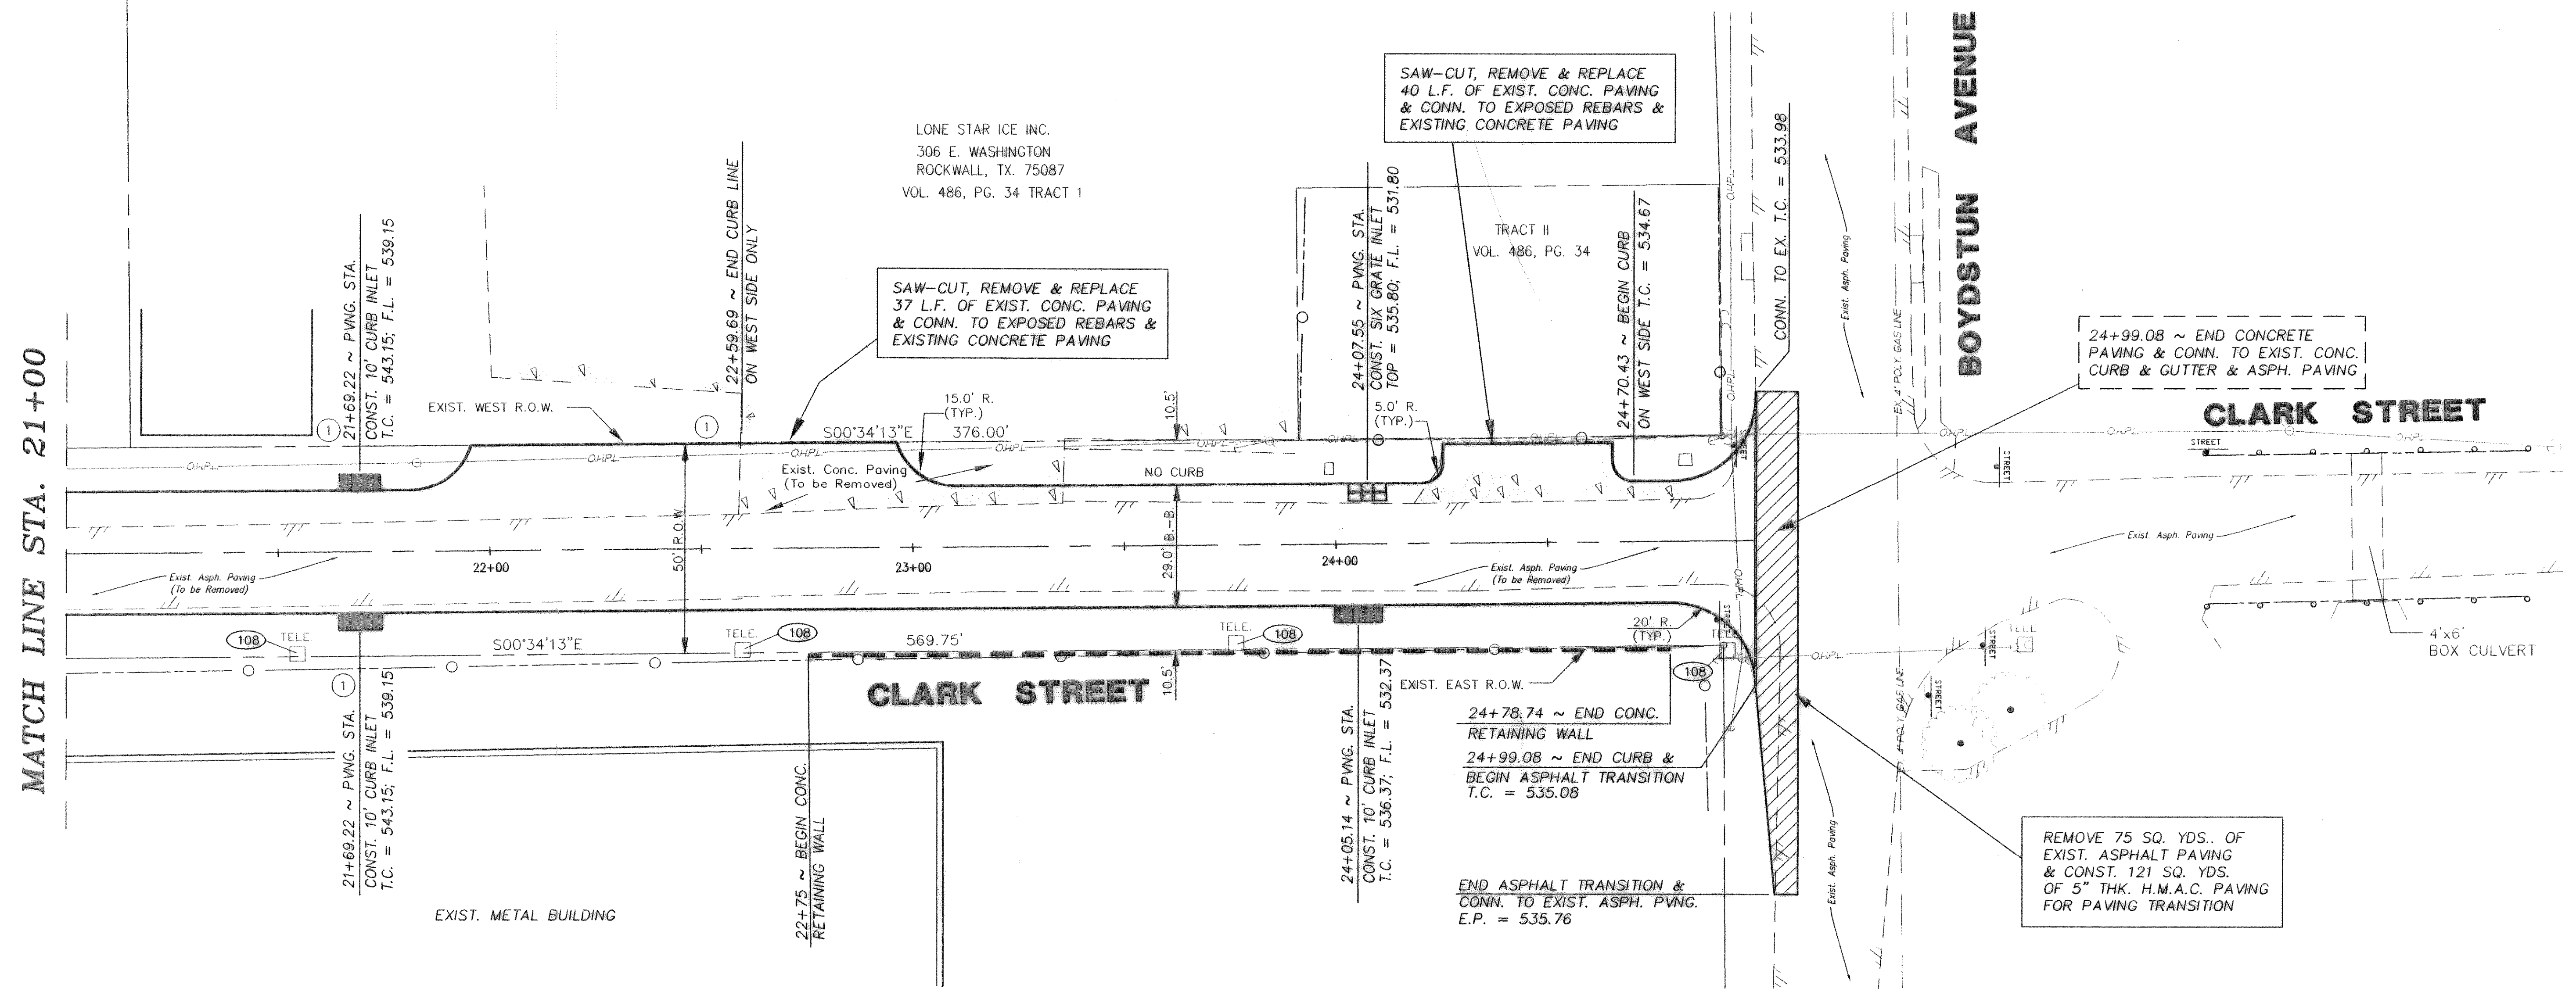

MATCH LINE STA. 21+00

BOYDSTUN AVENUE

CLARK STREET

LEGEND

- EXISTING POWER POLE
- EXISTING TELEPHONE PEDESTAL
- EXISTING WATER METER
- EXISTING GAS METER
- EXISTING WATER VALVE
- EXISTING TELEPHONE MANHOLE
- ITEM NUMBER (SEE SHEET 2 FOR DESCRIPTION.)

B.M. NO. 1 ~ 60D NAIL SET IN POWER POLE ON THE EAST SIDE OF THROCKMORTON & APPROX. 141.4 FEET NORTH OF CENTER INTERSECTION OF BOURN & THROCKMORTON. ELEV. = 574.10

B.M. NO. 2 ~ 60D NAIL SET IN POWER POLE ON THE SOUTH SIDE OF BOURN STREET & APPROX. 232.3 FEET EAST OF CENTER INTERSECTION OF PETERS COLONY & BOURN STREET. ELEV. = 551.50

REVISION NO.	REMARKS	DATE
1	Revised drive location on West side of Clark Street going into Lone Star Ice Company. Also increased radii to 15' Radius. Moved 10' Curb Inlets down from Sta. 22+24.74 to Sta. 21+69.22.	1/23/97

PAVING IMPROVEMENTS
BOURN STREET
ROCKWALL, TEXAS

CITY OF ROCKWALL
 "THE NEW HORIZON"

DESIGNED:	B.W.H.	DATE:	1/23/97
DRAWN:	ACAD	THE SEAL APPEARING ON THIS DOCUMENT WAS AUTHORIZED BY W.L. DOUPHRATE II TEXAS P.E. NO. 60102 ON 1/23/97	
JOB NO.		DATE:	
		SHEET NO.:	7 of 28