


GRAPHIC SCALE

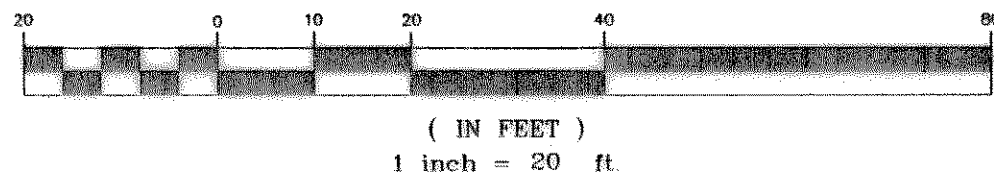

CAUTION !!
UNDERGROUND GAS MAIN IN THIS AREA. CONTACT JOE CABEZUELA
w/ LONE STAR GAS COMPANY @
12141573-8716 OR 12141802-6498
IPAGERI PRIOR TO CONSTRUCTION

GOLIAD STREET (S.H. 2051)

MATCH LINE STA. 5+50

CONST. 137 SQ. YD'S OF
5" THK. H.M.A.C. PAVING
& CONN. TO EXIST. ASPH.
PAVING & CONC. CURB & GUT.

REMOVE & DISPOSE OF 127 SQ. YDS.
OF EXIST. ASPHALT PAVING & CONST.
157 SQ. YD'S OF 5" THK. H.M.A.C.
FOR PAVING TRANSITION

REMOVE & DISPOSE OF 140 SQ. YDS.
OF EXIST. ASPHALT PAVING & CONST.
167 SQ. YD'S OF 5" THK. H.M.A.C.
FOR PAVING TRANSITION

BLOCK L
DONALD L. GARDNER
12 PARK CENTRAL DR.
ROCKWALL, TX.
VOL. 191 PG. 75

MARIA DEL R BATRES
202 BOURN AVE.
ROCKWALL, TX. 75087
VOL. 449 PG. 107

R.T. MOTON
293 E. BOURN AVE.
ROCKWALL, TX.

ROCKWALL AREA
HABITAT FOR HUMANITY
2136 CHISHOLM TRAIL
ROCKWALL, TX. 75087

SAW-CUT, REMOVE & REPLACE
45 L.F. OF EXIST. CONC. PAVING
& CONN. TO EXPOSED REBARS &
EXISTING CONCRETE PAVING

SAW-CUT, REMOVE & REPLACE
31 L.F. OF EXIST. CONC. PAVING
& CONN. TO EXPOSED REBARS &
EXISTING CONCRETE PAVING


0+33.59 ~ BEGIN CONCRETE
PAVING & CONSTRUCT CONCRETE
STREET HEADER

REMOVE & DISPOSE OF 155 SQ. YDS.
OF EXIST. ASPHALT PAVING & CONST.
174 SQ. YD'S OF 5" THK. H.M.A.C.
FOR PAVING TRANSITION

LEGEND

- EXISTING POWER POLE
- EXISTING TELEPHONE PEDESTAL
- EXISTING WATER METER
- EXISTING GAS METER
- EXISTING WATER VALVE
- EXISTING TELEPHONE MANHOLE

ITEM NUMBER (SEE SHEET 2 FOR DESCRIPTION.)

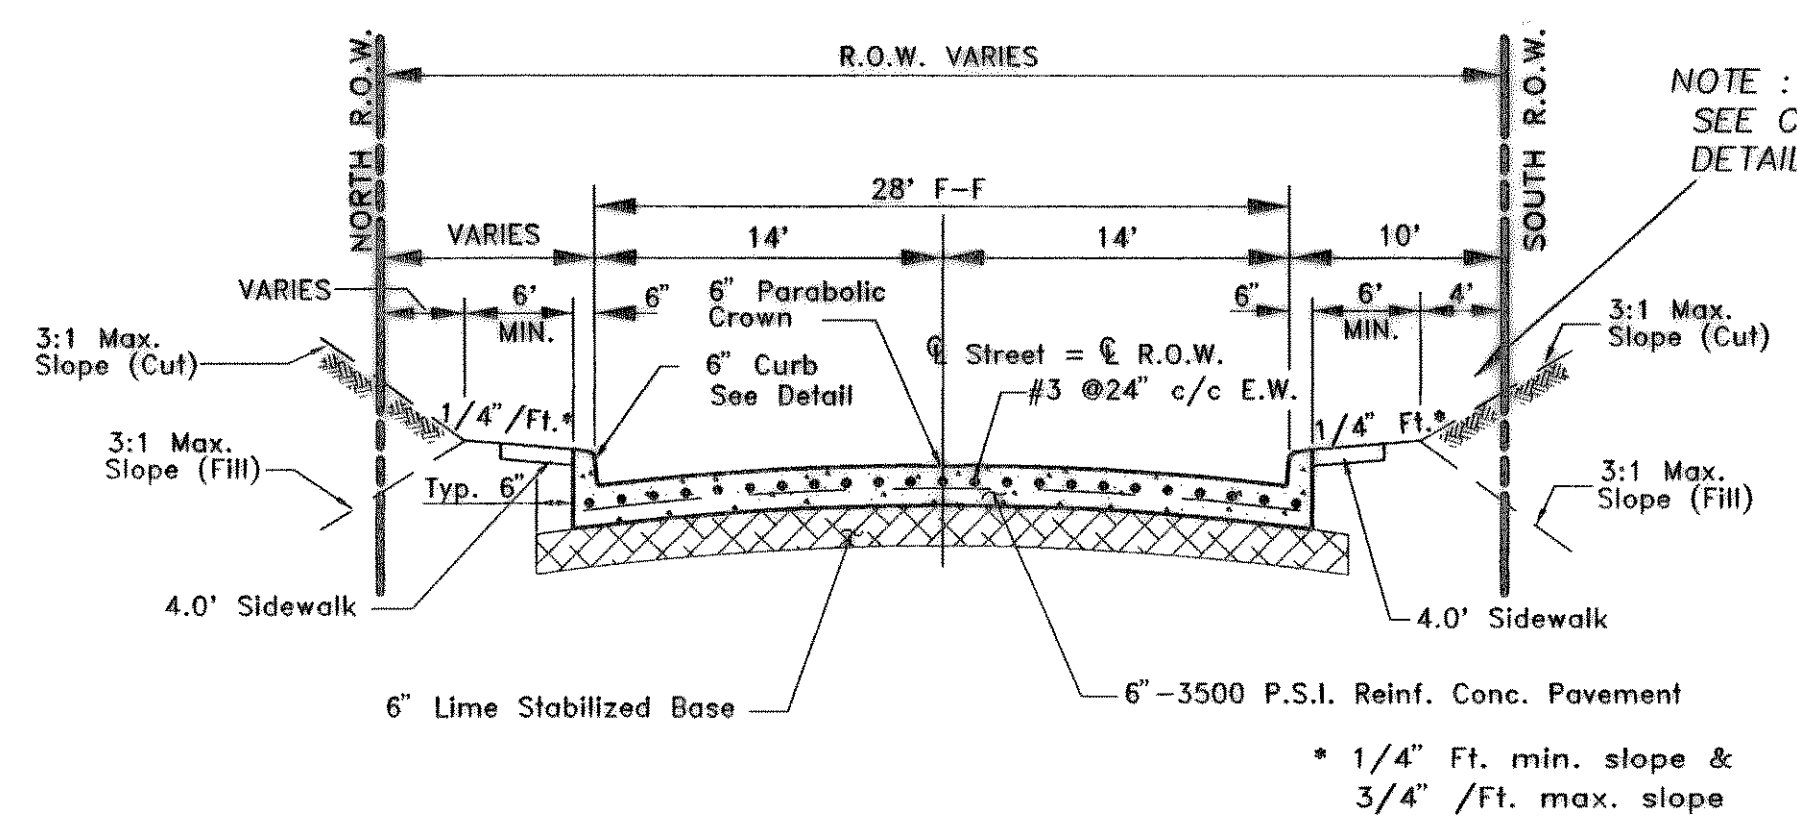

TYPICAL PAVING SECTION
NOT TO SCALE

* 1/4" Ft. min. slope &
3/4" /Ft. max. slope

NOTE :
SEE CROSS SECTIONS FOR
DETAIL OF CUT & FILL

B.M. NO. 1 ~ 60D NAIL SET IN POWER POLE
ON THE EAST SIDE OF THROCKMORTON & APPROX.
141.4 FEET NORTH OF CENTER INTERSECTION OF
BOURN & THROCKMORTON. ELEV. = 574.10


B.M. NO. 2 ~ 60D NAIL SET IN POWER POLE
ON THE SOUTH SIDE OF BOURN STREET & APPROX.
232.3 FEET EAST OF CENTER INTERSECTION OF
PETERS COLONY & BOURN STREET.
ELEV. = 551.50

REVISION NO.	REMARKS	DATE

PAVING IMPROVEMENTS

BOURN STREET

ROCKWALL, TEXAS

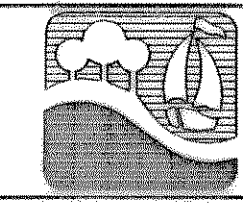

CITY OF ROCKWALL

"THE NEW HORIZON"

DESIGNED:	B.W.H.	THE SEAL APPEARING ON THIS DOCUMENT WAS AUTHORIZED BY W.L. DOUPHRATE II TEXAS P.E. NO. 60102 ON 11/26
DRAWN:	ACAD	
JOB NO.		DATE: 4/22/96 SHEET NO. 3 of 28

