


LONE STAR ICE INC.
306 E. WASHINGTON
ROCKWALL, TX. 75087
486/34 TRACT 1

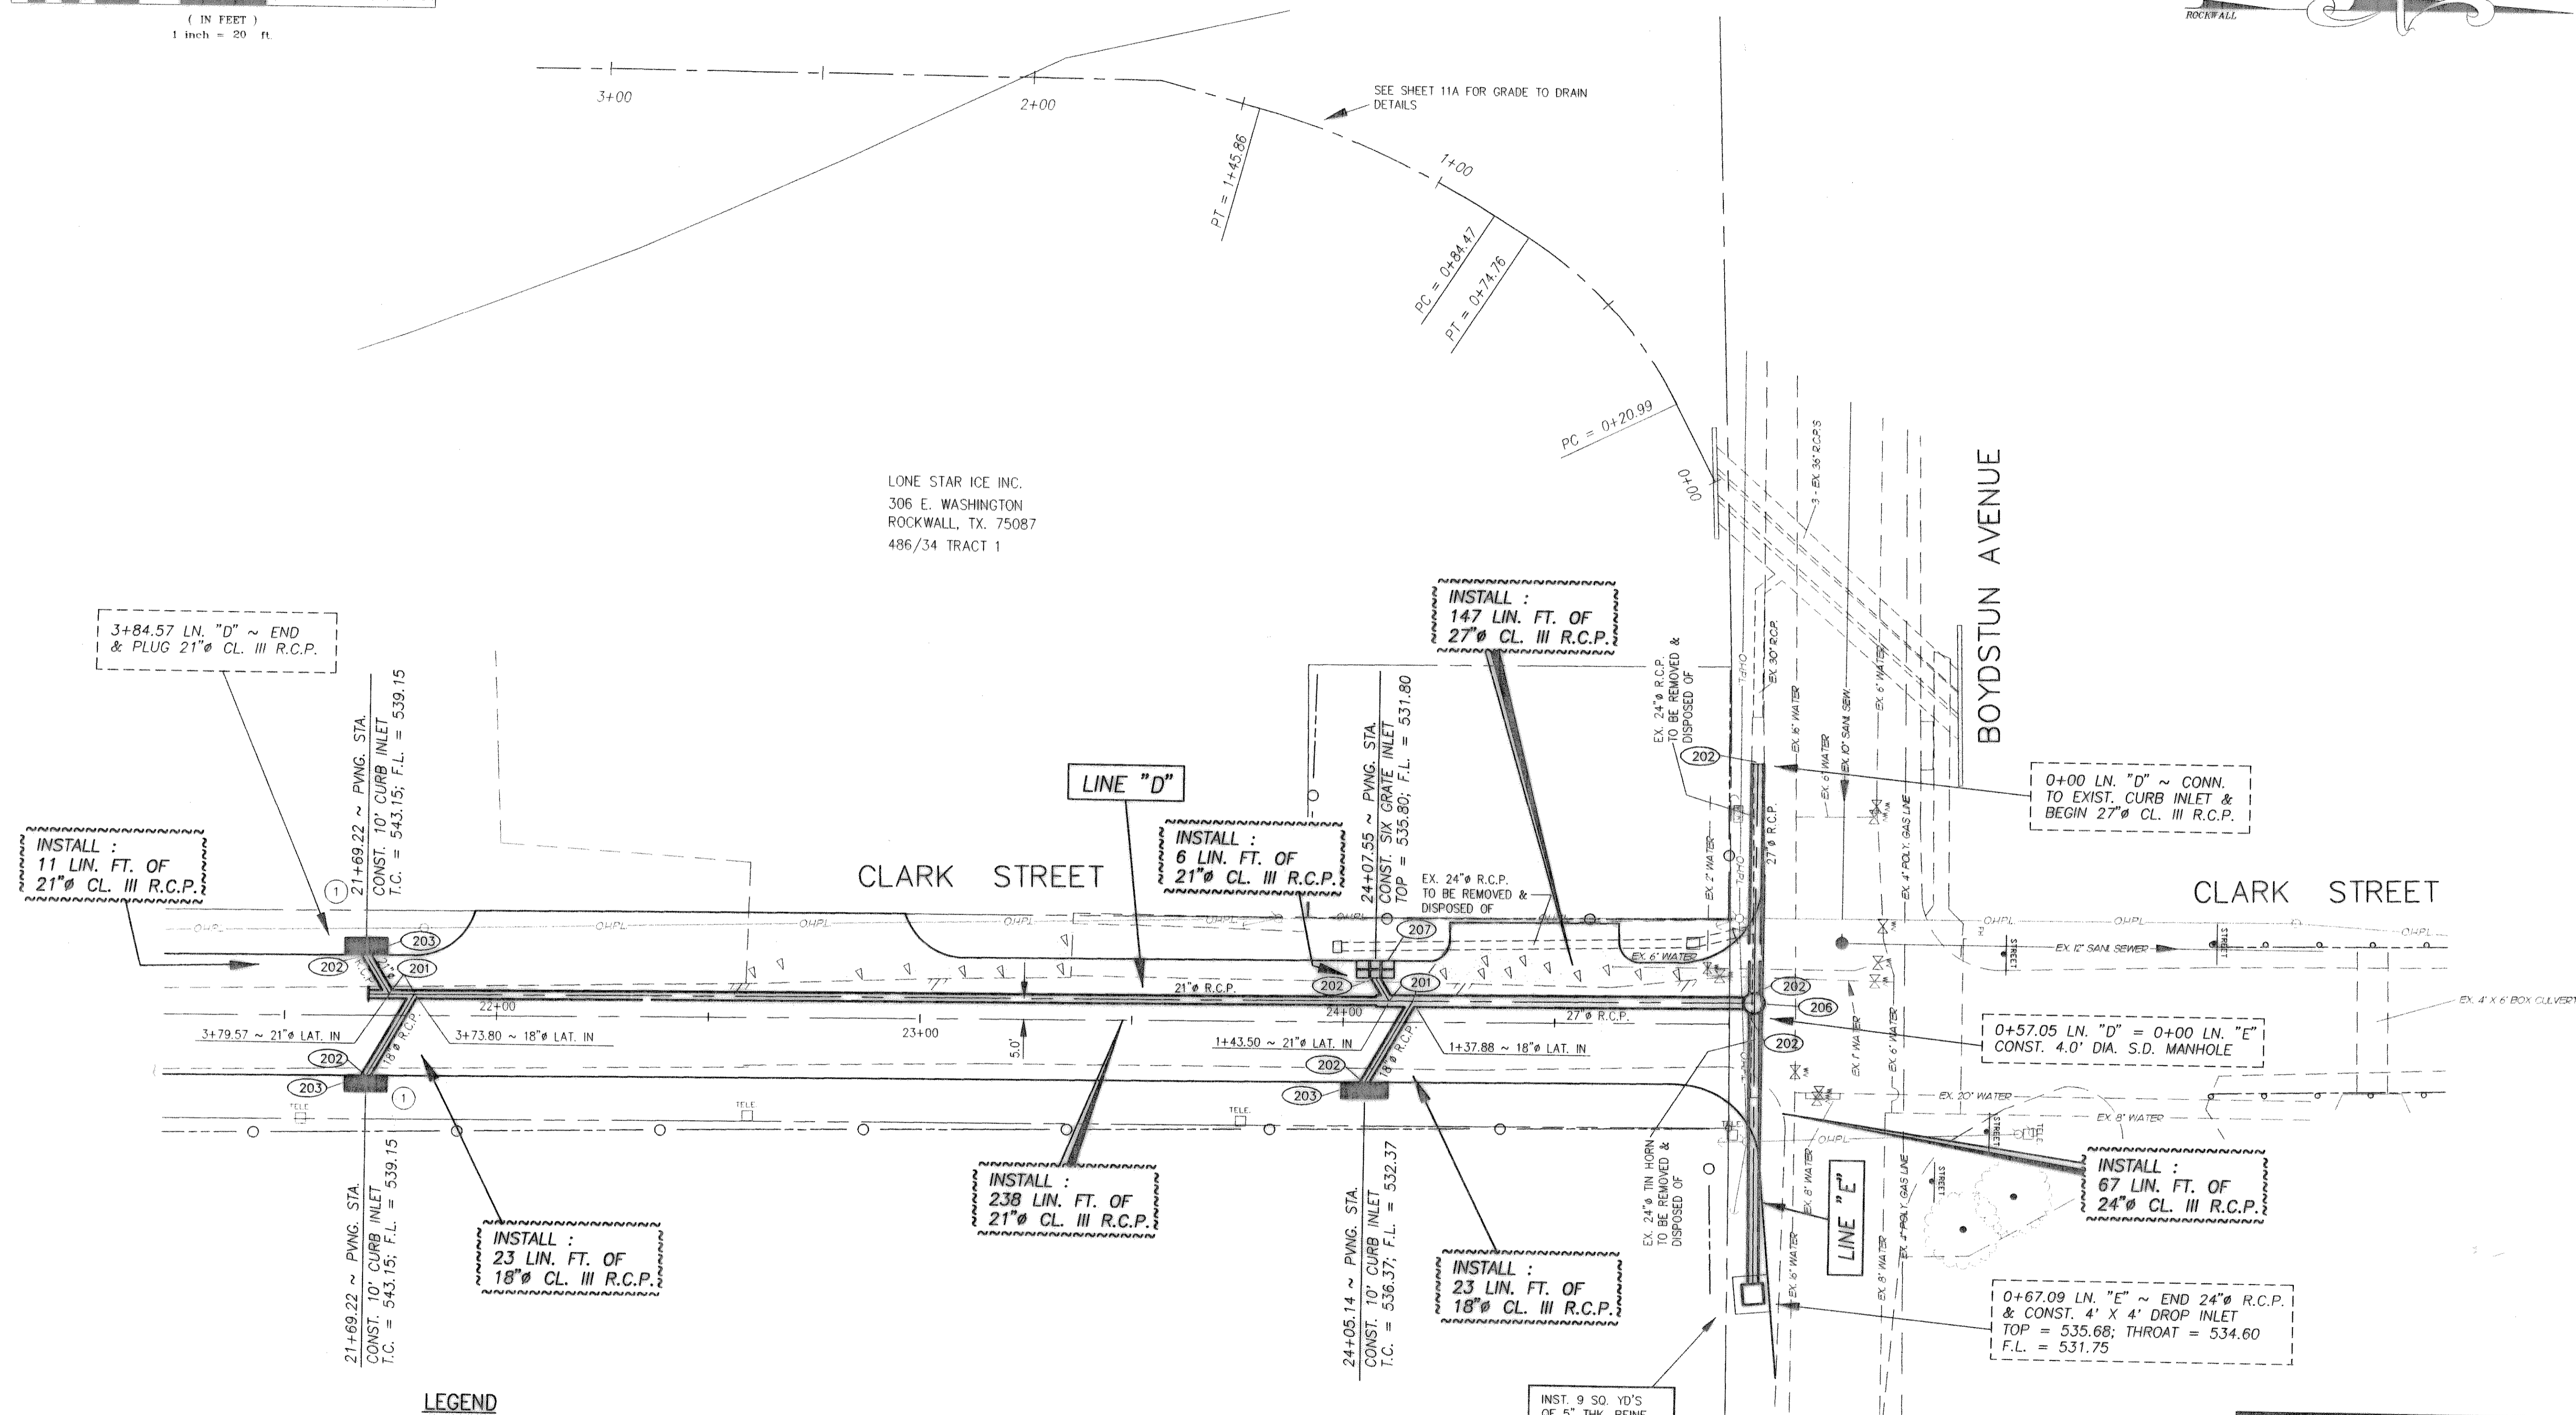

LEGEND

- EXISTING POWER POLE
- EXISTING TELEPHONE PEDESTAL
- EXISTING WATER METER
- EXISTING GAS METER
- EXISTING WATER VALVE
- EXISTING TELEPHONE MANHOLE
- ITEM NUMBER (SEE SHEET 2 FOR DESCRIPTION.)

B.M. NO. 1 ~ 60D NAIL SET IN POWER POLE ON THE EAST SIDE OF THROCKMORTON & APPROX. 141.4 FEET NORTH OF CENTER INTERSECTION OF BOURN & THROCKMORTON. ELEV. = 574.10

B.M. NO. 2 ~ 60D NAIL SET IN POWER POLE ON THE SOUTH SIDE OF BOURN STREET & APPROX. 232.3 FEET EAST OF CENTER INTERSECTION OF PETERS COLONY & BOURN STREET. ELEV. = 551.50

REVISION NO.	REMARKS	DATE
1	Revised drive location on West side of Clark Street. Moved 10' Curb Inlets down from Sta. 22+24.74 to Sta. 21+69.22. Extended Line D down 65.37' to clear New C.R.	1/23/97

STORM DRAINAGE IMPROVEMENTS
BOURN STREET
ROCKWALL, TEXAS

CITY OF ROCKWALL
"THE NEW HORIZON"

DESIGNED: B.W.H.	
DRAWN: ACAD	
JOB NO.	
DATE: 9/20/96	SHEET NO. 15 OF 28