


CAUTION !!
 UNDERGROUND GAS MAIN IN THIS AREA. CONTACT JOE CABEZUELA w/ LONE STAR GAS COMPANY • (214)873-3710 OR (214)362-8488 (PAGER) PRIOR TO CONSTRUCTION

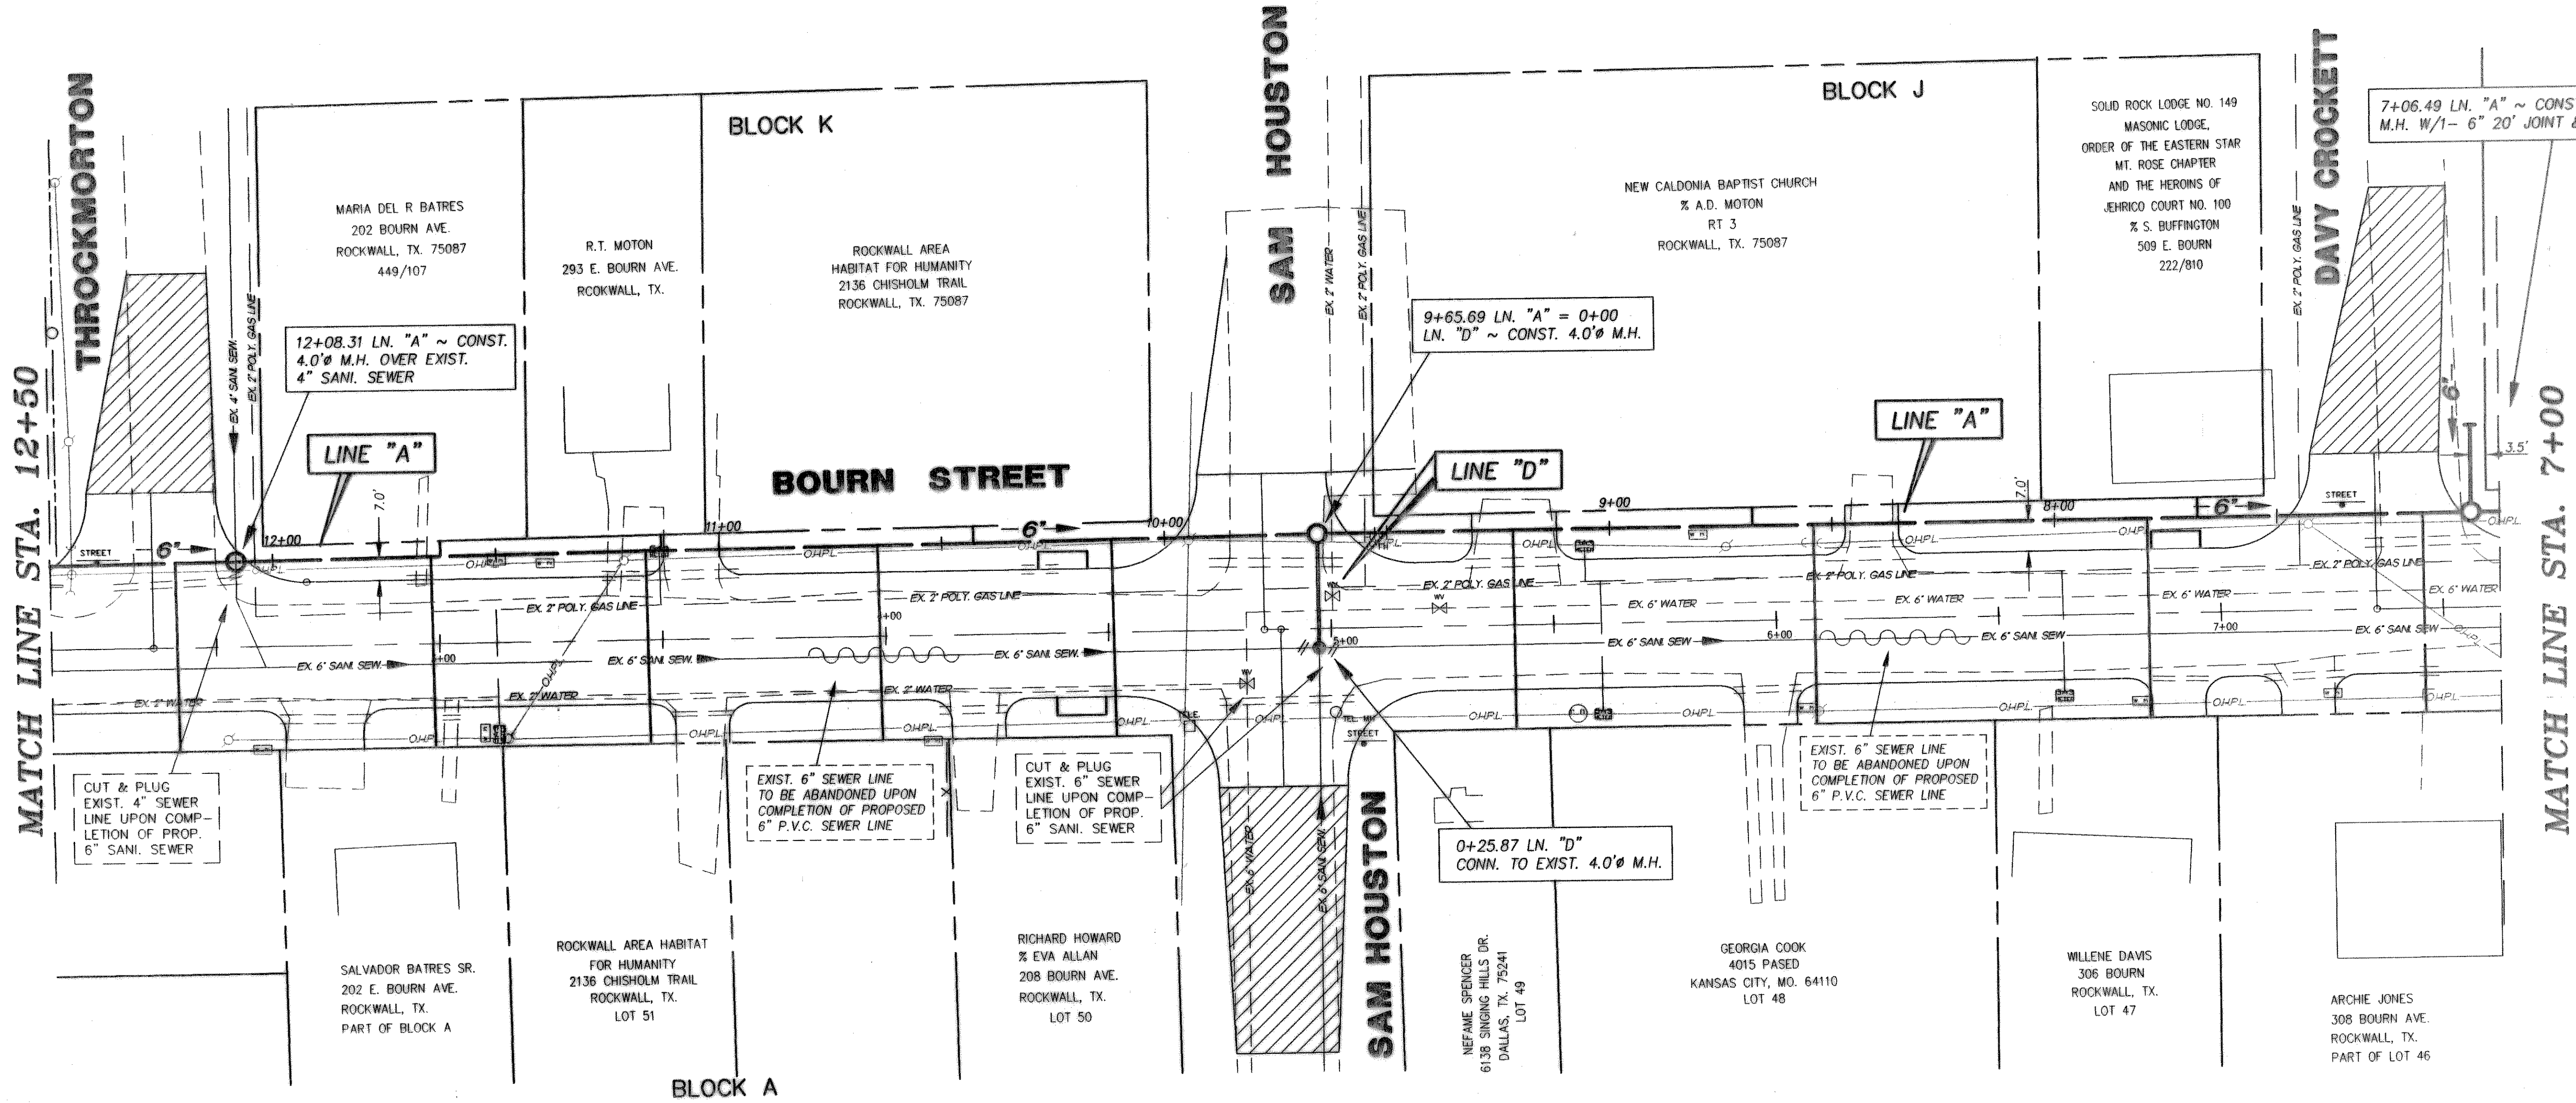

LEGEND

- EXISTING POWER POLE
- EXISTING TELEPHONE PEDESTAL
- EXISTING WATER METER
- EXISTING GAS METER
- EXISTING WATER VALVE
- EXISTING TELEPHONE MANHOLE
- EXISTING FIRE HYDRANT

B.M. NO. 1 ~ 60D NAIL SET IN POWER POLE ON THE EAST SIDE OF THROCKMORTON & APPROX. 141.4 FEET NORTH OF CENTER INTERSECTION OF BOURN & THROCKMORTON. ELEV. = 574.10

B.M. NO. 2 ~ 60D NAIL SET IN POWER POLE ON THE SOUTH SIDE OF BOURN STREET & APPROX. 232.3 FEET EAST OF CENTER INTERSECTION OF PETERS COLONY & BOURN STREET. ELEV. = 551.50

WASTEWATER IMPROVEMENTS
BOURN STREET
ROCKWALL, TEXAS
 CITY OF ROCKWALL
 "THE NEW HORIZON"

REVISION NO.	REMARKS	DATE

DESIGNED: B.W.H.	THE SEAL APPEARING ON THIS DOCUMENT WAS AUTHORIZED BY W.L. DOUPHRATE II NO. 60102 ON 10/2/96
DRAWN: ACAD	
JOB NO.	
DATE: 5/23/96	SHEET NO. 26 of 28