


CAUTION !!
 UNDERGROUND GAS MAIN IN THIS AREA. CONTACT JOE CABEZUELA w/ LONE STAR GAS COMPANY @ (214)873-3716 OR (214)362-6468 (PAGER) PRIOR TO CONSTRUCTION

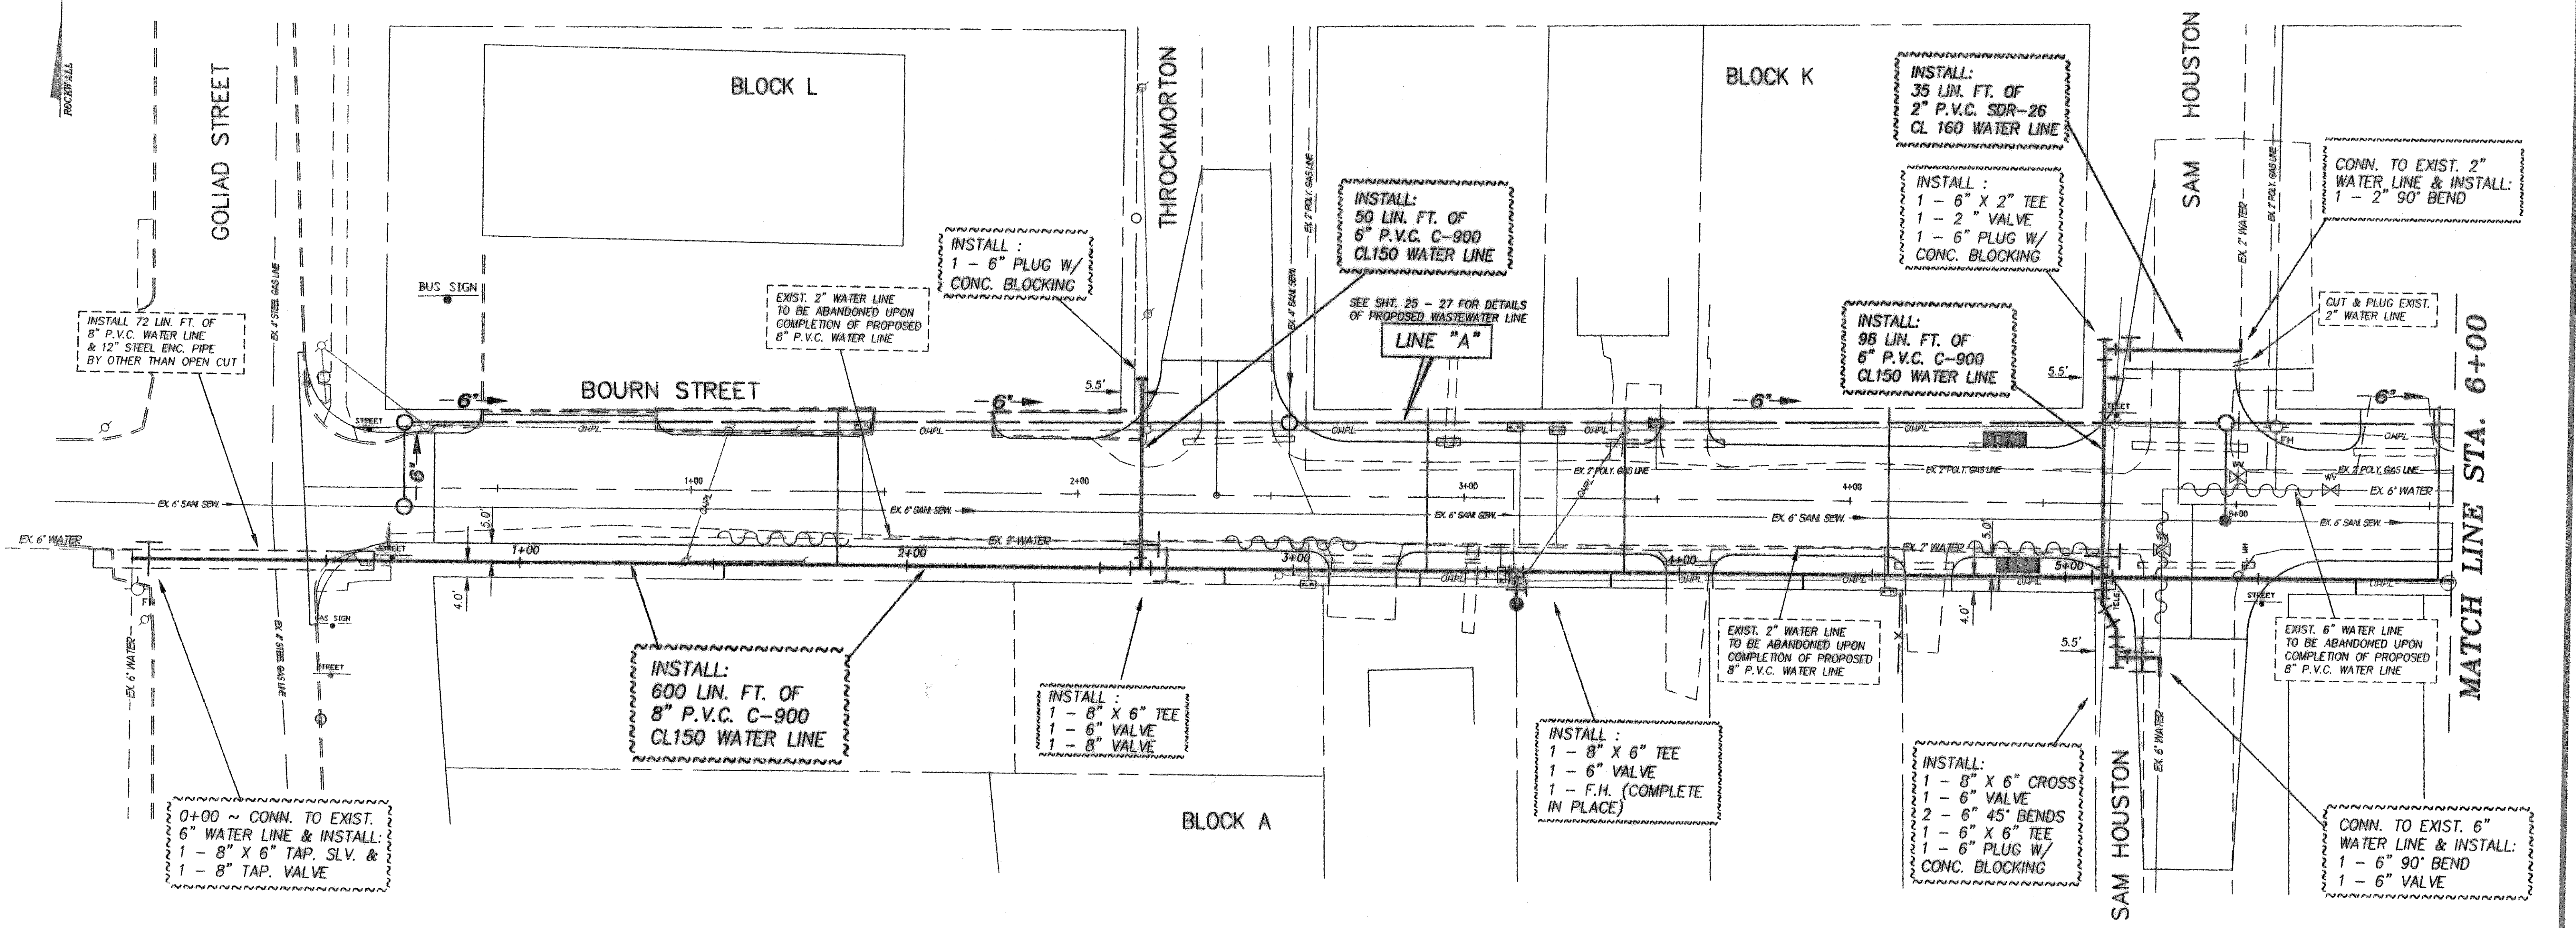

LEGEND

- EXISTING POWER POLE
- EXISTING TELEPHONE PEDESTAL
- EXISTING WATER METER
- EXISTING GAS METER
- EXISTING WATER VALVE
- EXISTING TELEPHONE MANHOLE
- EXISTING FIRE HYDRANT

WATER LINE IMPROVEMENTS			
BOURN STREET			
ROCKWALL, TEXAS			
CITY OF ROCKWALL			
"THE NEW HORIZON"			
DESIGNED:	B.W.H.	THE SEAL APPEARING ON THIS DOCUMENT WAS AUTHORIZED BY W.L. DOUPHRATE II TEXAS P.E. NO. 60102 ON 02/27/96	
DRAWN:	ACAD		
JOB NO.			
REVISION NO.	REMARKS	DATE	
DATE:	5/23/96	SHEET NO.	20 of 28