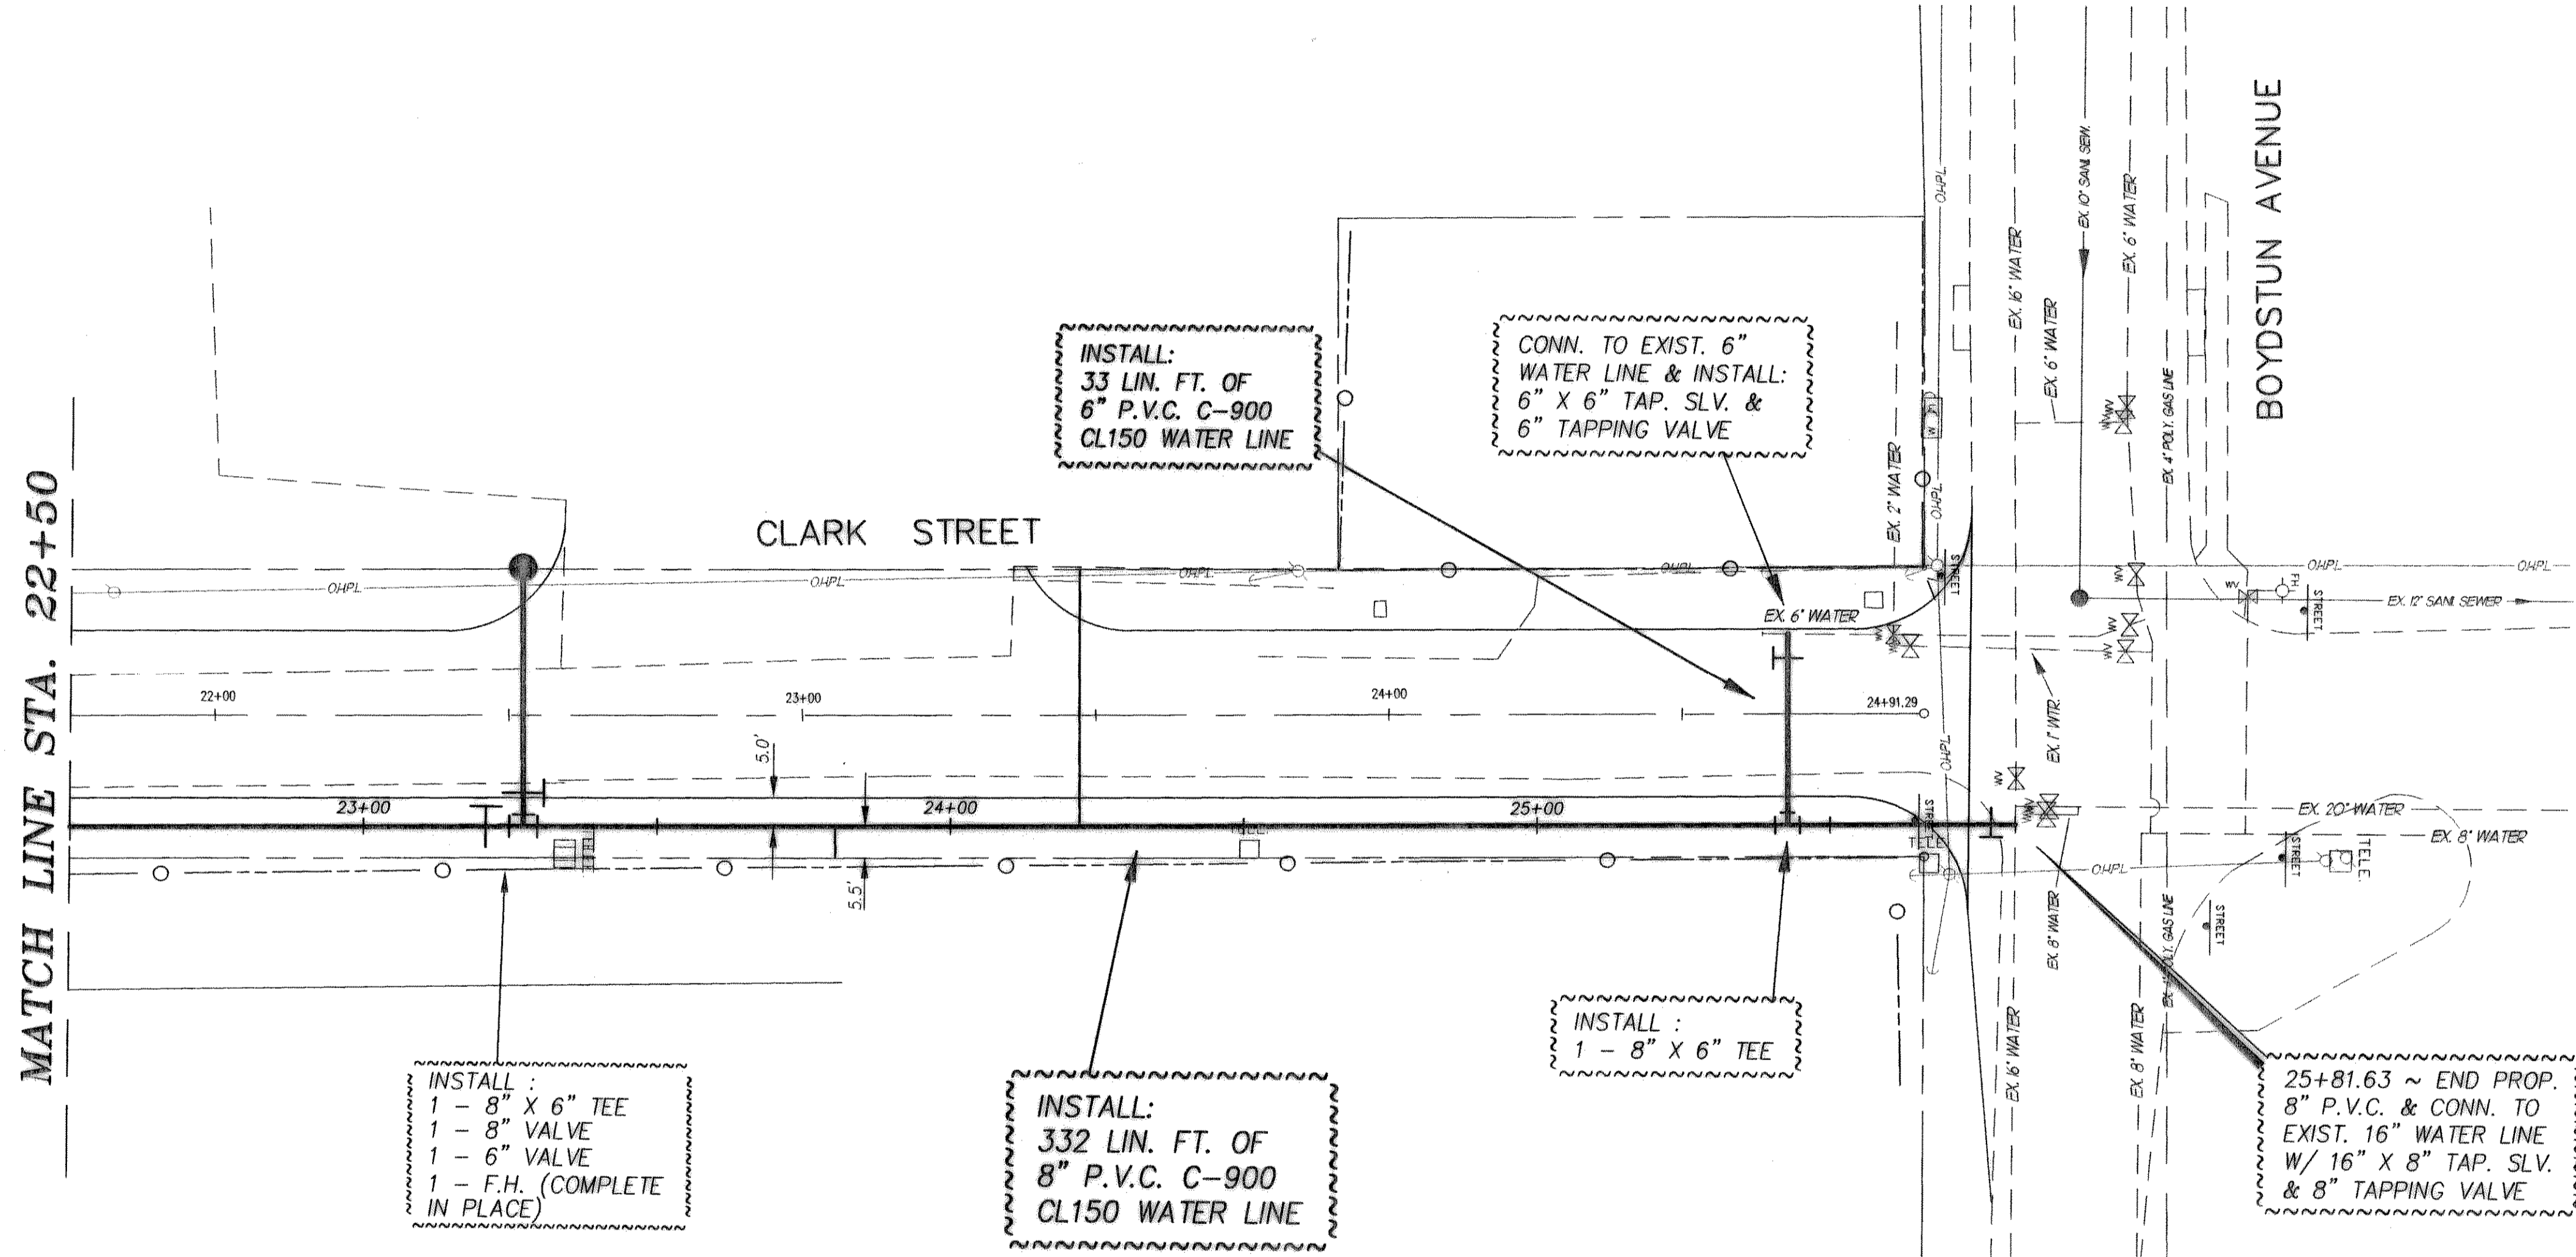

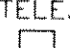
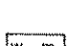






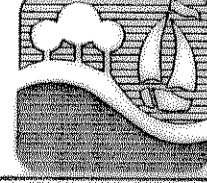
**CAUTION !!**  
UNDERGROUND GAS MAIN IN THIS AREA. CONTACT JOE CABEZUELA w/ LONE STAR GAS COMPANY • 12141873-3716 OR 12141862-6498 (PAGER) PRIOR TO CONSTRUCTION



**LEGEND**

-  EXISTING POWER POLE
-  EXISTING TELEPHONE PEDESTAL
-  EXISTING WATER METER
-  EXISTING GAS METER
-  EXISTING WATER VALVE
-  EXISTING TELEPHONE MANHOLE
-  EXISTING FIRE HYDRANT

**WATER LINE IMPROVEMENTS**  
**BOURN STREET**  
**ROCKWALL, TEXAS**

 **CITY OF ROCKWALL**  
 "THE NEW HORIZON"

REVISION NO.	REMARKS	DATE

DESIGNED: B.W.H.  
 DRAWN: ACAD  
 JOB NO.:

THE SEAL APPEARING ON THIS DOCUMENT WAS AUTHORIZED BY W.L. DOUPHRATE II TEXAS P.E. NO. 60102 ON 1/9/96

DATE: 5/24/96 SHEET NO. 24 of 28

