



# ROCKWALL, TEXAS

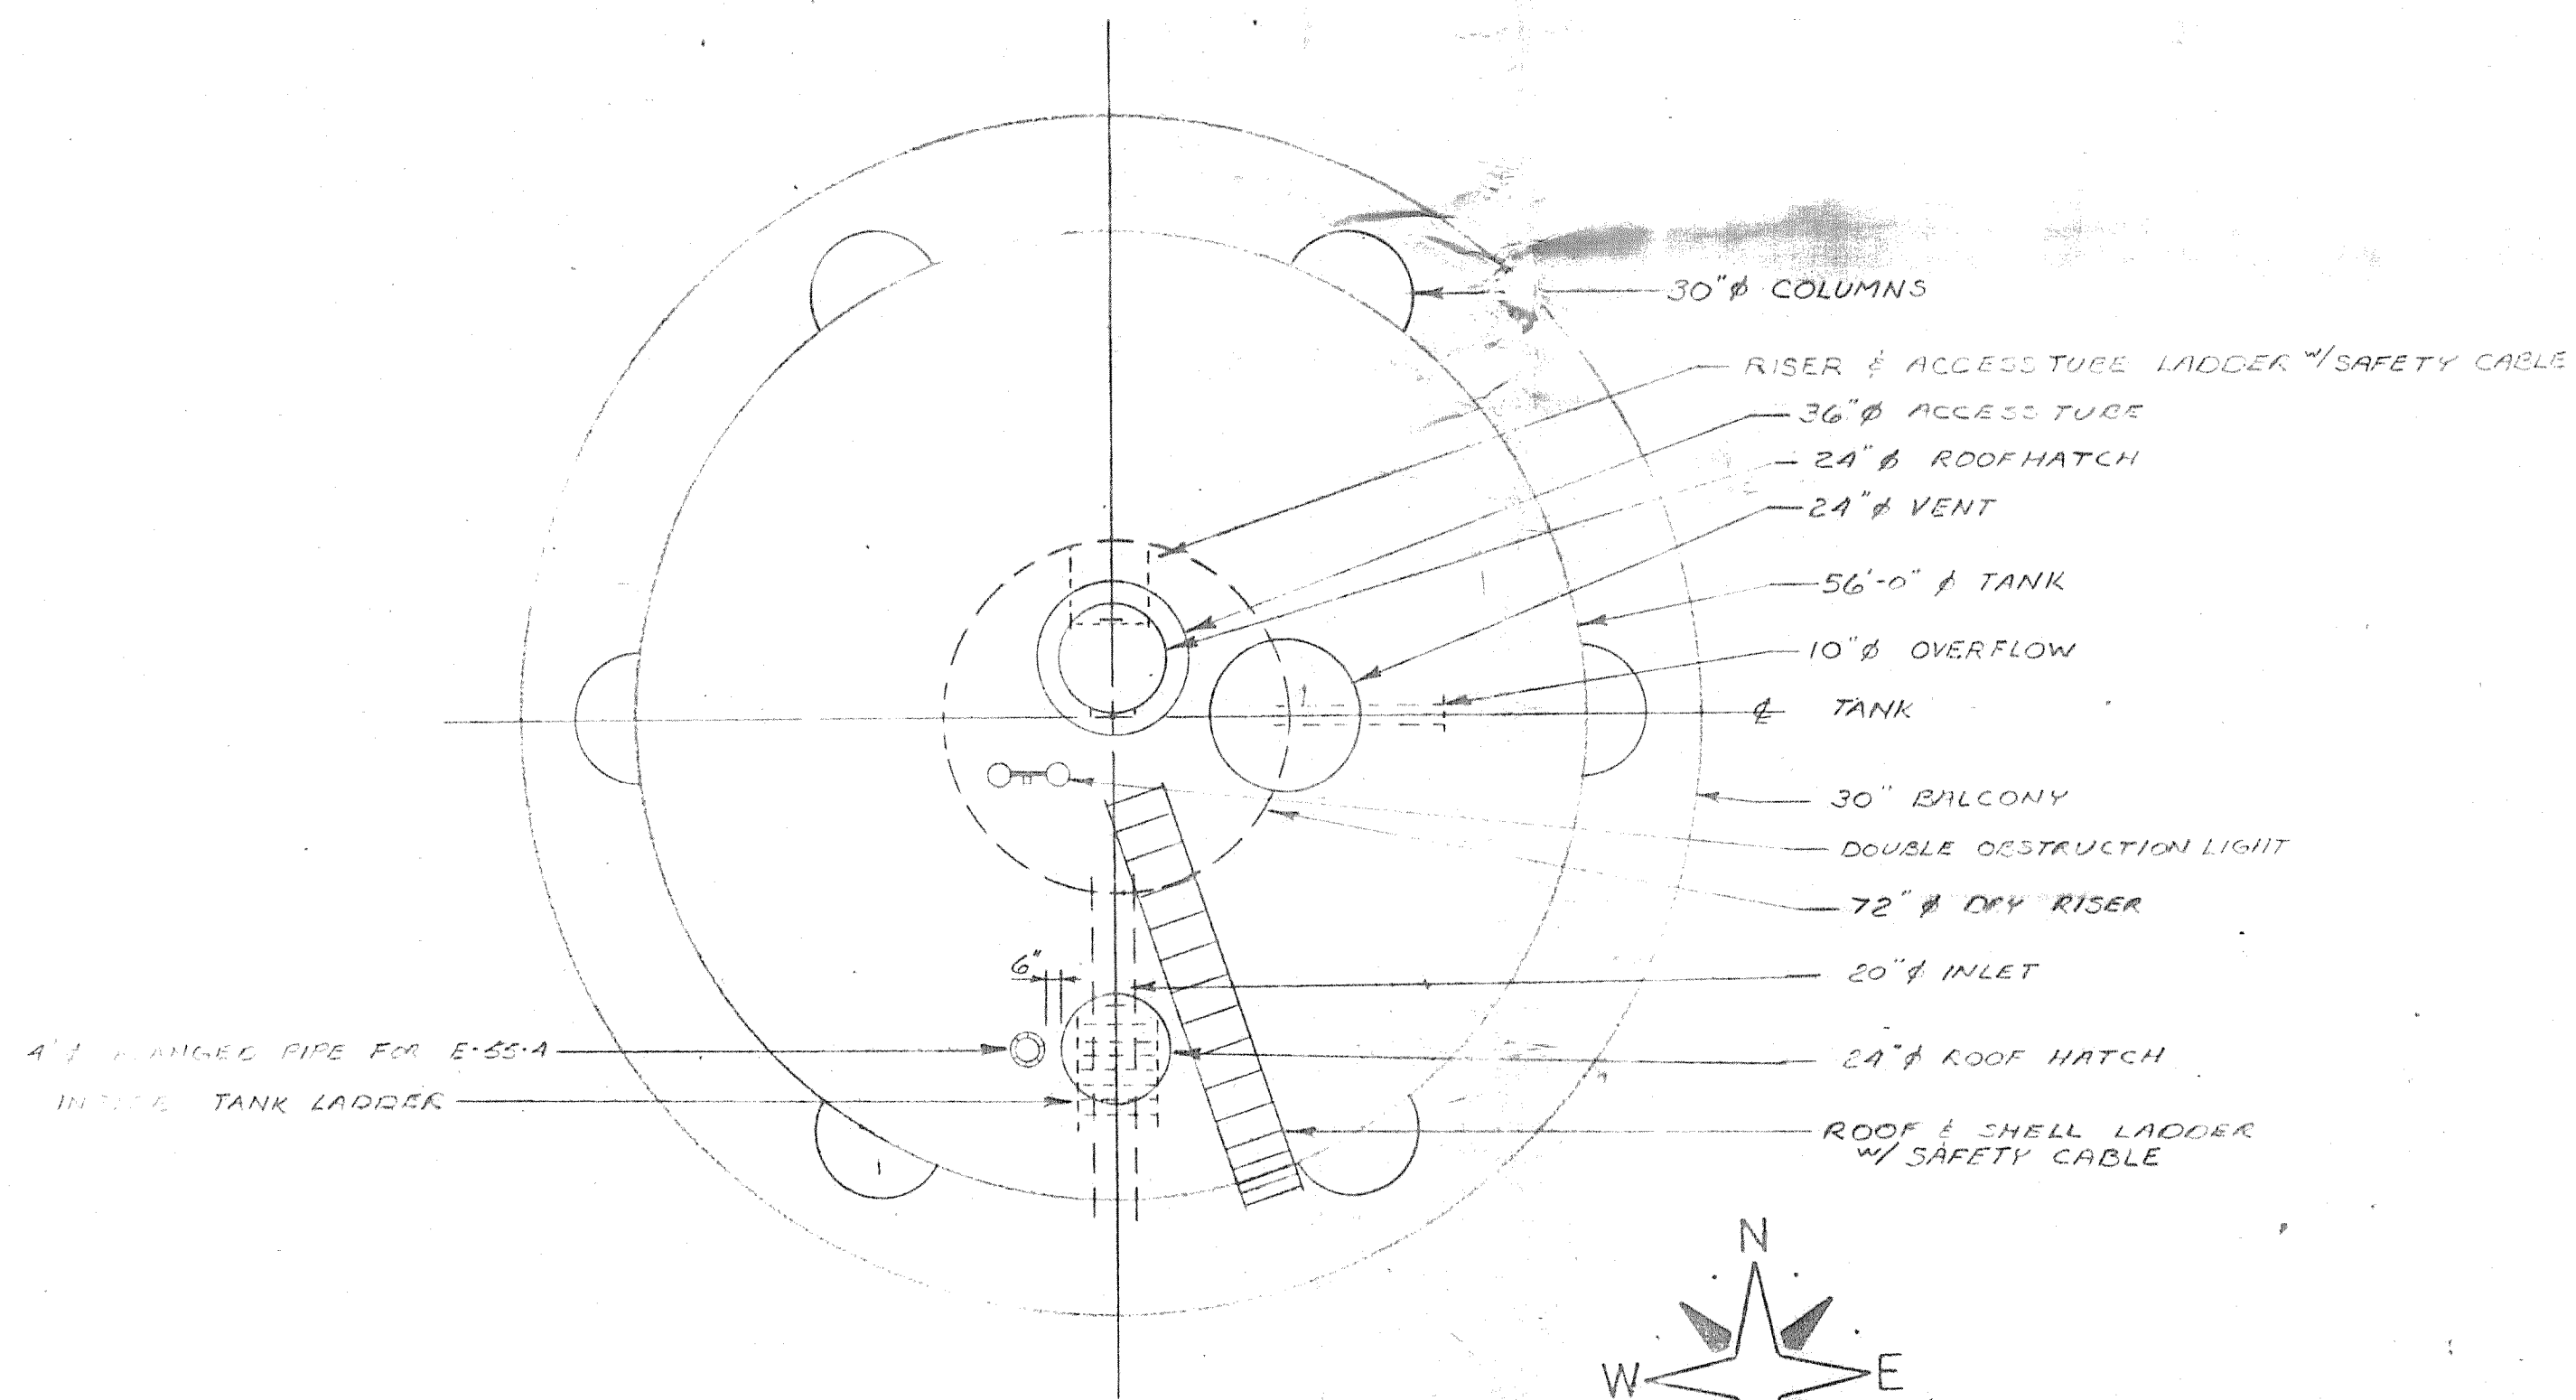

**ORIENTATION VIEW**  
CAP. 500,000 GAL. HWL. 119'-0"

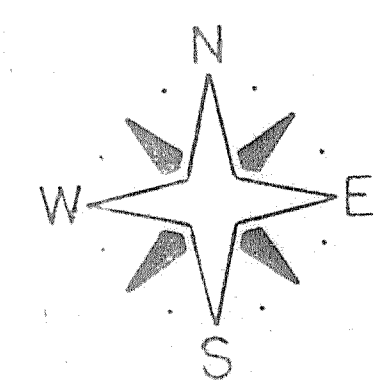

APPROVED     APPROVED AS CORRECTED  
 NOT APPROVED - REVISE AND RESUBMIT  
 CHECKED FOR GENERAL COMPLIANCE WITH PLANS AND SPECIFICATIONS. CONTRACTOR SHALL VERIFY ALL DIMENSIONS AND QUANTITIES. ALL OCCURRING EQUIPMENT ASSEMBLY AND WORK OF ALL TRADES. NO DEVIATION FROM PLANS AND SPECIFICATIONS PERMITTED UNLESS SPECIFICALLY NOTED.  
 FREESE AND NICHOLS  
 CONSULTING ENGINEERS -  
 BY: *JBN* DATE: 6-2-78

*File*  
 6544  
 ROCKWALL, TX.

UNIVERSAL TANK & IRON WORKS, INC.  
 INDIANAPOLIS, INDIANA     $\longleftrightarrow$     ENNIS, TEXAS