



NOTE:
ALL CONSTRUCTION TO CONFORM TO
CITY OF ROCKWALL STANDARDS

NOTE:
ALL STORM SEWER TO BE CLASS
III REINFORCED CONCRETE PIPE

NOTE:
CONTRACTOR TO REMOVE & REPLACE
ALL WATER & SEWER SERVICES AS
REQUIRED TO INSTALL STORM SEWER

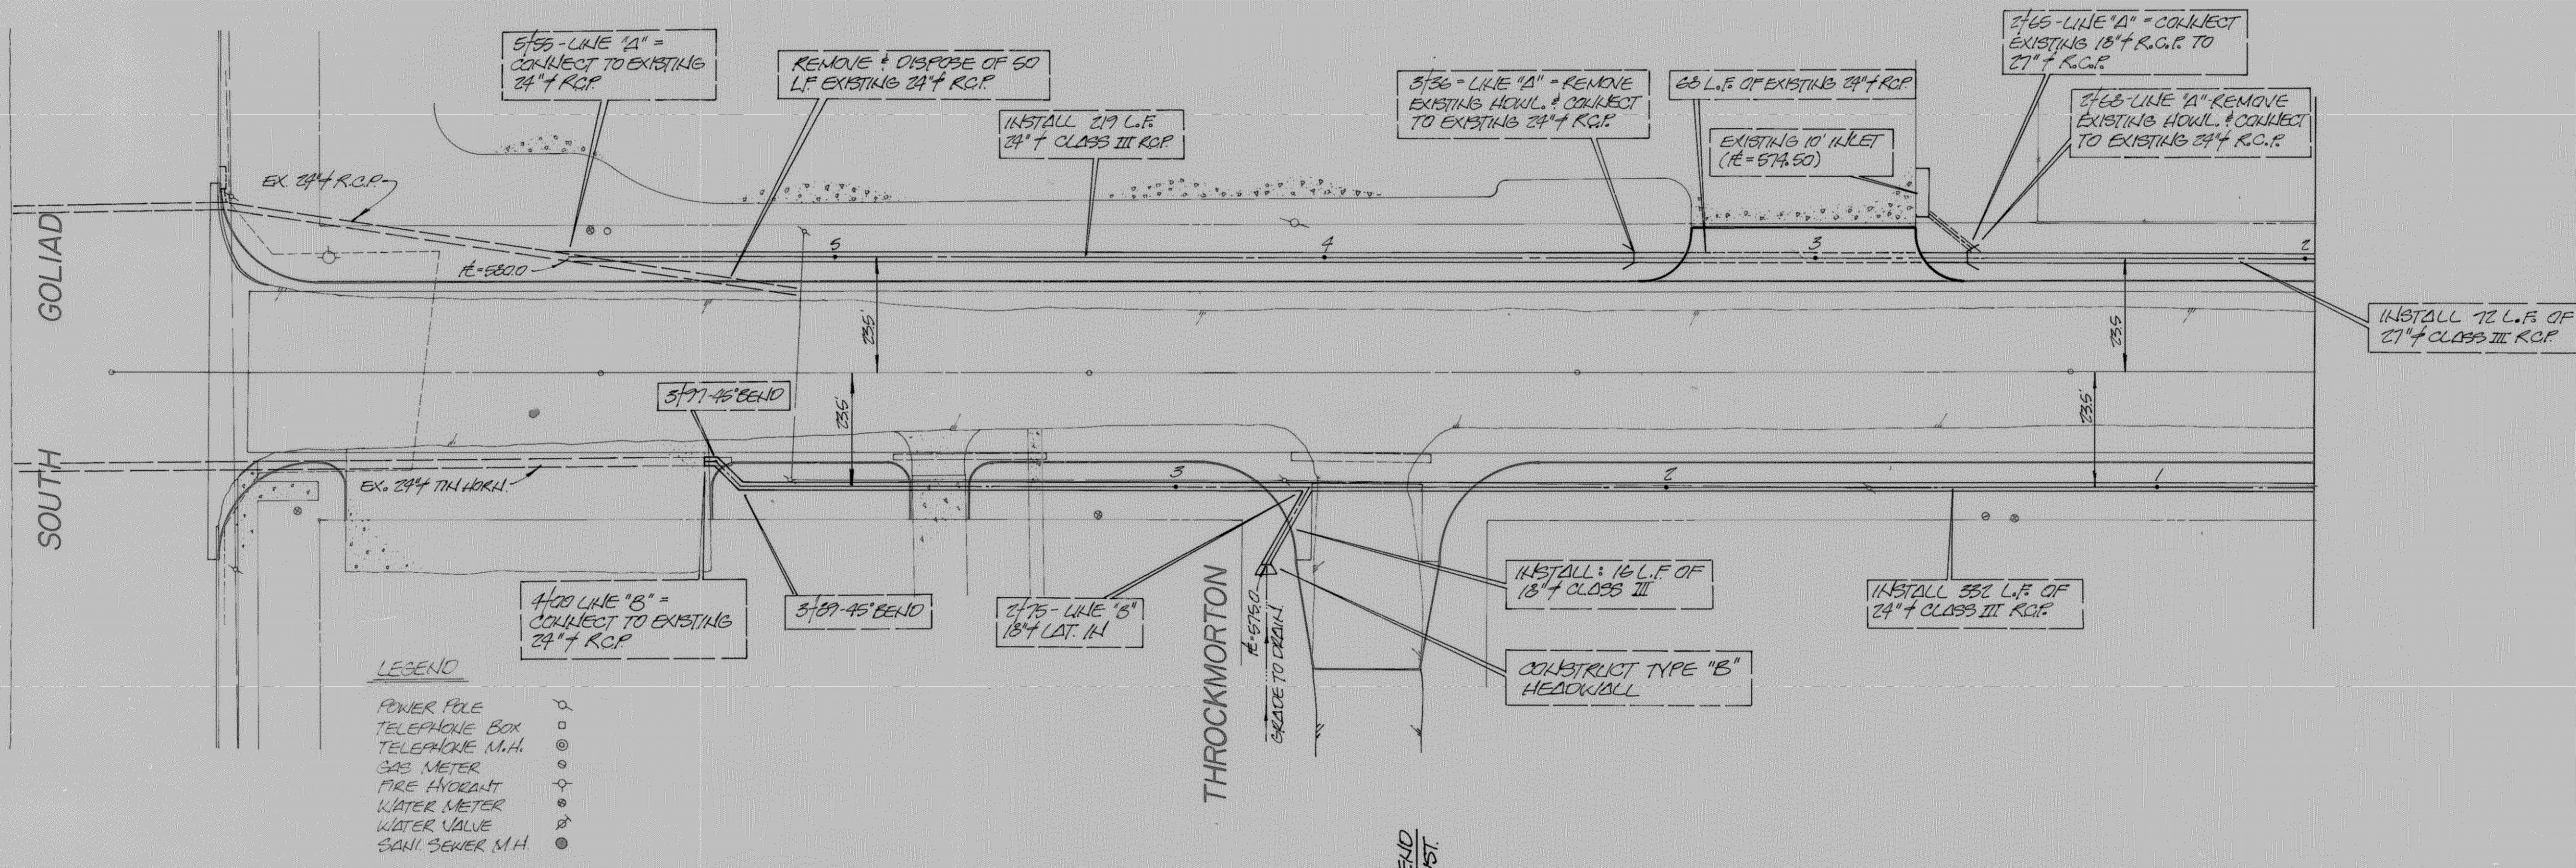

- LEGEND
- POWER POLE ○
 - TELEPHONE BOX □
 - TELEPHONE M.H. ⊙
 - 3AS METER ⊕
 - FIRE HYDRANT ⊕
 - WATER METER ⊕
 - WATER VALVE ⊕
 - SEWER M.H. ⊙

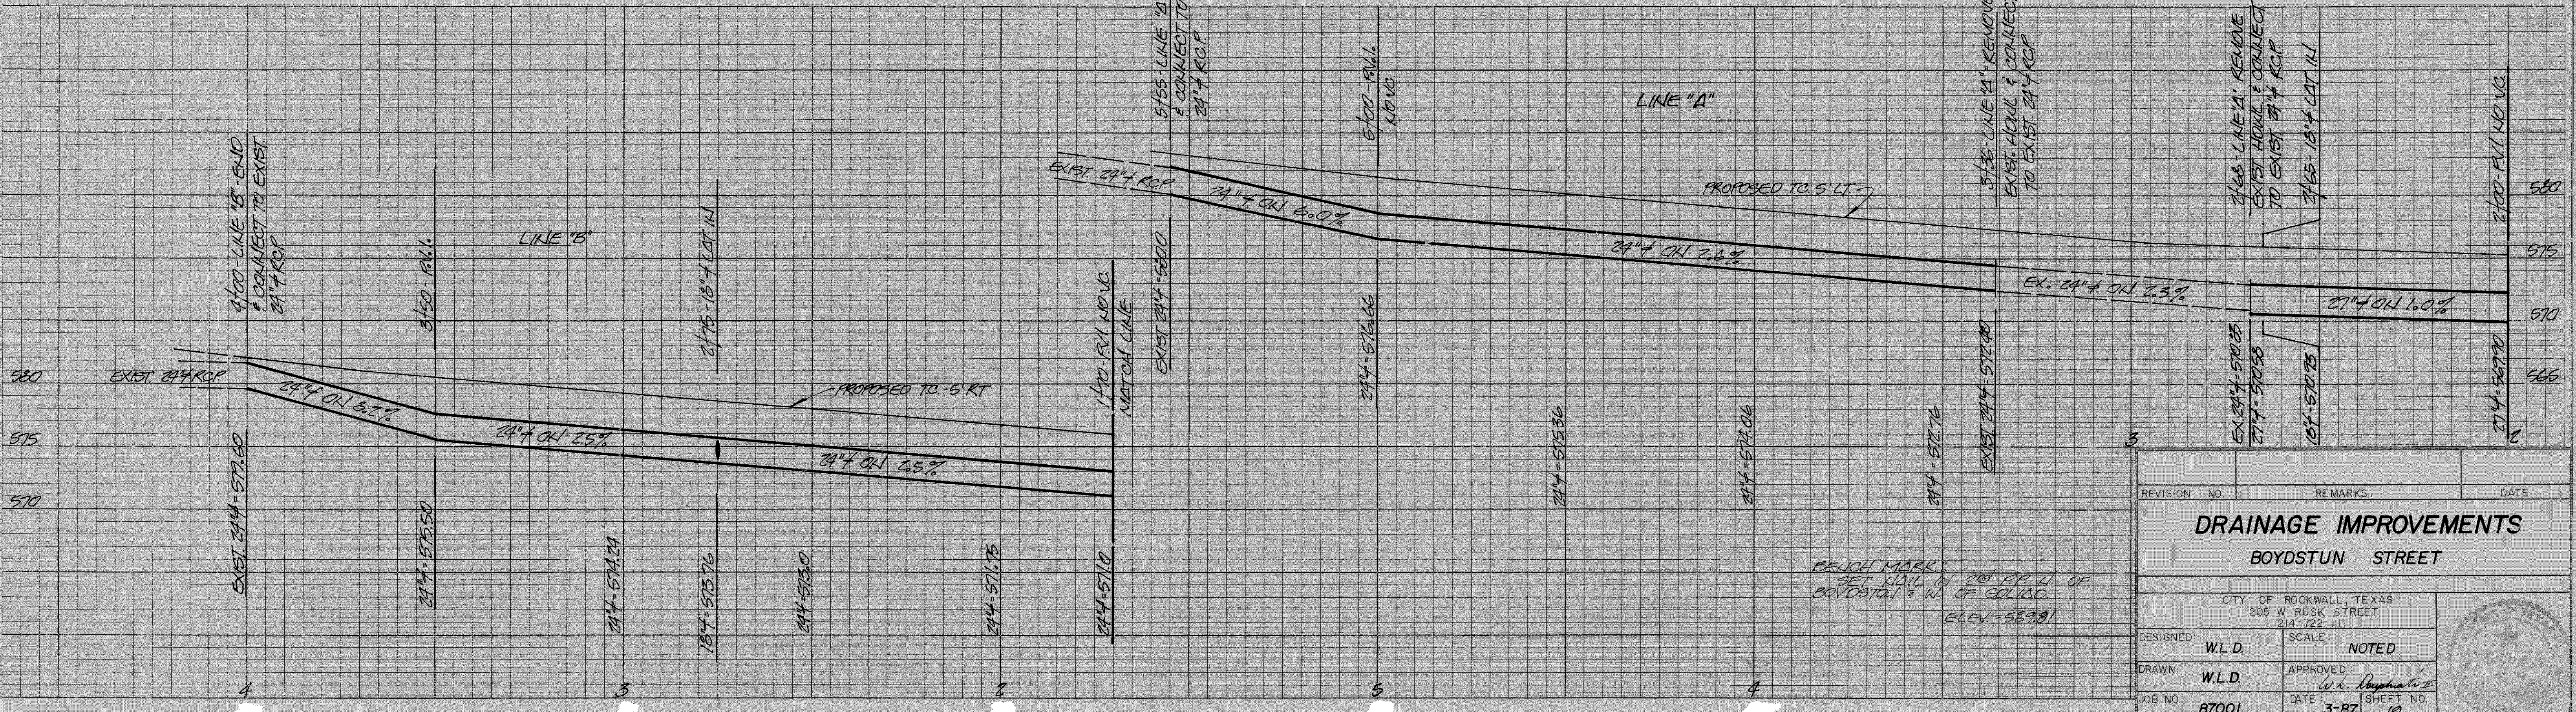

REVISION NO.	REMARKS	DATE
DRAINAGE IMPROVEMENTS BOYDSTUN STREET		
CITY OF ROCKWALL, TEXAS 205 W. RUSK STREET 214-722-1111		
DESIGNED: W.L.D.	SCALE: NOTED	
DRAWN: W.L.D.	APPROVED: <i>W.L. Boydston</i>	
JOB NO: 87001	DATE: 3-87	SHEET NO: 19

