
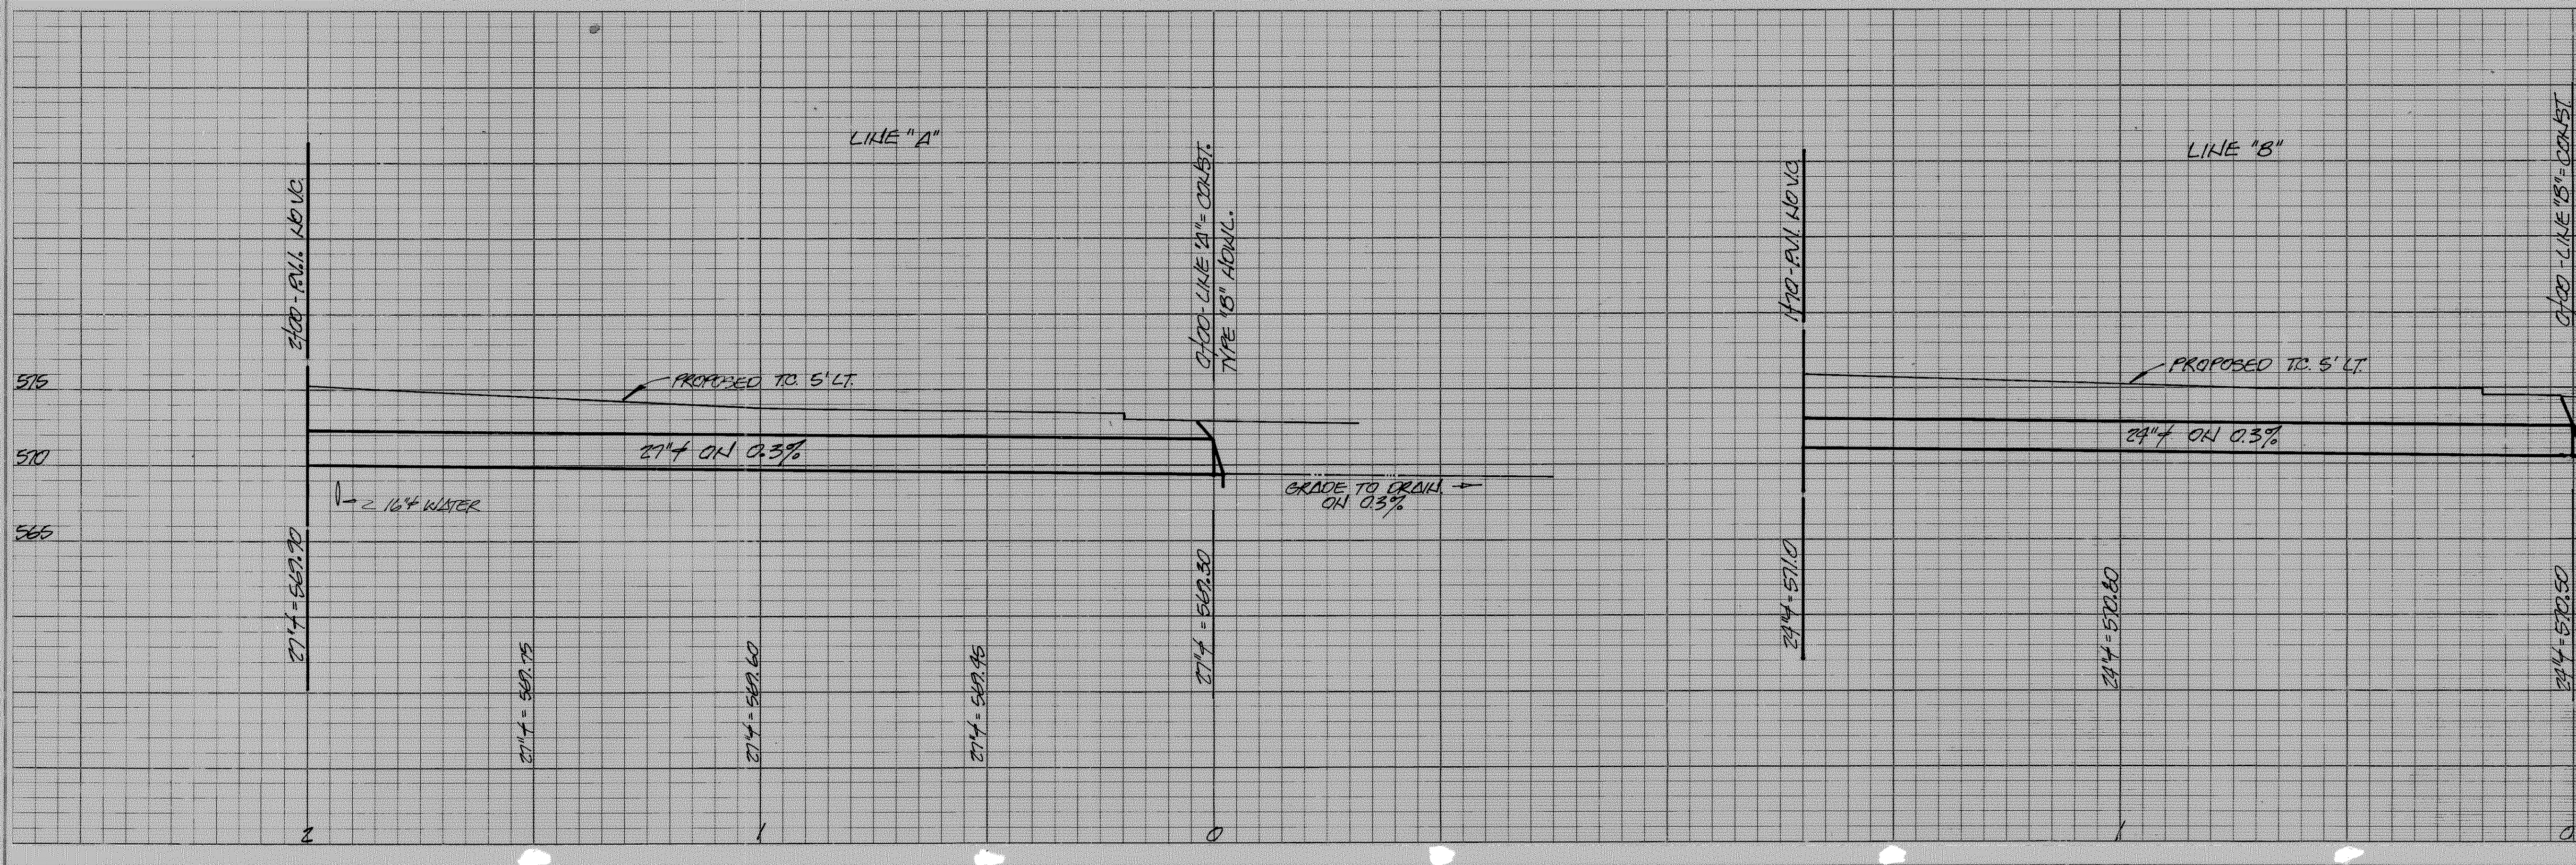


NOTE: CONTRACTOR TO REMOVE & REPLACE ALL EXIST WATER & SEWER SERVICES AS REQUIRED TO INSTALL STORM SEWER.

NOTE: ALL CONSTRUCTION TO CONFORM TO CITY OF ROCKWALL STANDARDS

NOTE: STORM SEWER PIPE TO BE CLASS III REINFORCED CONCRETE PIPE

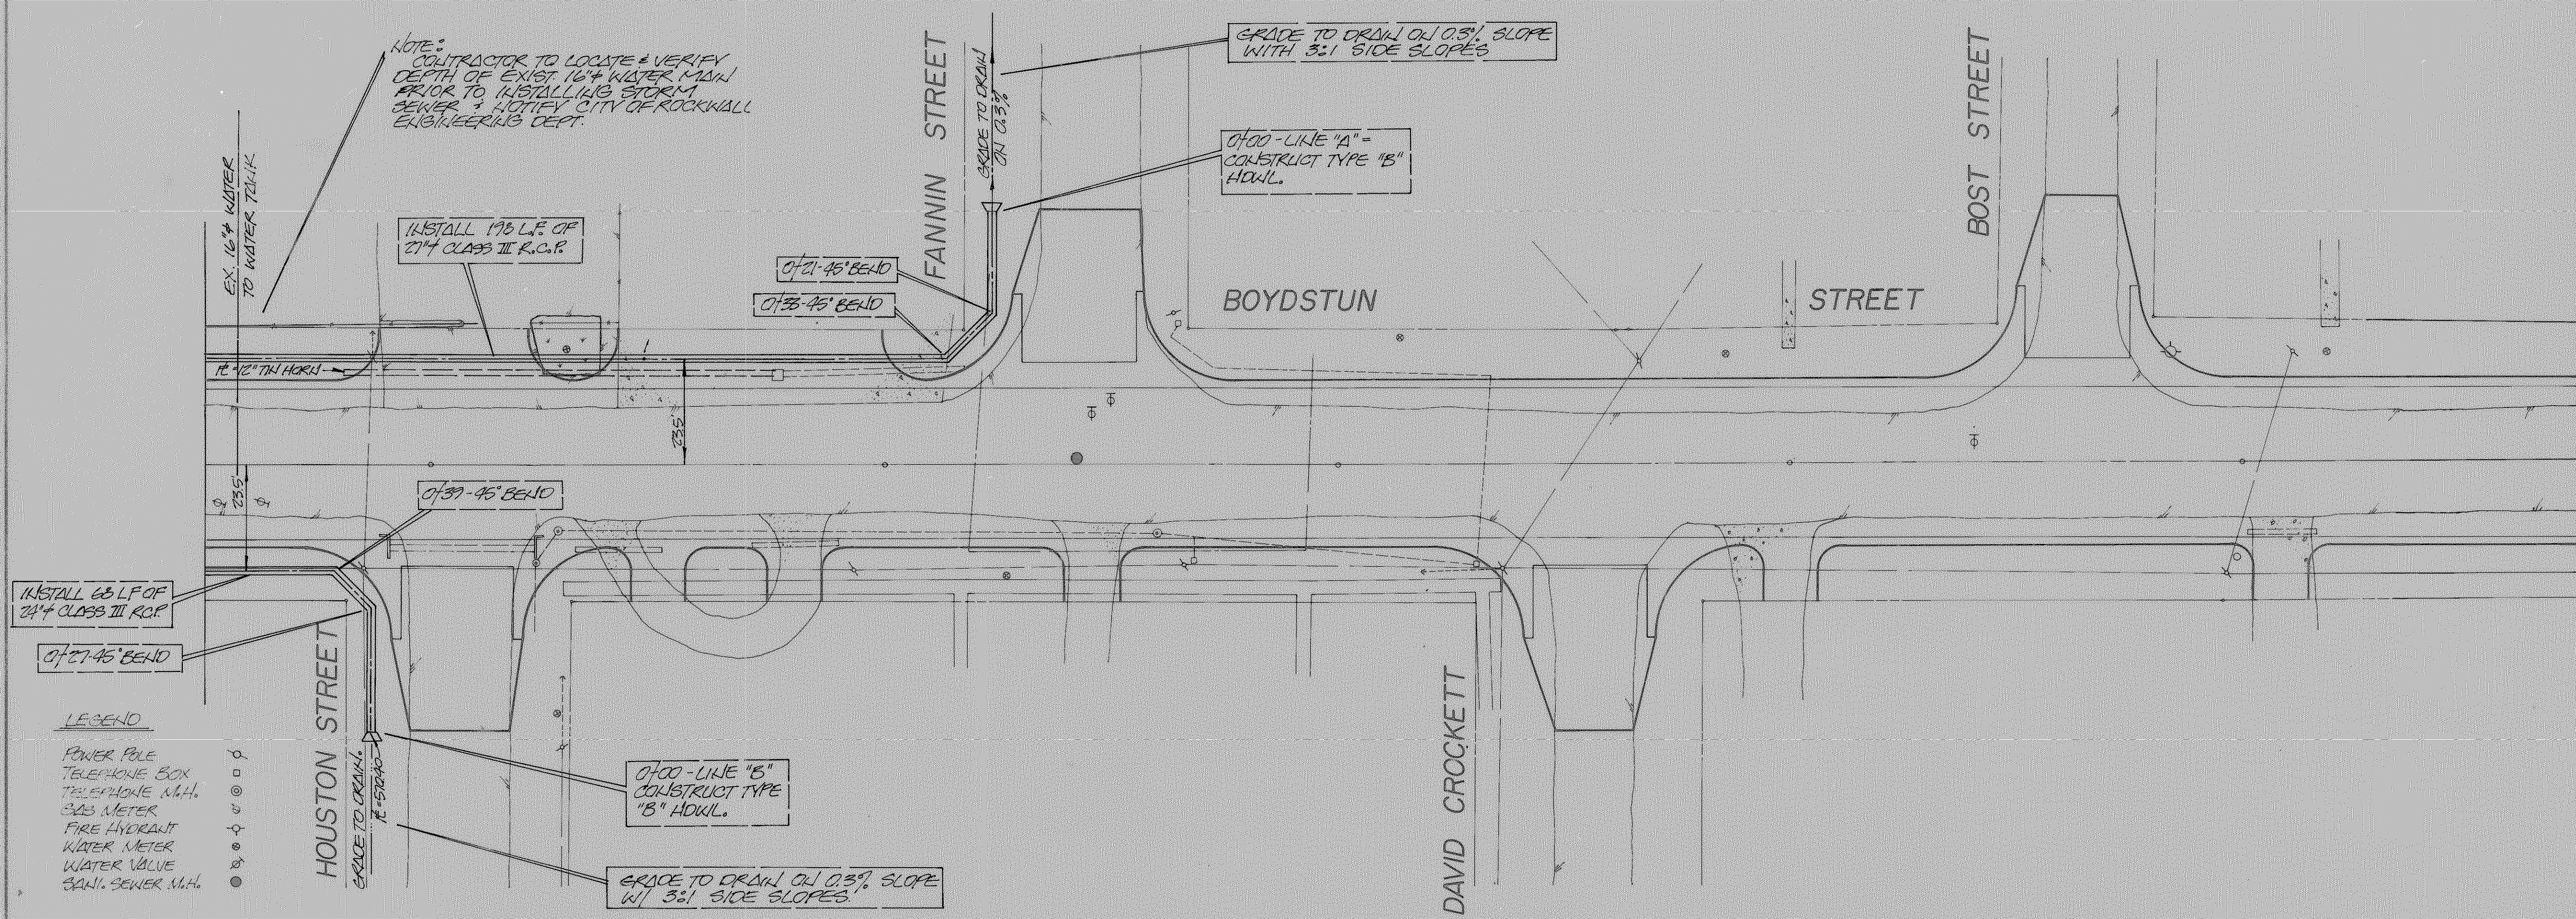

REVISION NO.	REMARKS	DATE

DRAINAGE IMPROVEMENTS
BOYDSTUN STREET

CITY OF ROCKWALL, TEXAS
205 W RUSK STREET
214-722-1111

DESIGNED: W.L.D.	SCALE: NOTED
DRAWN: W.L.D.	APPROVED: <i>W.L.D.</i>
JOB NO. 87001	DATE 3-87 SHEET NO. 20