



These plans and related specifications were prepared for construction of this specific project only. Reuse of these documents is not permitted without written authorization of Birkhoff, Hendricks, & Conway, L.L.P.

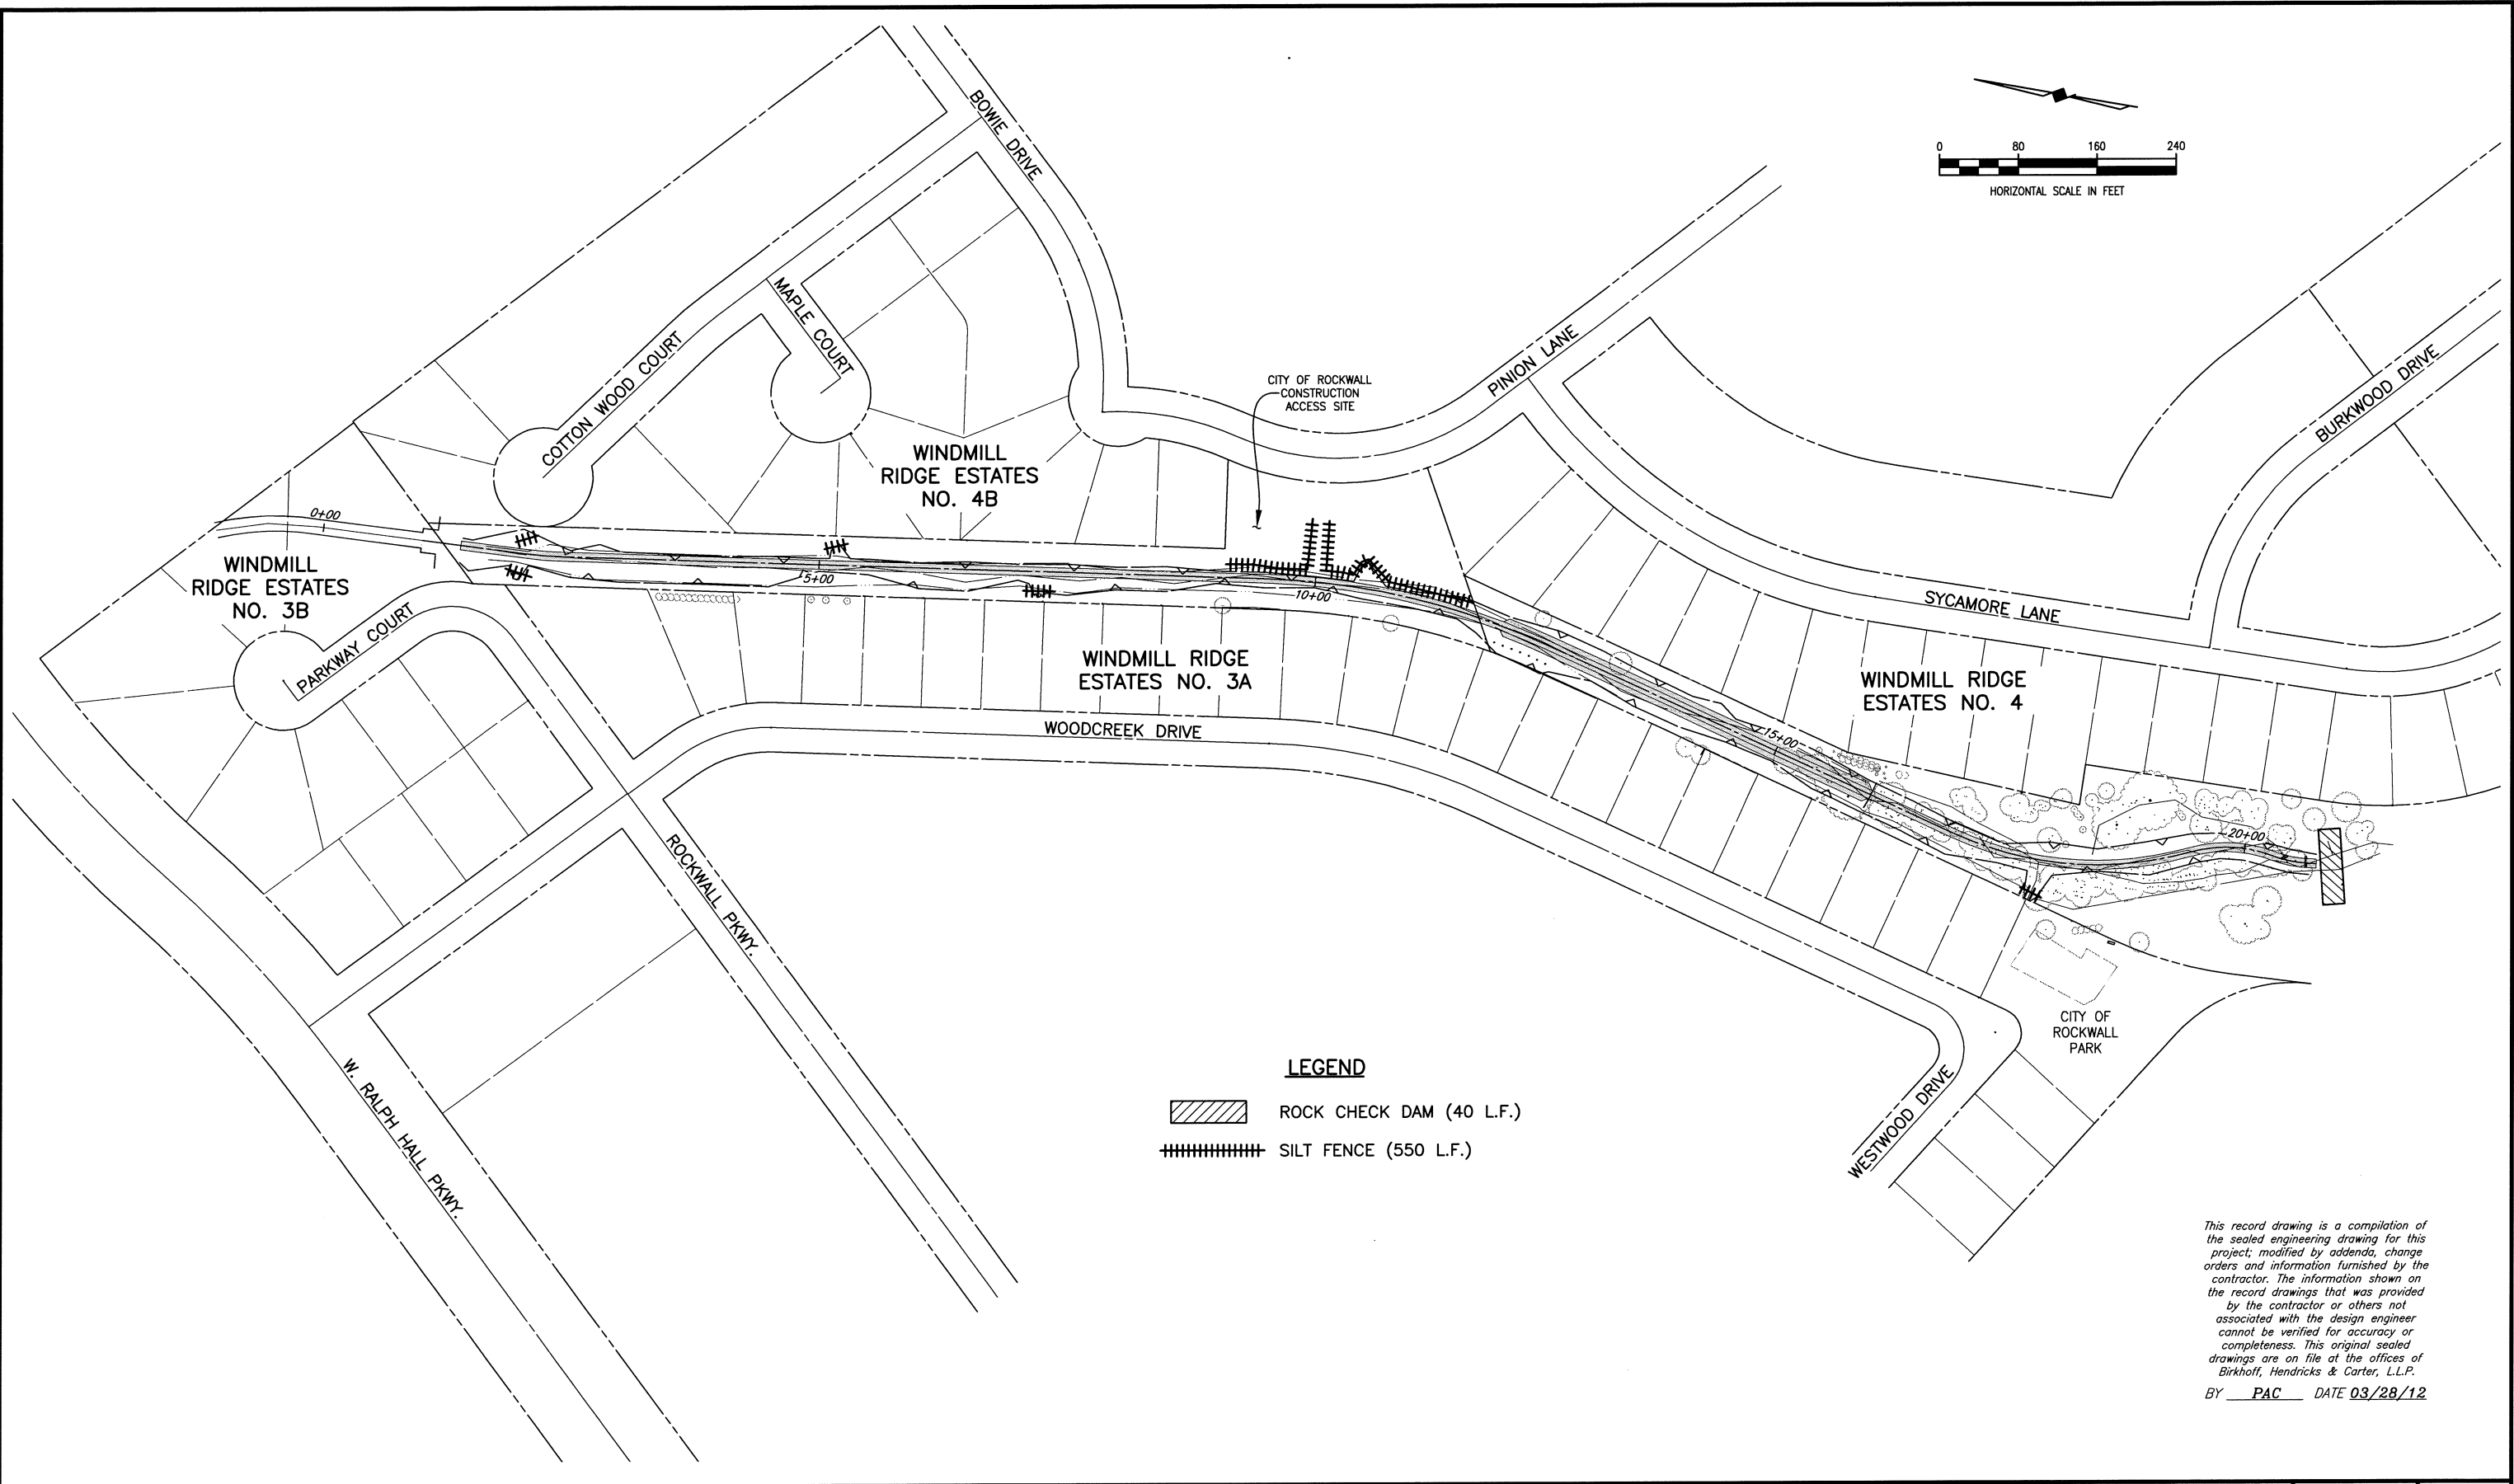


**BIRKHOFF, HENDRICKS & CARTER, L.L.P.**  
PROFESSIONAL ENGINEERS  
Texas Firm F526  
11910 Greenville Ave., Suite 600  
Dallas, Texas 75243 (214) 361-7900

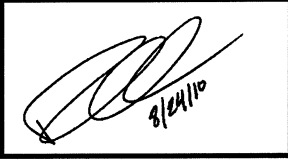

**CITY OF ROCKWALL, TEXAS**  
BROCKWAY BRANCH IMPROVEMENTS  
EROSION CONTROL PLAN

BHC  
PROJECT NO.  
2007-153  
AUGUST 2010

SHEET NO.  
**20**