
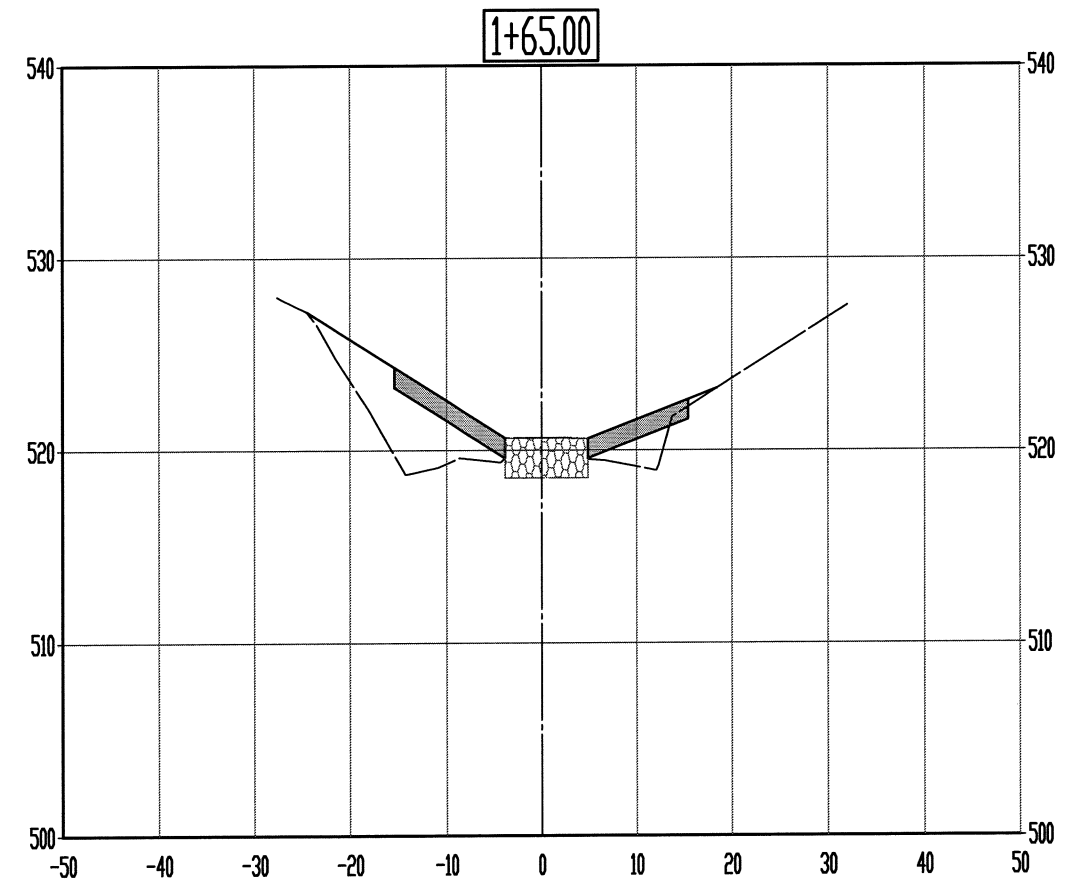
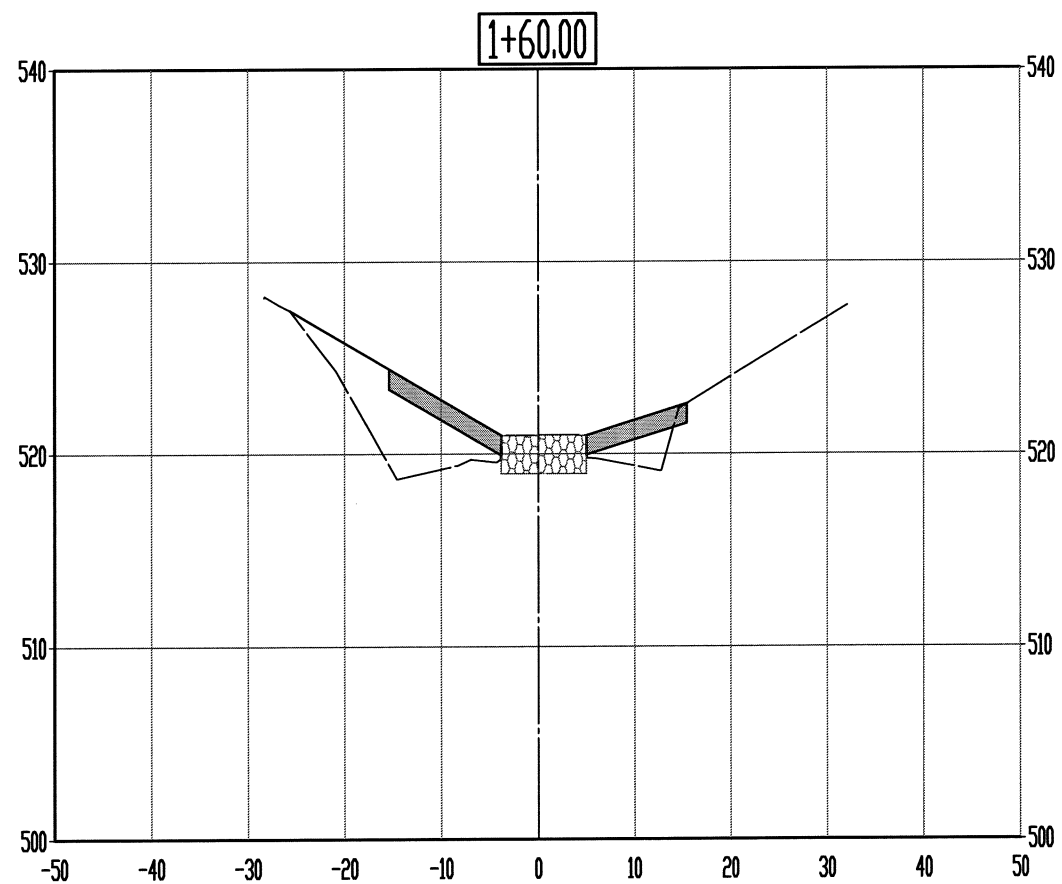
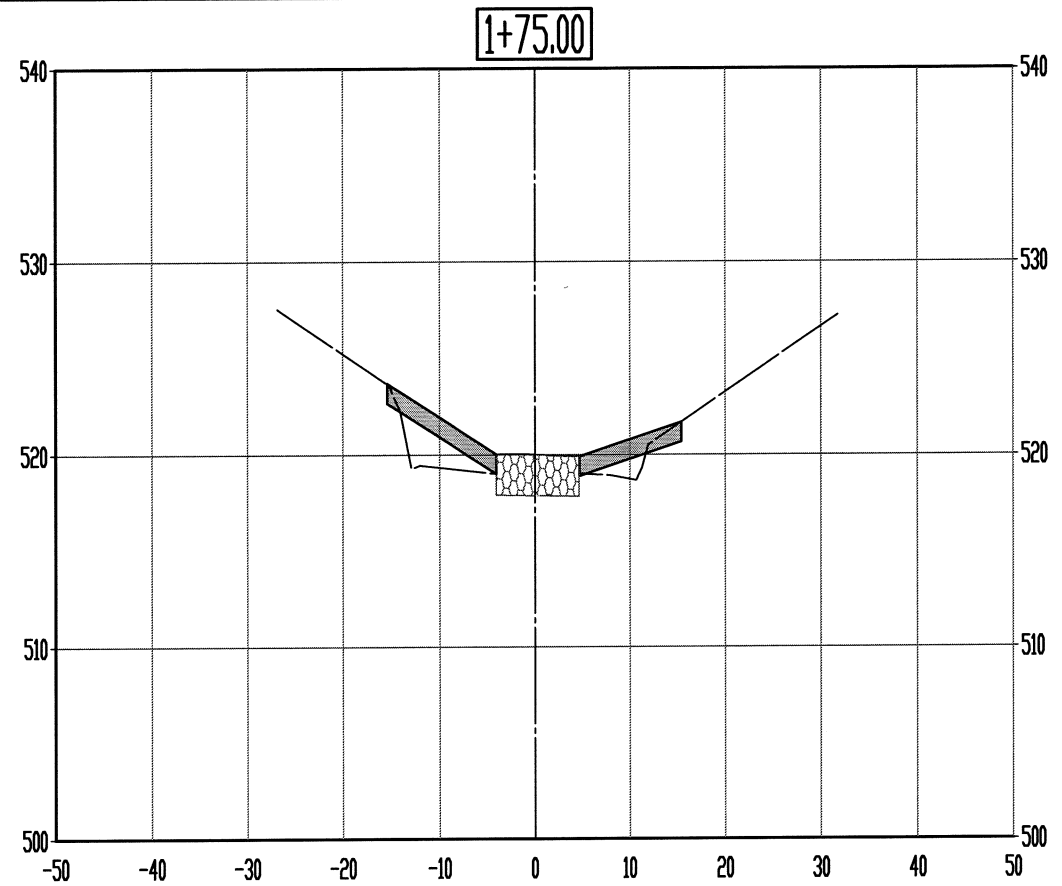



These plans and related specifications were prepared for construction of this specific project only. Reuse of these documents is not permitted without written authorization of Birkhoff, Hendricks, & Carter, L.L.P.

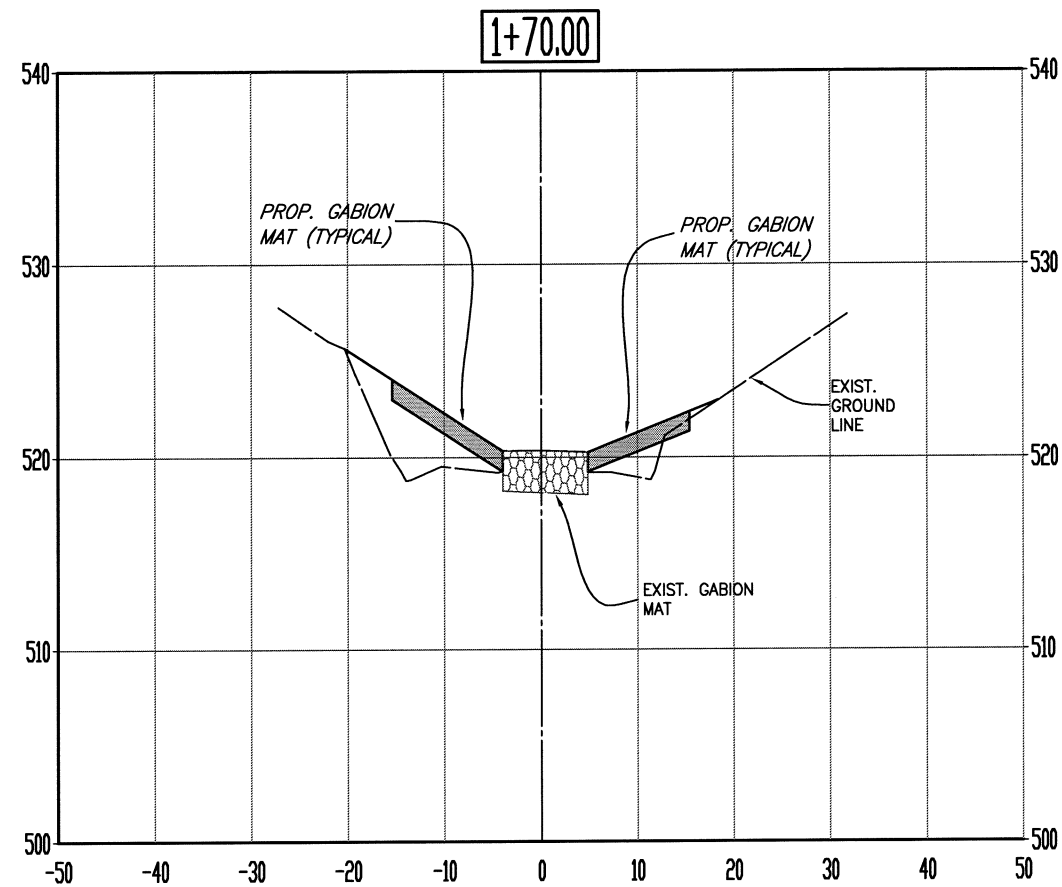

This record drawing is a compilation of the sealed engineering drawing for this project, modified by addenda, change orders and information furnished by the contractor. The information shown on the record drawings that was provided by the contractor or others not associated with the design engineer cannot be verified for accuracy or completeness. This original sealed drawings are on file at the offices of Birkhoff, Hendricks & Carter, L.L.P.

BY PAC DATE 03/28/12

**BIRKHOFF, HENDRICKS & CARTER, L.L.P.**  
PROFESSIONAL ENGINEERS  
Texas Firm F526  
11910 Greenville Ave., Suite 600  
Dallas, Texas 75243 (214) 361-7900

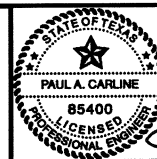

**CITY OF ROCKWALL, TEXAS**  
BROCKWAY BRANCH IMPROVEMENTS  
CROSS SECTIONS

BHC  
PROJECT NO.  
2007-153  
March, 2012

SHEET NO.  
**23**

FIELD CHANGE NO. 1 (2/6/2012)

REVISED: 3/27/12 - TGULLACE

H:\Projects\Rockwall\2007153 Squabble-Brockway Branch\Basedwgs\Gion-Xsection\X-Sect 1+40-Sta 1+80.dwg

PLOT SCALE: 1:1

PLOT STYLE: 34x22.ctb

PLOTTED BY: TGULLACE ON 3/27/2012