
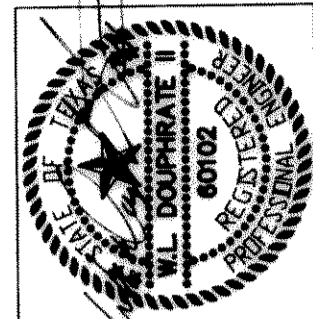


NOTE: CONTRACTOR SHALL BE RESPONSIBLE FOR CLEARING AND REMOVAL OF TREES IN THE DESIGNATED EASEMENT.

NOTE: CONTRACTOR TO VERIFY IN THE FIELD THE LOCATION OF ALL EXISTING UTILITIES PRIOR TO CONSTRUCTION. INFORMATION PROVIDED WITHIN THESE PLANS DOES NOT RELIEVE THE CONTRACTOR OF THE FULL AND TOTAL RESPONSIBILITY FOR THE PROTECTION OF EXISTING UTILITIES NOR ANY DAMAGES CAUSED BY SAID CONTRACTOR DURING CONSTRUCTION.

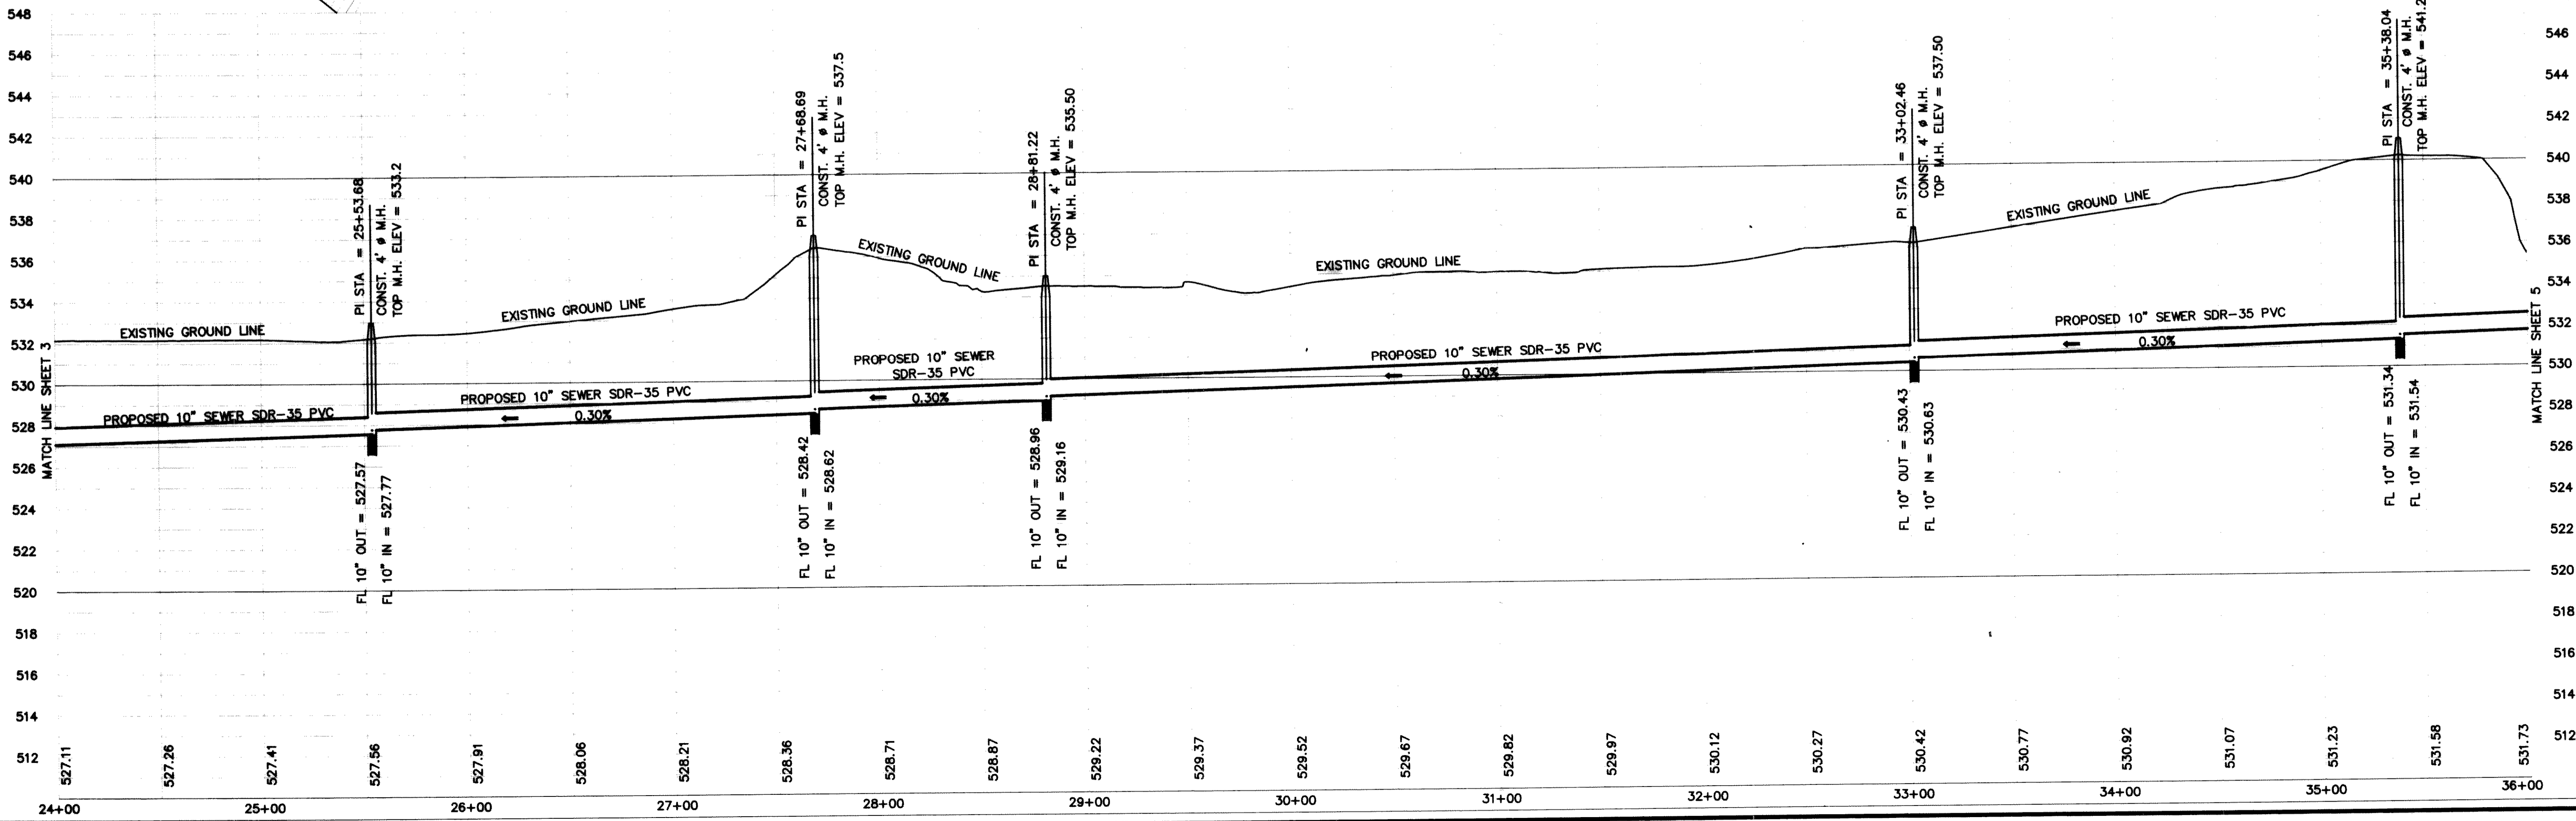

THE SEAL APPEARING ON THIS DOCUMENT WAS AUTHORIZED BY W.L. DOUPHRATE II TEXAS P.E. NO. 80102 ON 7/19/97

**DOUPHRATE & ASSOCIATES**  
 ENGINEERING - SURVEYING - CONSTRUCTION MANAGEMENT  
 P.O. BOX 1336 ROCKWALL, TEXAS 75087  
 PHONE: (972)771-9004 FAX: (972)771-9005

**BUFFALO CREEK SEWER EXTENSION**  
**CITY OF ROCKWALL**  
**ROCKWALL COUNTY, TEXAS**

REVISION  
 W.L.D.  
 CHECKED  
 KEB  
 DRAWN  
 7/19/97  
 DATE  
 9008PP03  
 PROJECT