


NOTE:
8" PREPARED SUBGRADE, COMPACTED TO AT LEAST 95% STANDARD PROCTOR DENSITY AT NOT LESS THAN OPTIMUM MOISTURE

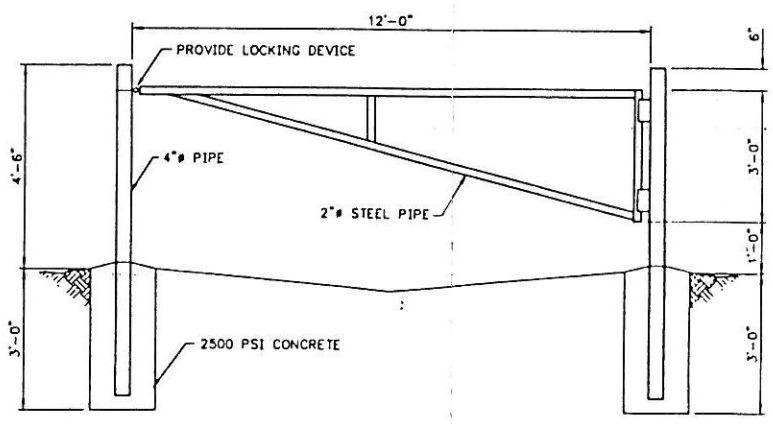

- NOTES:
1. ALL AREA INSIDE SECURITY FENCE NOT COVERED BY CONCRETE SLAB, SHALL BE SCARIFIED AND COVERED WITH GRAVEL.
 2. GRAVEL ACCESS ROAD SHALL EXTEND TO MATCH CONCRETE SLAB INSIDE SECURITY FENCE.
 3. ACCESS GATE SHALL BE INSTALLED TO BE IN-LINE WITH EXISTING PRIVACY FENCE.

No.	Date	Revisions	App.

THE SEAL APPEARING ON THIS DOCUMENT WAS AUTHORIZED BY C.F. RASOR, P.E. NO. 28188 ON OCTOBER 31st, 1994

Chiang, Patel and Associates, Inc.
Consulting Engineers & Planners • Project Managers
Dallas, Texas



CITY OF ROCKWALL
"THE NEW HORIZON"



CHANDLERS DEEP LIFT STATION
AND FORCE MAIN MODIFICATIONS
SITE PLAN

Scale: 1" = 20'	Date: 9/7/94
Designed by: J.A. MARLER	
Drawn by: G.W. JOHNSON	
Checked by: E.M. MOTLEY	
Approved by: C.F. RASOR	
Project No.: CR09471.2	