

PLOTTED BY: DSmith ON 11/30/2012

PLOT STYLE: 11x17.ctb


H:\Projects\Rockwall\2009115\Sheets\RECORD DWG\2009115-Cov.dwg

REVISED: 11/29/12 - DSmith

CITY OF ROCKWALL, TEXAS

CONSTRUCTION PLANS FOR:

CHANDLERS DEEP LIFT STATION IMPROVEMENTS

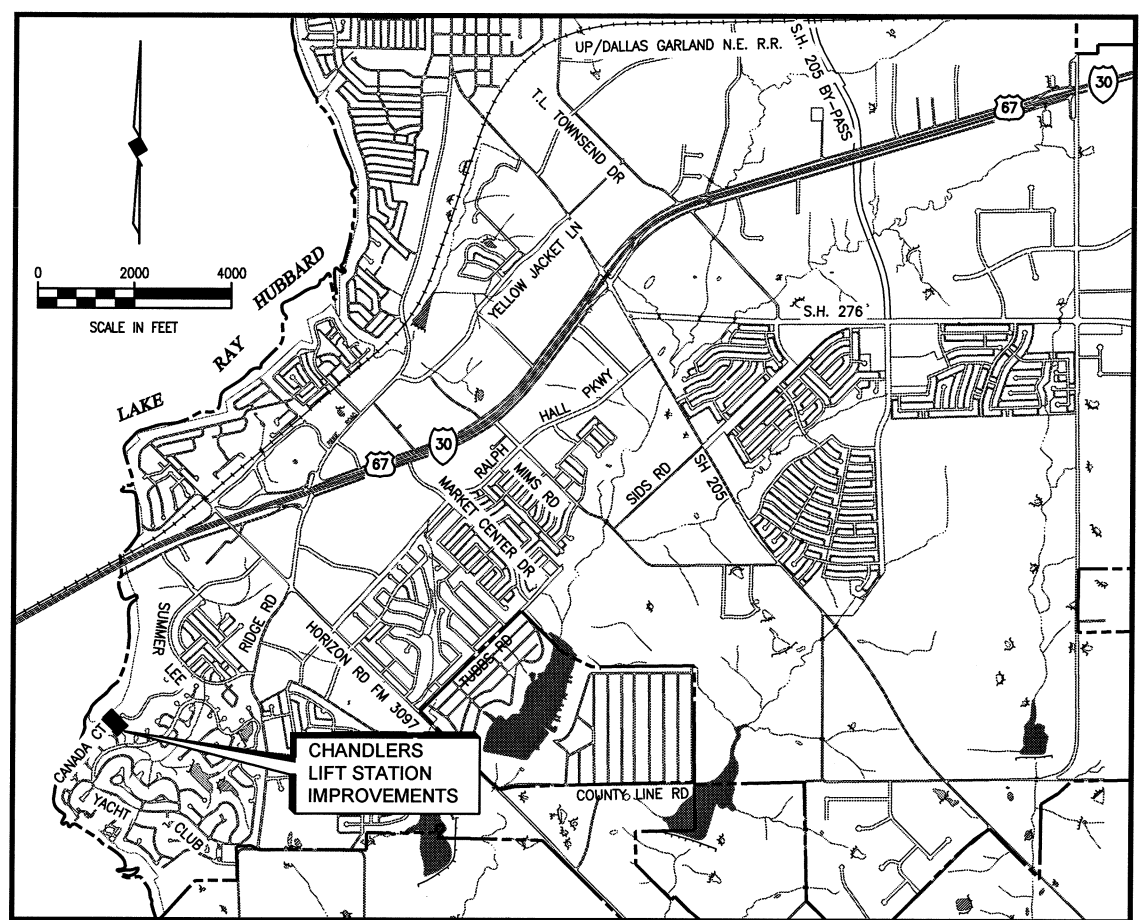

LOCATION MAP

COUNCIL MEMBERS

- DAVID SWEET, MAYOR
- DAVID WHITE
- MARK RUSSO, MAYOR PRO-TEM
- BENNIE DANIELS
- CLIFF SEVIER
- MICHELLE SMITH
- MARGO NIELSEN

CITY MANAGER


JULIE COUCH

ASSISTANT CITY MANAGER

RICHARD CROWLEY

CITY ENGINEER

CHUCK TODD, P.E.

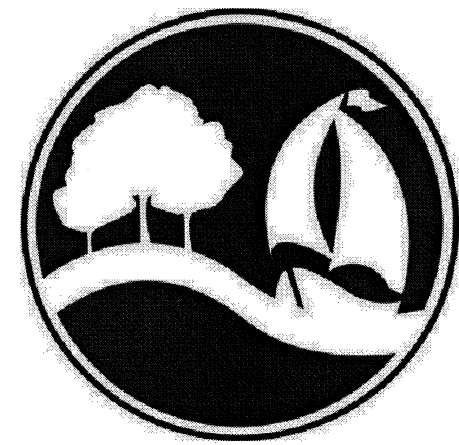

BIRKHOFF, HENDRICKS & CARTER, L.L.P.
 PROFESSIONAL ENGINEERS
 Texas Firm 526
 Dallas, Texas

SEPTEMBER 2011

SHEET INDEX

<u>SHEET NO.</u>	<u>SHEET DESCRIPTION</u>
1	COVER SHEET AND LOCATION MAP
2	GENERAL NOTES
3	SITE PLAN
4	LIFT STATION PLAN & SECTION
5	MISCELLANEOUS DETAILS
6	ELECTRICAL SITE PLAN
7	ELECTRICAL ONE LINE DIAGRAM
8	ELECTRICAL CONTROL SCHEMATICS
9	ELECTRICAL DETAILS
10	ELECTRICAL DETAILS

This record drawing is a compilation of the sealed engineering drawing for this project, modified by addenda, change orders and information furnished by the contractor. The information shown on the record drawings that was provided by the contractor or others not associated with the design engineer cannot be verified for accuracy or completeness. This original sealed drawings are on file at the offices of Birkhoff, Hendricks & Carter, L.L.P.
 BY PAC DATE 11/30/12