

REVISIONS: 1/18/07 - MOLDHAM  
PLOT SCALE: 1:1  
PLOT STYLE: 22X34.ctb  
PLOTTED BY: MOLDHAM ON 1/18/2007  
H:\Projects\Rockwall\2006\01\temp-RECORD\2006101-00-Cover.dwg

# CITY OF ROCKWALL, TEXAS

## CONSTRUCTION PLANS FOR:

### CHANDLERS MARINA LIFT STATION

### REHABILITATION

#### COUNCIL MEMBERS

BILL CECIL, MAYOR  
BOB COTTI, MAYOR PRO-TEM  
STEPHEN STRAUGHAN  
JOHN KING  
TIM McCALLUM  
MATT SCOTT  
MARGO NIELSON

#### CITY MANAGER


JULIE COUCH

#### ASSISTANT CITY MANAGER

RICHARD CROWLEY



#### CITY ENGINEER

CHUCK TODD, P.E.

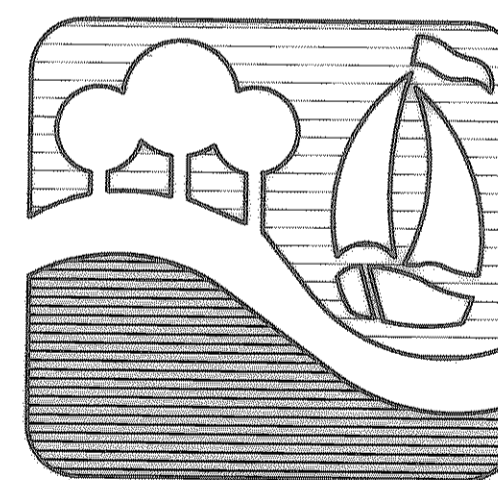

BIRKHOFF, HENDRICKS & CONWAY, L.L.P.  
CONSULTING ENGINEERS  
Dallas, Texas

APRIL 2006

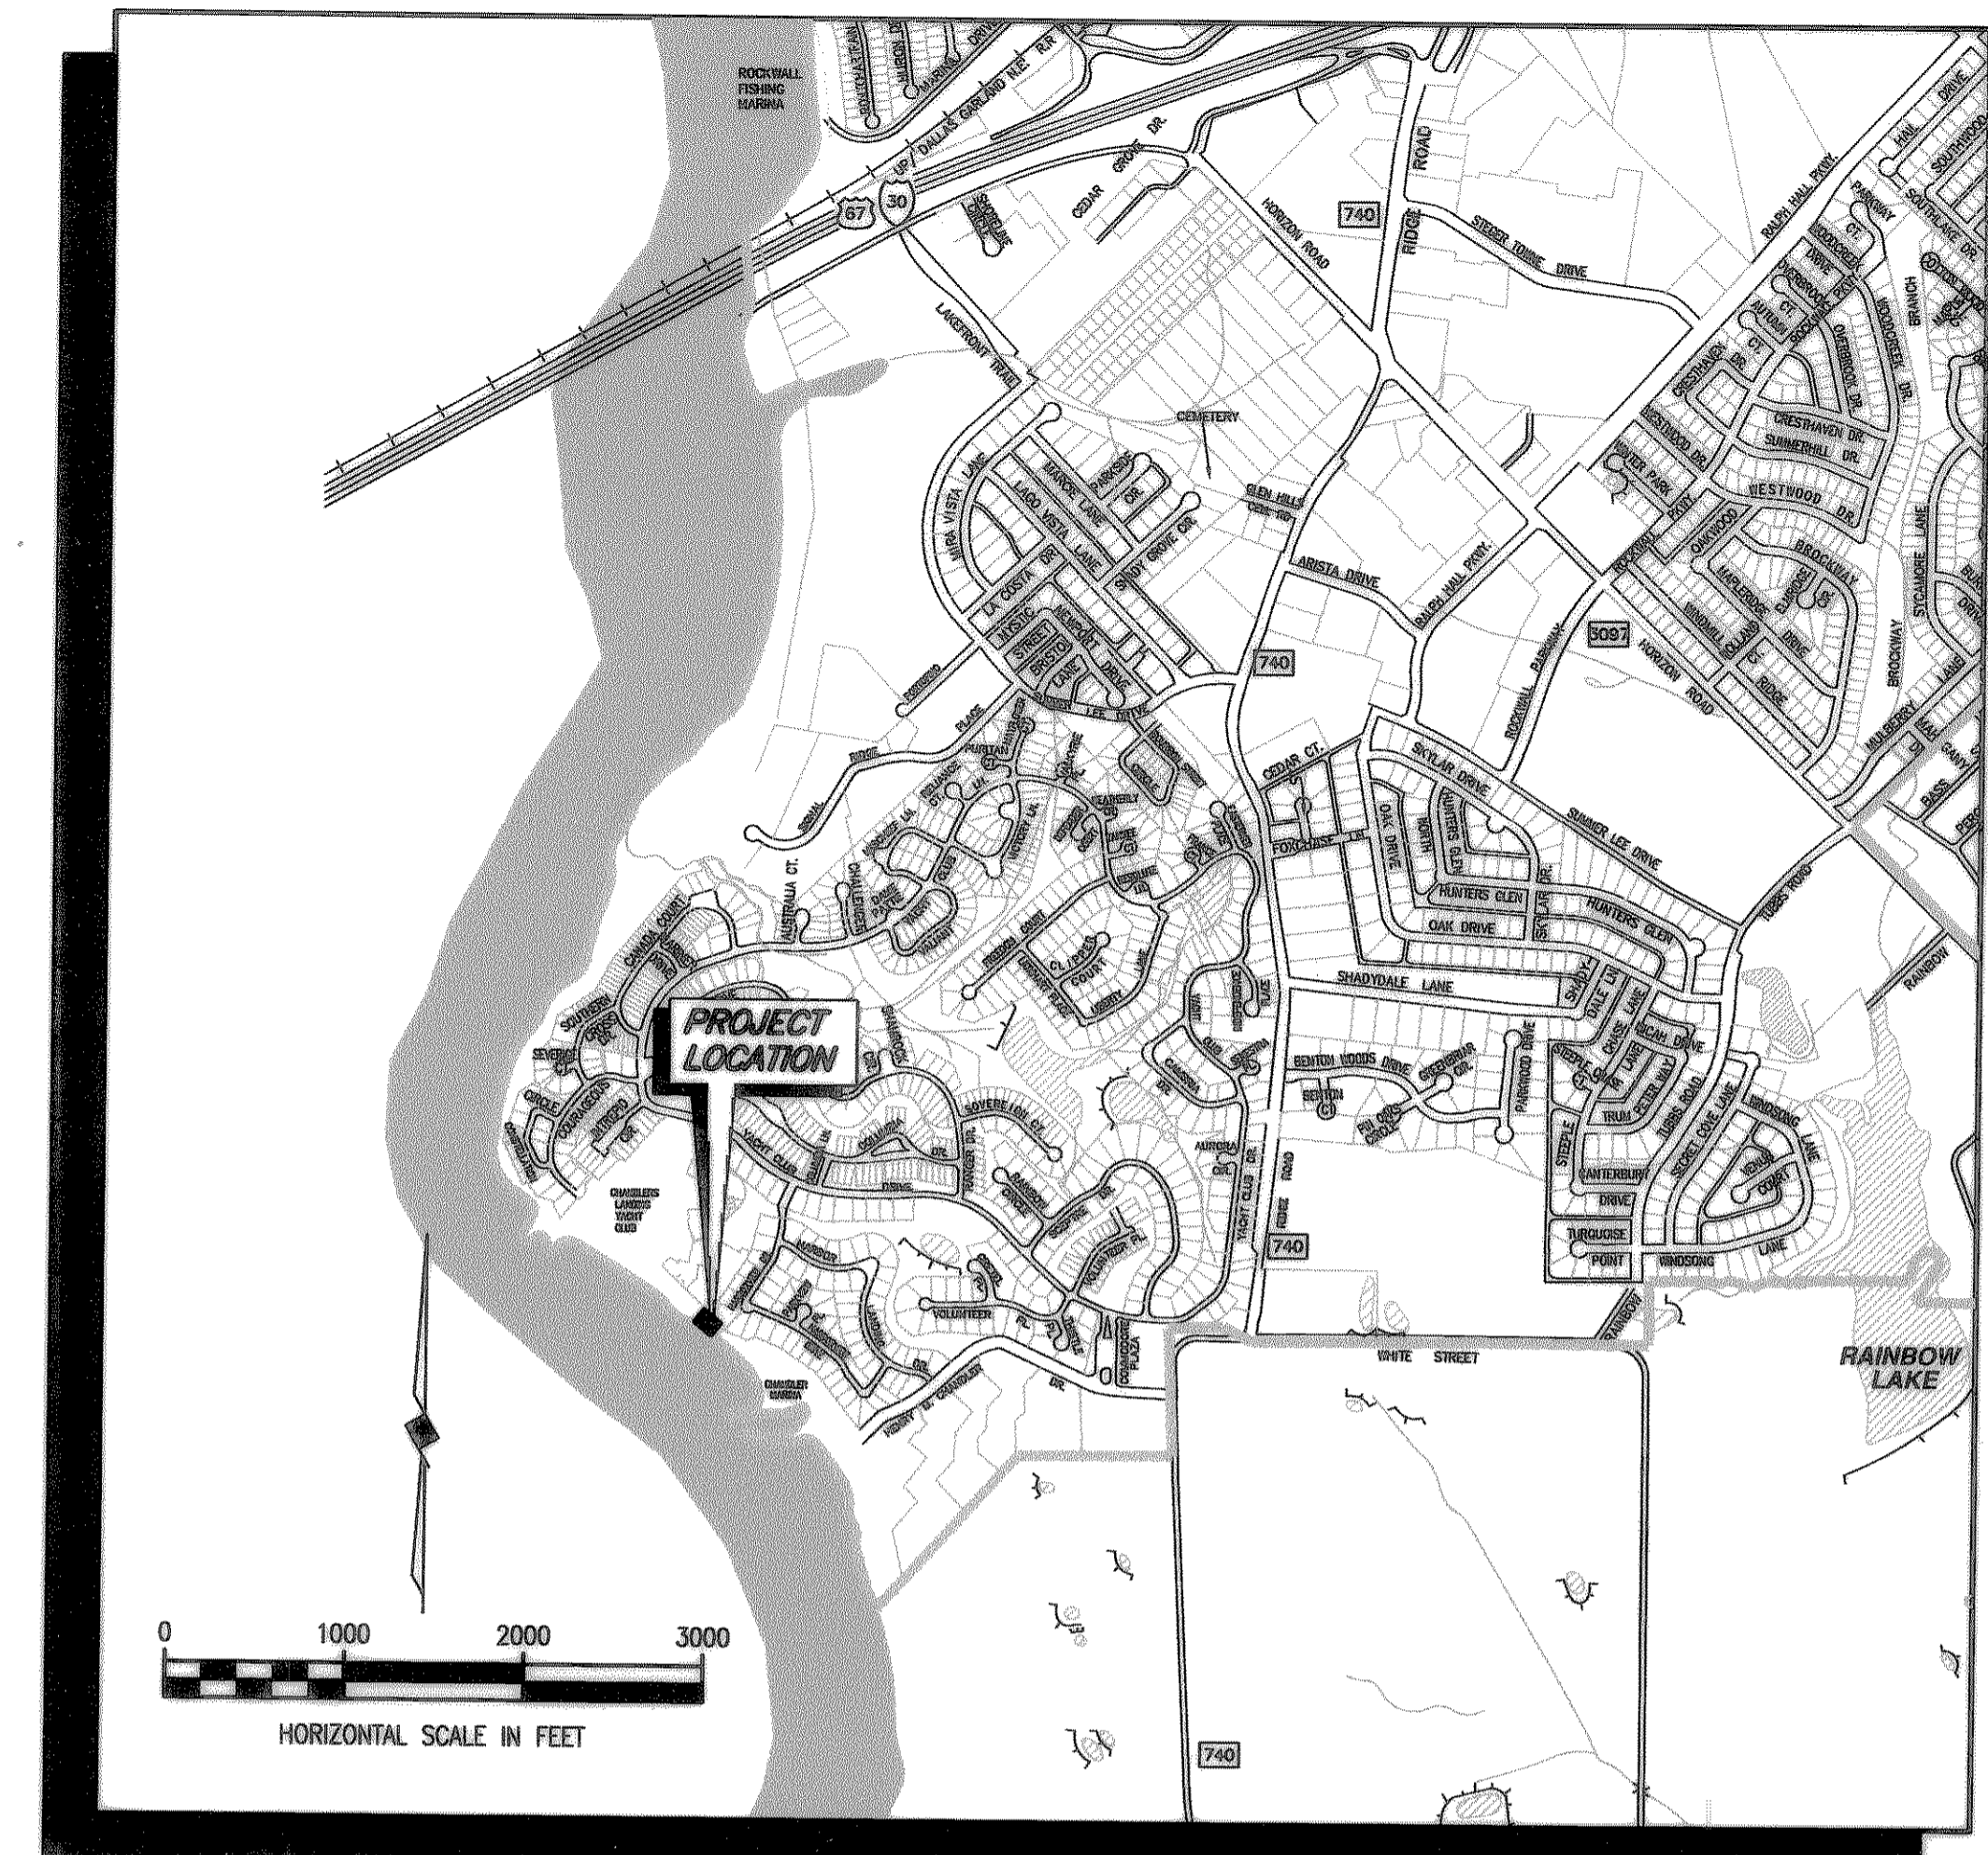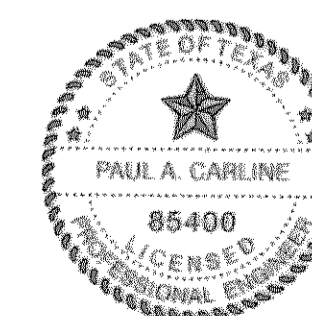

LOCATION MAP

#### SHEET INDEX

<u>SHEET NO.</u>	<u>SHEET DESCRIPTION</u>
-	COVER SHEET
1	SITE PLAN
2	EXISTING LIFT STATION DEMOLITION PLAN
3	LIFT STATION REHABILITATION PLAN
4	DETAILS

THESE DOCUMENTS ARE FOR  
BIDDING, CONSTRUCTION,  
AND PERMIT PURPOSES.

DATE: 4/19/06

*This record drawing is a compilation of the sealed engineering drawing for this project; modified by addenda, change orders and information furnished by the contractor. The information shown on the record drawings that was provided by the contractor or others not associated with the design engineer cannot be verified for accuracy or completeness. This original sealed drawings are on file at the offices of Birkhoff, Hendricks & Conway, L.L.P.*

BY PAC DATE 1/17/07