


NOTES:

- CONTRACTOR SHALL COMBINE I/O BASES TO ALLOW FUTURE INSTALLATION OF AT LEAST ONE PLC BASE.
- LAYOUT IS GIVEN FOR INFORMATIONAL PURPOSES ONLY. CONTRACTOR IS FULLY RESPONSIBLE FOR I/C FUNCTIONALITY REGARDLESS OF SHOWN COMPONENTS.

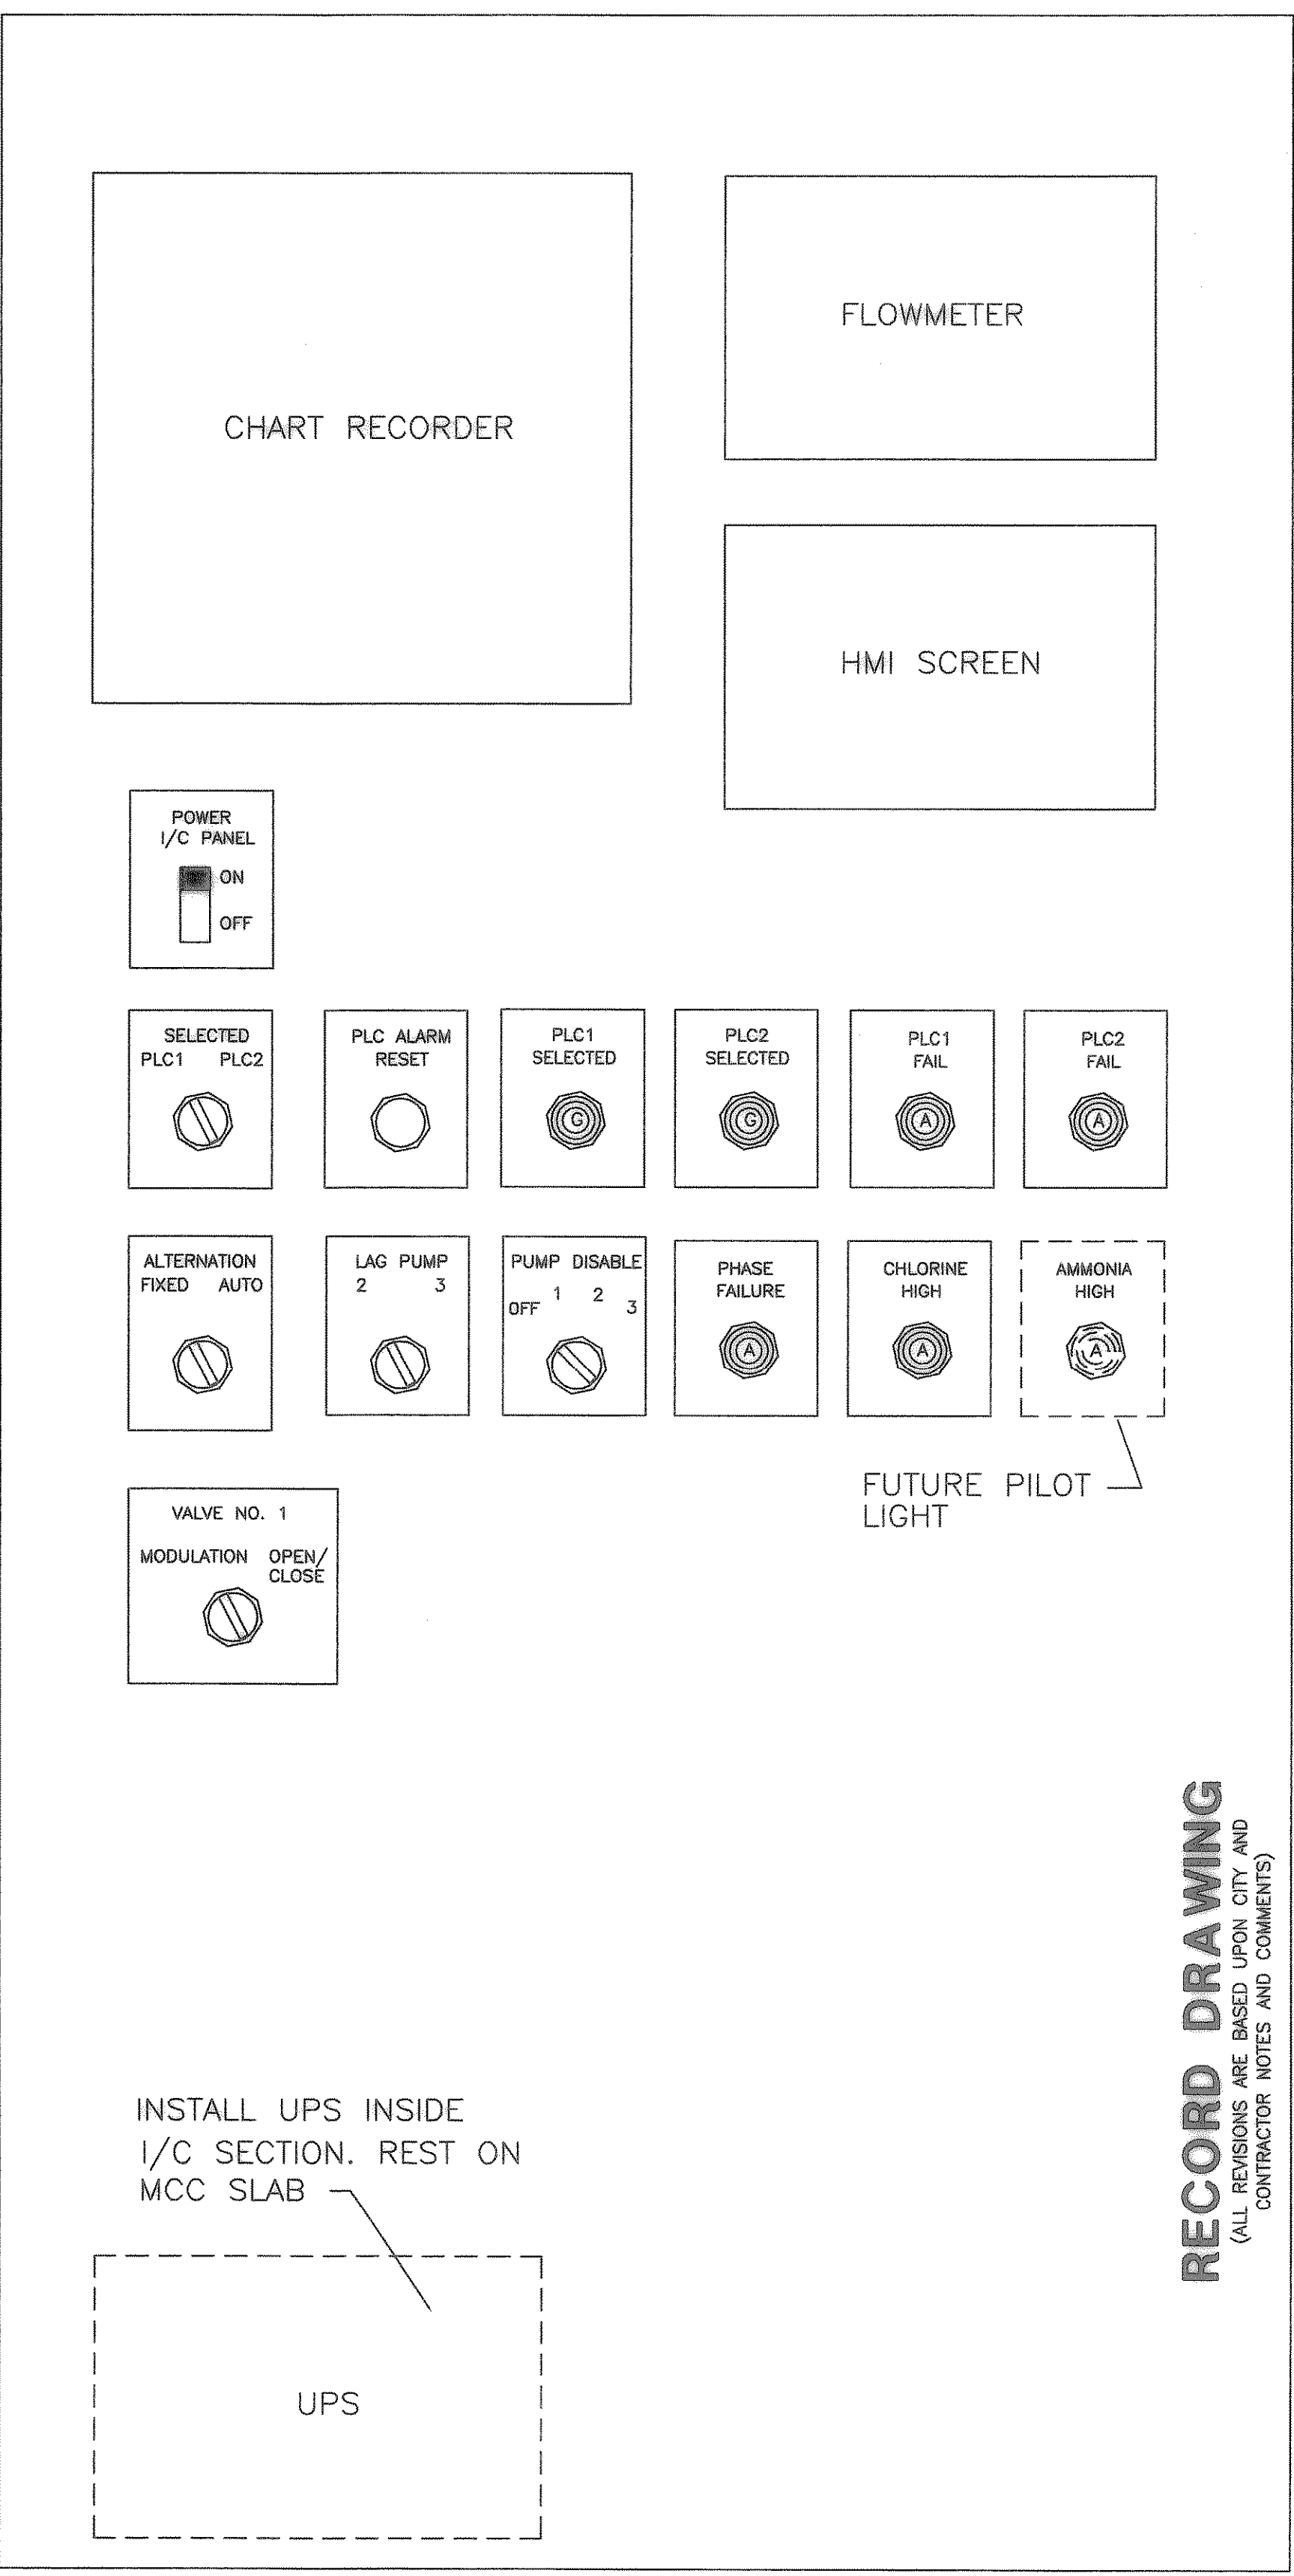

RECORD DRAWING
(ALL REVISIONS ARE BASED UPON CITY AND CONTRACTOR NOTES AND COMMENTS)

BY	DL
REVISION	AS BUILT MODIFICATION
No.	DATE
1	1/05/05

FREEMAN-MILLICAN, Inc.
ENGINEERS - ARCHITECTS - PLANNERS
9500 FOREST LN. DALLAS, TX 75244-5035

CITY OF HEATH
WATER PUMP STATION
I/C PANEL - ELEVATION

PROJECT No.: 02150
DATE: SEP. 2003
DESIGNED: DL
DRAWN: FMI
CHECKED: JTM

SHEET
E4
TOTAL SHEETS: 35