

CONSTRUCTION PLANS

CITY OF HEATH PUMP STATION No. 1

MAYOR
Cris Cuny

MAYOR PRO TEM
James Tunnell


CITY COUNCIL MEMBERS
Julianna Zurek
John Ratcliffe
Leon Weiss
Karen Lewis

CITY MANAGER
Dennis Watson

ASSISTANT CITY MANAGER
Kim Dobbs


BUILDING OFFICIALS
George Costan
John Langstaff

CITY SECRETARY
Stephanie Galanides

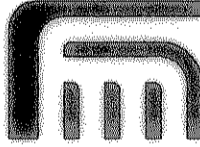 **FREEMAN-MILICAN, Inc.**
ENGINEERS - ARCHITECTS - PLANNERS
9500 FOREST LN. DALLAS, TX 214.503.0555


RECORD DRAWING
(ALL REVISIONS ARE BASED UPON CITY AND CONTRACTOR NOTES AND COMMENTS)

FMI PROJECT No. 02150
JANUARY 2005

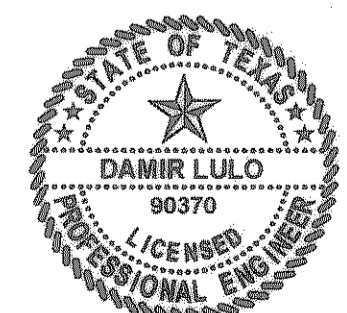

THE SEAL APPEARING ON THIS DOCUMENT WAS AUTHORIZED BY DAMIR LILO, P.E. NO. 90370 ON 1/15/05

Damir Lilo

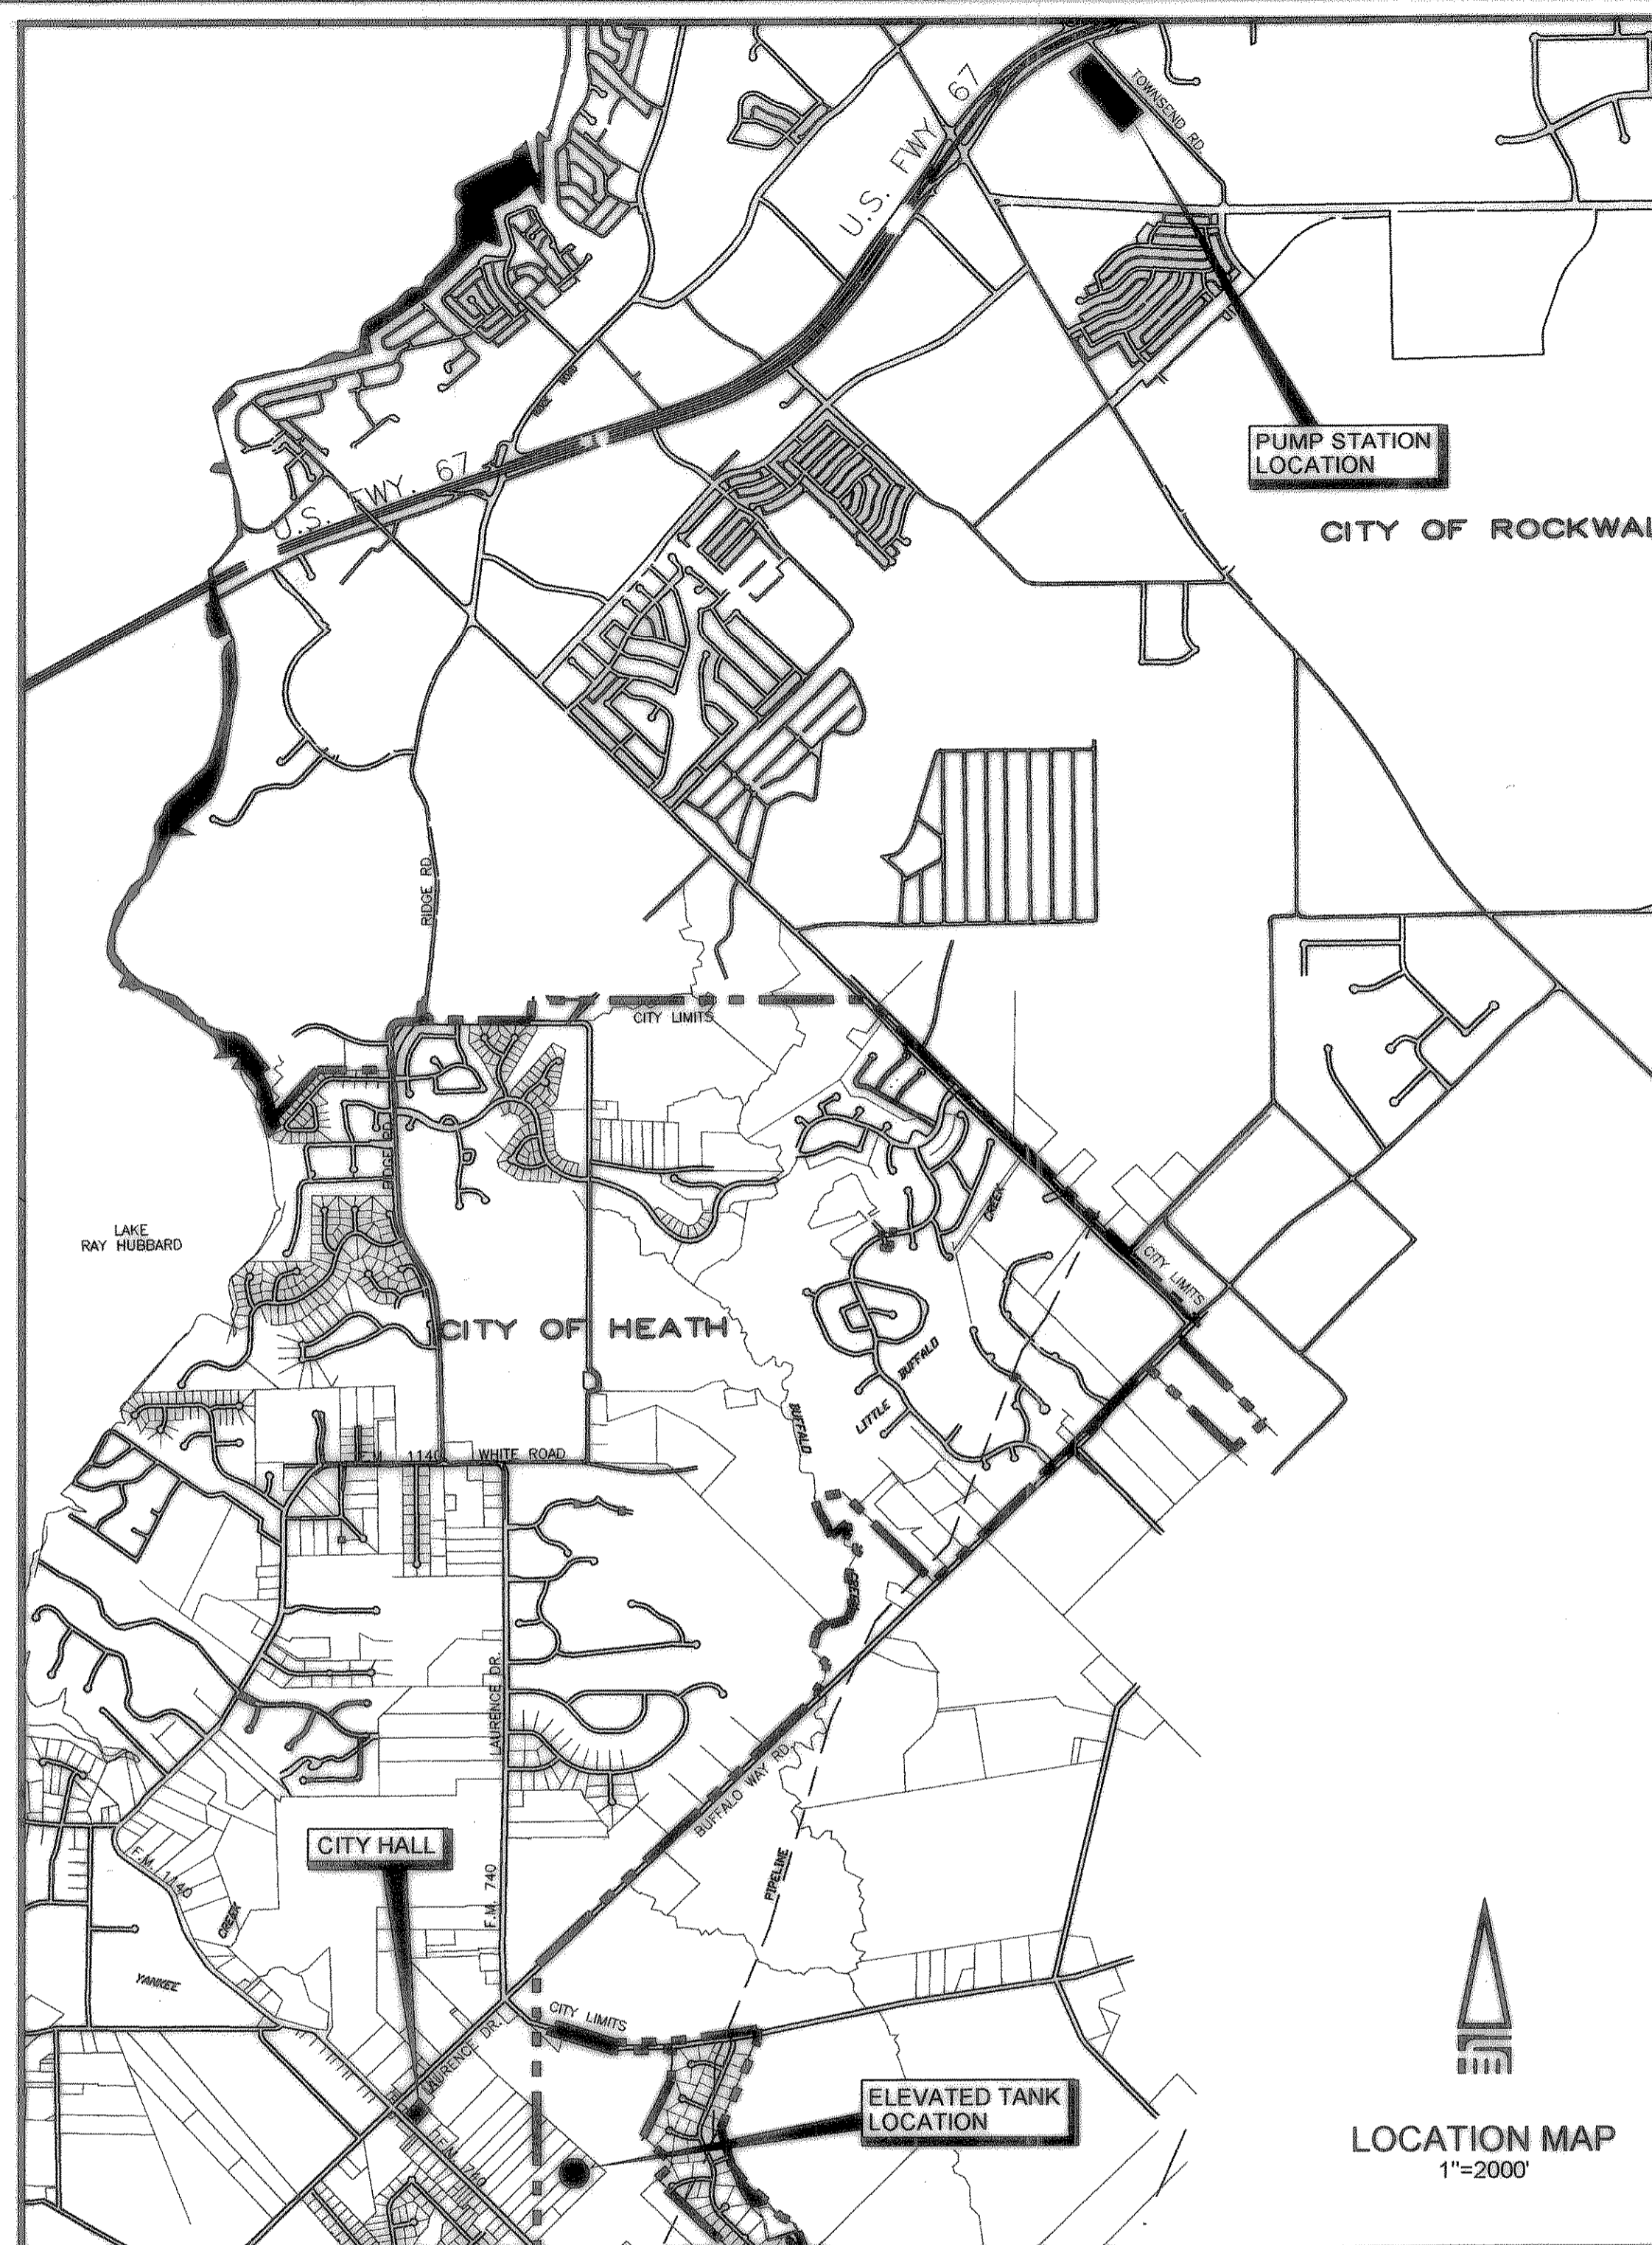

SHEET INDEX

G1	Title Sheet	S3	Structural Details	E3	New I/C Panel
C1	Erosion Control Plan	M1	Mechanical Site Plan	E4	I/C Panel - Elevations
C2	Site Plan, Details	M2	Profiles & General Notes	E5	Wiring Details
C3	Pump Slab & Sidewalk Plan, Details	M3	Pump Station Plan & Sections	E6	PLC Program Flow Chart
C4	Grading & Drainage Plan, Details	M4	Pump Station Section & Details	E7	H.M.I. Screens
C5	Drainage Area Map & Ditch Profiles	M5	Mechanical Details	E8	Elevated Tank Plan Section And Details
C6	Irrigation Plan	M6	Mechanical Details	E9	New Elevated Tank RTU And Installation Details
C7	Landscaping & Irrigation Details	M7	Mechanical Details	E10	Electrical Details
A1	Pump House Plan, Details	M8	Thrust Blocking	E11	Electrical Details
A2	Pump House Elevations	H1	HVAC Plan And Details		
A3	Pump House Sections	H2	HVAC Section And Details		
S1	Pump House Foundation Plan, Details	E1	Electrical Site Plan, Details		
S2	Pump House Framing Plans	E2	One Line Diagram		