

LEGEND
 — PROPOSED WATER SERVICE
 — PROPOSED SEWER SERVICE

PROPOSED CLARK ST. WATER SERVICES

LOCATION	PROPOSED 1 INCH SERVICE
W.L. STA. 2+42.69	29 L.F. (LT.)
W.L. STA. 2+57.31	22.5 L.F. (RT.)
W.L. STA. 2+84.57	29 L.F. (LT.)
W.L. STA. 3+23.81	58.5 L.F. (LT.)
W.L. STA. 3+45.28	28.5 L.F. (LT.)
W.L. STA. 3+53.72	22 L.F. (RT.)
TOTAL: 189.5 L.F.	

FURNISH & INSTALL PROP. 1" OUTLET AND NEW 1" SDR-9 (POLYUBE) WATER SERVICE. TRANSFER OF WATER SERVICE SHALL INCLUDE METER BOX, FITTINGS, 1" SERVICE SADDLE, CONNECTION TO EXISTING SERVICE, AND INSTALLATION OF CITY PROVIDED METER AND SHALL BE PAID ON A PER EACH BASIS.


PROPOSED SEWER SERVICES

LOCATION	PROPOSED 4 INCH SERVICE
S.S. STA. 3+52.58	43 L.F. (LT.)
S.S. STA. 4+04.68	18 L.F. (LT.)
TOTAL: 61 L.F.	

FURNISH & INSTALL
 1-8"x4" WYE
 1-DOUBLE CLEANOUT
 1-4" PLUG
 CONNECT TO EXIST. SAN. SEW. SERVICE
 PAYMENT FOR TRANSFER OF SANITARY SEWER SERVICE SHALL BE PAID ON A PER EACH BASIS.

REVISED TO CONFORM
 TO CONSTRUCTION RECORDS
 BY M.H. DATE 12/04/2006

THESE DOCUMENTS ARE FOR
 BIDDING, CONSTRUCTION,
 AND PERMIT PURPOSES.
 DATE: 12/04/2006

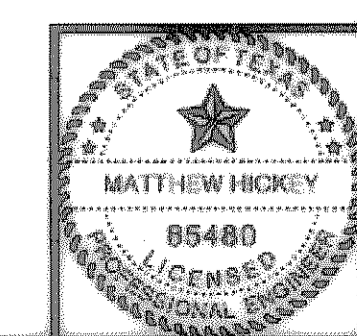

CITY OF ROCKWALL, TEXAS

**CLARK STREET
 SANITARY SEWER & WATER LINE PLAN
 W.L. STA 0+00 TO W.L. STA. 4+00**

BIRKHOFF, HENDRICKS & CONWAY, L.L.P.
 CONSULTING ENGINEERS
 Dallas, Texas

DESIGNED BY: <u>M.H.</u>	PROJECT: <u>2003-120</u>	SHEET NO. <u>34</u>
DRAWN BY: <u>B.H.C.</u>	DATE: <u>AUGUST, 2004</u>	OF <u>X</u> SHEETS

These plans and related specifications were prepared for construction of this specific project only. Reuse of these documents is not permitted without written authorization of Birkhoff, Hendricks & Conway, L.L.P.

08/20/04 R.L. H: ROCKWALL 2003120 PLAN-SHEETS 2003120-SAN-W-1.DWG SCALE: 1"=20' REF: ROCKWALL 2003120-BASE-PROP-BASE