
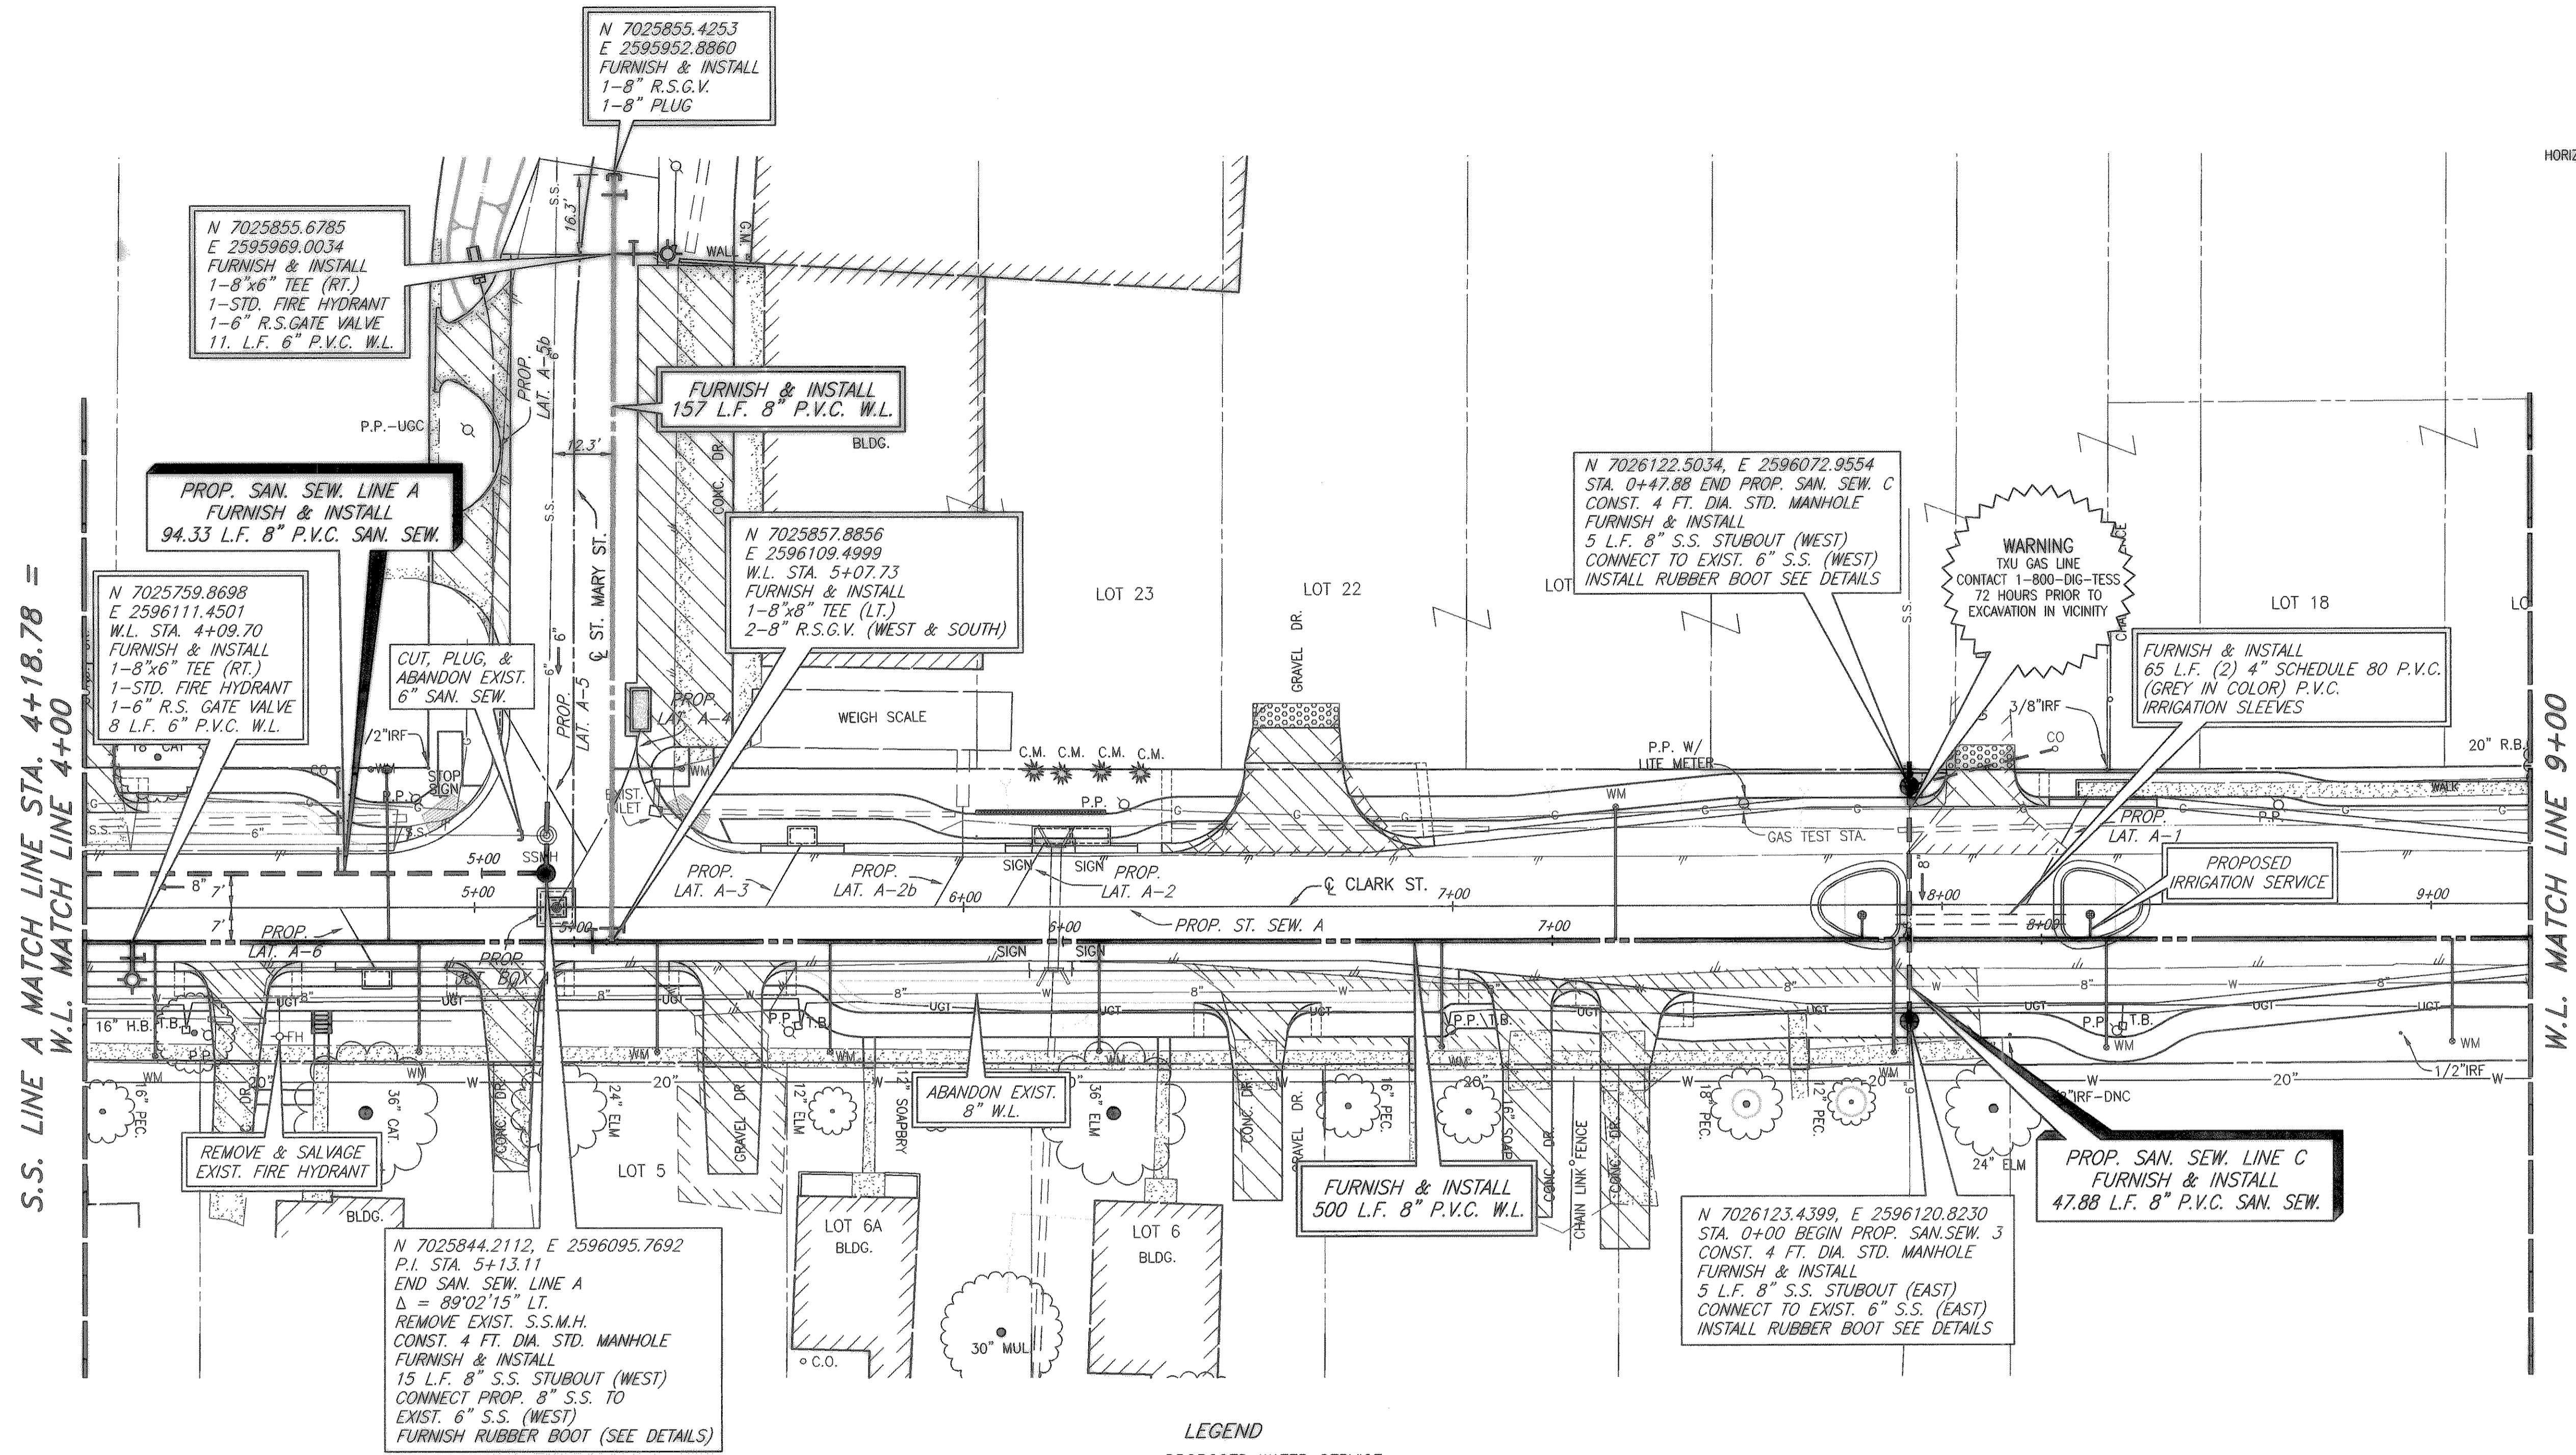


H:\ROCKWALL\2003120\PLAN-SHEETS\2003120-SAN-W-2.DWG SCALE: 1=20 XREF: ROCKWALL\2003120\BASE-PROFILES\CLARK-BOY-TO-66 XREF: ROCKWALL\2003120\BASE\PROP-BASE

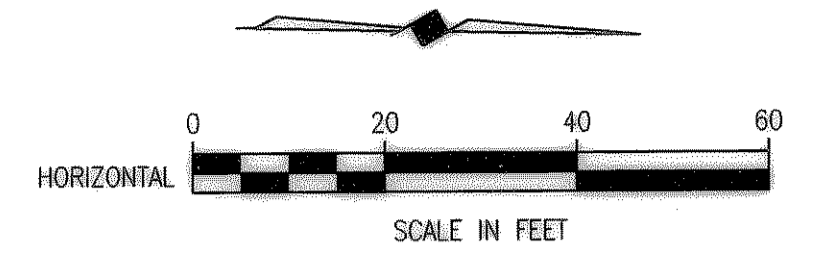

**LEGEND**  
 — PROPOSED WATER SERVICE  
 - - - PROPOSED SEWER SERVICE

**PROPOSED CLARK ST. WATER SERVICES**

LOCATION	PROPOSED 1 INCH SERVICE
W.L. STA. 4+14.39	23 L.F. (RT.)
W.L. STA. 4+62.16	35 L.F. (LT.)
W.L. STA. 4+68.36	22.5 L.F. (RT.)
W.L. STA. 5+52.39	22.5 L.F. (RT.)
W.L. STA. 6+07.39	22.5 L.F. (RT.)
W.L. STA. 6+77.41	21.5 L.F. (RT.)
W.L. STA. 7+12.98	27 L.F. (LT.)
W.L. STA. 7+69.79	23 L.F. (RT.)
W.L. STA. 8+10	5 L.F. (LT.)
W.L. STA. 8+13.29	22 L.F. (RT.)
W.L. STA. 8+83.99	21 L.F. (RT.)
TOTAL: 240 L.F.	

FURNISH & INSTALL PROP. 1" OUTLET AND NEW 1" SDR-9 (POLYTUBE) WATER SERVICE. TRANSFER OF WATER SERVICE SHALL INCLUDE METER BOX, FITTINGS, 1" SERVICE SADDLE, CONNECTION TO EXISTING SERVICE, AND INSTALLATION OF CITY PROVIDED METER AND SHALL BE PAID ON A PER EACH BASIS.

**PROPOSED LINE "A" SEWER SERVICES**

LOCATION	PROPOSED 4 INCH SERVICE
S.S. STA. 4+70.57	21 L.F. (LT.)
TOTAL: 21 L.F.	

FURNISH & INSTALL  
 1-8"x4" WYE  
 1-DOUBLE CLEANOUT  
 1-4" PLUG  
 CONNECT TO EXIST. SAN. SEW. SERVICE  
 PAYMENT FOR TRANSFER OF SANITARY SEWER SERVICE SHALL BE PAID ON A PER EACH BASIS.


**PROPOSED LINE "C" SEWER SERVICES**

LOCATION	PROPOSED 4 INCH SERVICE
S.S. STA. 0+47.88	31 L.F. (RT.)
TOTAL: 31 L.F.	

FURNISH & INSTALL  
 1-8"x4" WYE  
 1-DOUBLE CLEANOUT  
 1-4" PLUG  
 CONNECT TO EXIST. SAN. SEW. SERVICE  
 PAYMENT FOR TRANSFER OF SANITARY SEWER SERVICE SHALL BE PAID ON A PER EACH BASIS.

REVISÉ TO CONFORM TO CONSTRUCTION RECORDS  
 BY M.H. DATE 12/04/2006

THESE DOCUMENTS ARE FOR BIDDING, CONSTRUCTION, AND PERMIT PURPOSES.  
 DATE: 8/6/04

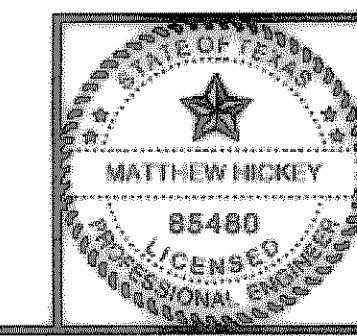

**CITY OF ROCKWALL, TEXAS**

**CLARK STREET  
 SANITARY SEWER & WATER LINE PLAN  
 W.L. STA 4+00 TO W.L. STA. 9+00**

**BIRKHOFF, HENDRICKS & CONWAY, L.L.P.**  
 CONSULTING ENGINEERS  
 Dallas, Texas

DESIGNED BY: M.H.	PROJECT: 2003-120	SHEET NO. 35
DRAWN BY: B.H.C.	DATE: AUGUST, 2004	OF X SHEETS

These plans and related specifications were prepared for construction of this specific project only. Reuse of these documents is not permitted without written authorization of Birkhoff, Hendricks & Conway, L.L.P.