

LEGEND
 — PROPOSED WATER SERVICE
 — PROPOSED SEWER SERVICE

PROPOSED CLARK ST. WATER SERVICES

LOCATION	PROPOSED 1 INCH SERVICE
W.L. STA. 14+52	5 L.F. (LT.)
W.L. STA. 15+66.57	29 L.F. (LT.)
W.L. STA. 15+68.05	29 L.F. (LT.)
W.L. STA. 16+55.90	35 L.F. (LT.)
W.L. STA. 16+88.02	34 L.F. (LT.)
W.L. STA. 17+62.11	33 L.F. (LT.)
W.L. STA. 18+30.70	36 L.F. (LT.)
W.L. STA. 18+83.36	27 L.F. (LT.)
TOTAL: 223 L.F.	

FURNISH & INSTALL PROP. 1" OUTLET AND NEW 1" SDR-9 (POLYTUBE) WATER SERVICE. TRANSFER OF WATER SERVICE SHALL INCLUDE METER BOX, FITTINGS, 1" SERVICE SADDLE, CONNECTION TO EXISTING SERVICE, AND INSTALLATION OF CITY PROVIDED METER AND SHALL BE PAID ON A PER EACH BASIS.

PROPOSED LINE "G" SEWER SERVICES

LOCATION	PROPOSED 4 INCH SERVICE
S.S. STA. 0+01.47	12.5 L.F. (LT.)
S.S. STA. 0+04.28	15 L.F. (LT.)
TOTAL: 27.5 L.F.	

FURNISH & INSTALL
 1-8"x4" WYE
 1-DOUBLE CLEANOUT
 1-4" PLUG
 CONNECT TO EXIST. SAN. SEW. SERVICE
 PAYMENT FOR TRANSFER OF SANITARY SEWER SERVICE SHALL BE PAID ON A PER EACH BASIS.

These plans and related specifications were prepared for construction of this specific project only. Reuse of these documents is not permitted without written authorization of Birkhoff, Hendricks & Conway, L.L.P.

CITY OF ROCKWALL, TEXAS


CLARK STREET
SANITARY SEWER & WATER LINE PLAN
 W.L. STA 14+00 TO W.L. STA. 19+00

BIRKHOFF, HENDRICKS & CONWAY, L.L.P.
 CONSULTING ENGINEERS
 Dallas, Texas

DESIGNED BY: M.H. PROJECT: 2003-120 SHEET NO. 37
 DRAWN BY: B.H.C. DATE: AUGUST, 2004 OF X SHEETS

THESE DOCUMENTS ARE FOR BIDDING, CONSTRUCTION, AND PERMIT PURPOSES.

DATE: 8/6/04

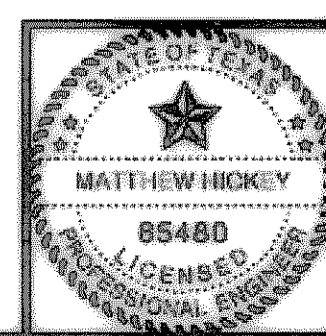

REVISED TO CONFORM TO CONSTRUCTION RECORDS
 BY M.H. DATE 12/04/2006