

LEGEND

— PROPOSED WATER SERVICE

— PROPOSED SEWER SERVICE


PROPOSED CLARK ST. WATER SERVICES

LOCATION	PROPOSED 1 INCH SERVICE
W.L. STA. 33+24.65	5 L.F. (RT.)
W.L. STA. 34+84.86	7 L.F. (RT.)
TOTAL: 12 L.F.	

FURNISH & INSTALL PROP. 1" OUTLET AND NEW 1" SDR-9 (POLYTUBE) WATER SERVICE. TRANSFER OF WATER SERVICE SHALL INCLUDE METER BOX, FITTINGS, 1" SERVICE SADDLE, CONNECTION TO EXISTING SERVICE, AND INSTALLATION OF CITY PROVIDED METER AND SHALL BE PAID ON A PER EACH BASIS.


NOTE:
WARNING!!! TXU GAS LINES CROSS PROPOSED WATER LINES IN THE CLARK AND WILLIAMS INTERSECTION. CONTACT 1-800-DIG-TESS PRIOR TO EXCAVATION.

These plans and related specifications were prepared for construction of this specific project only. Reuse of these documents is not permitted without written authorization of Birkhoff, Hendricks & Conway, L.L.P.

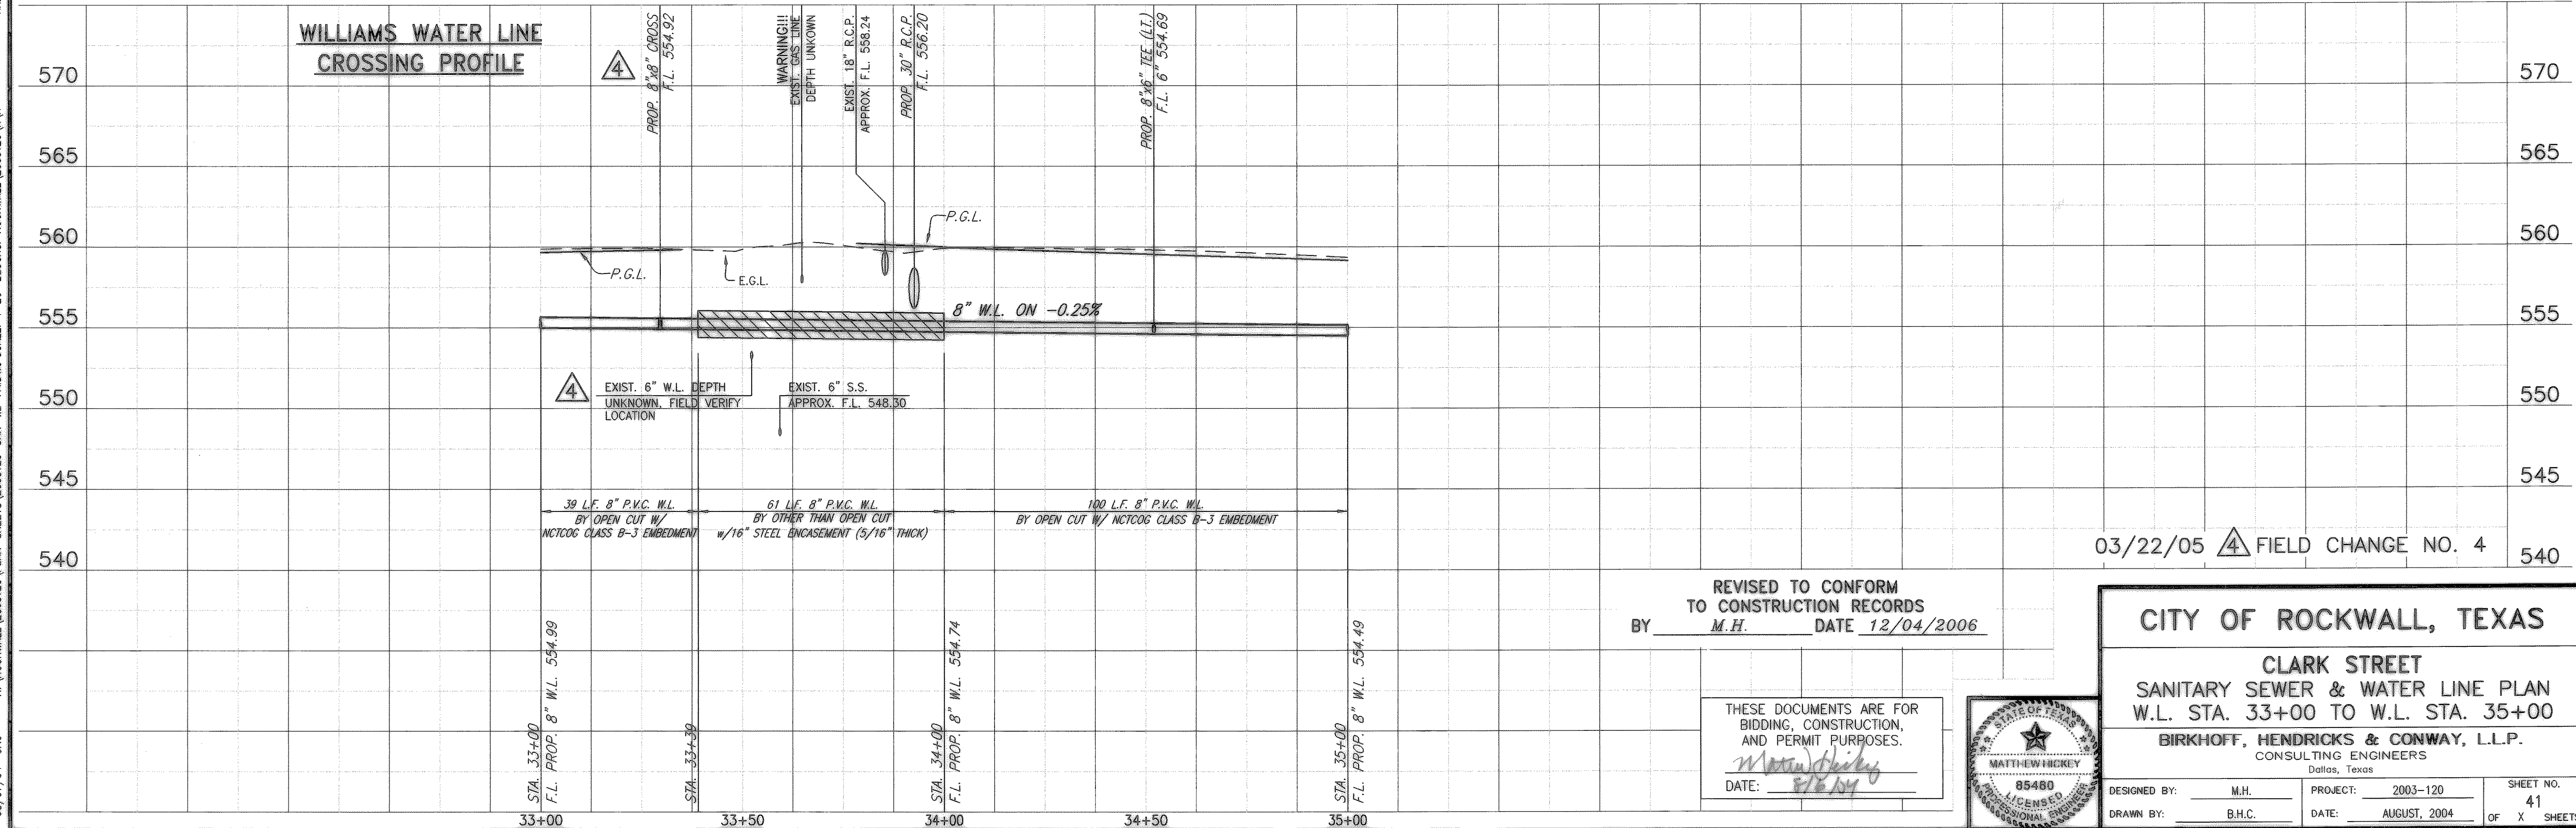

REVISED TO CONFORM TO CONSTRUCTION RECORDS
BY M.H. DATE 12/04/2006

THESE DOCUMENTS ARE FOR BIDDING, CONSTRUCTION, AND PERMIT PURPOSES.
DATE: 8/6/04

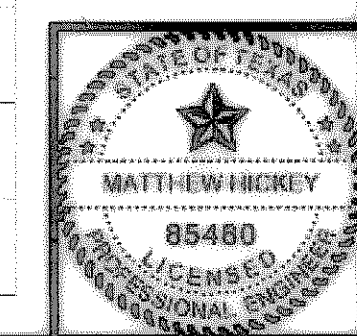

CITY OF ROCKWALL, TEXAS

CLARK STREET
SANITARY SEWER & WATER LINE PLAN
W.L. STA. 33+00 TO W.L. STA. 35+00

BIRKHOFF, HENDRICKS & CONWAY, L.L.P.
CONSULTING ENGINEERS
Dallas, Texas

DESIGNED BY: M.H.	PROJECT: 2003-120	SHEET NO. 41
DRAWN BY: B.H.C.	DATE: AUGUST, 2004	OF X SHEETS

08/07/04 CAG H:\ROCKWALL\2003120\PLAN-SHEETS\2003120-SAN-WL-7A DWG SCALE: 1"=20' BLOCKS: ROCKWALL\2003120\XX XREF: ROCKWALL\2003120\XX