
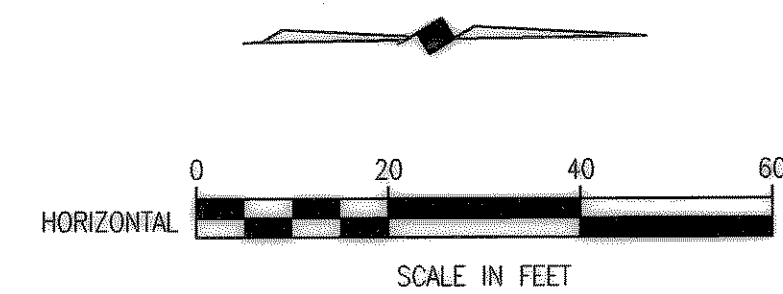


REF: ROCKWALL 2003120 V.V.X

H: ROCKWALL 2003120 PLAN-SHEETS 2003120 SAN-WL-BLDG SCALE: 1"=20' BLOCKS: ROCKWALL 2003120 V.V.X

08/02/04 CAG

S.S. LINE K MATCH LINE STA. 0+95.38 =
W.L. MATCH LINE STA. 35+00

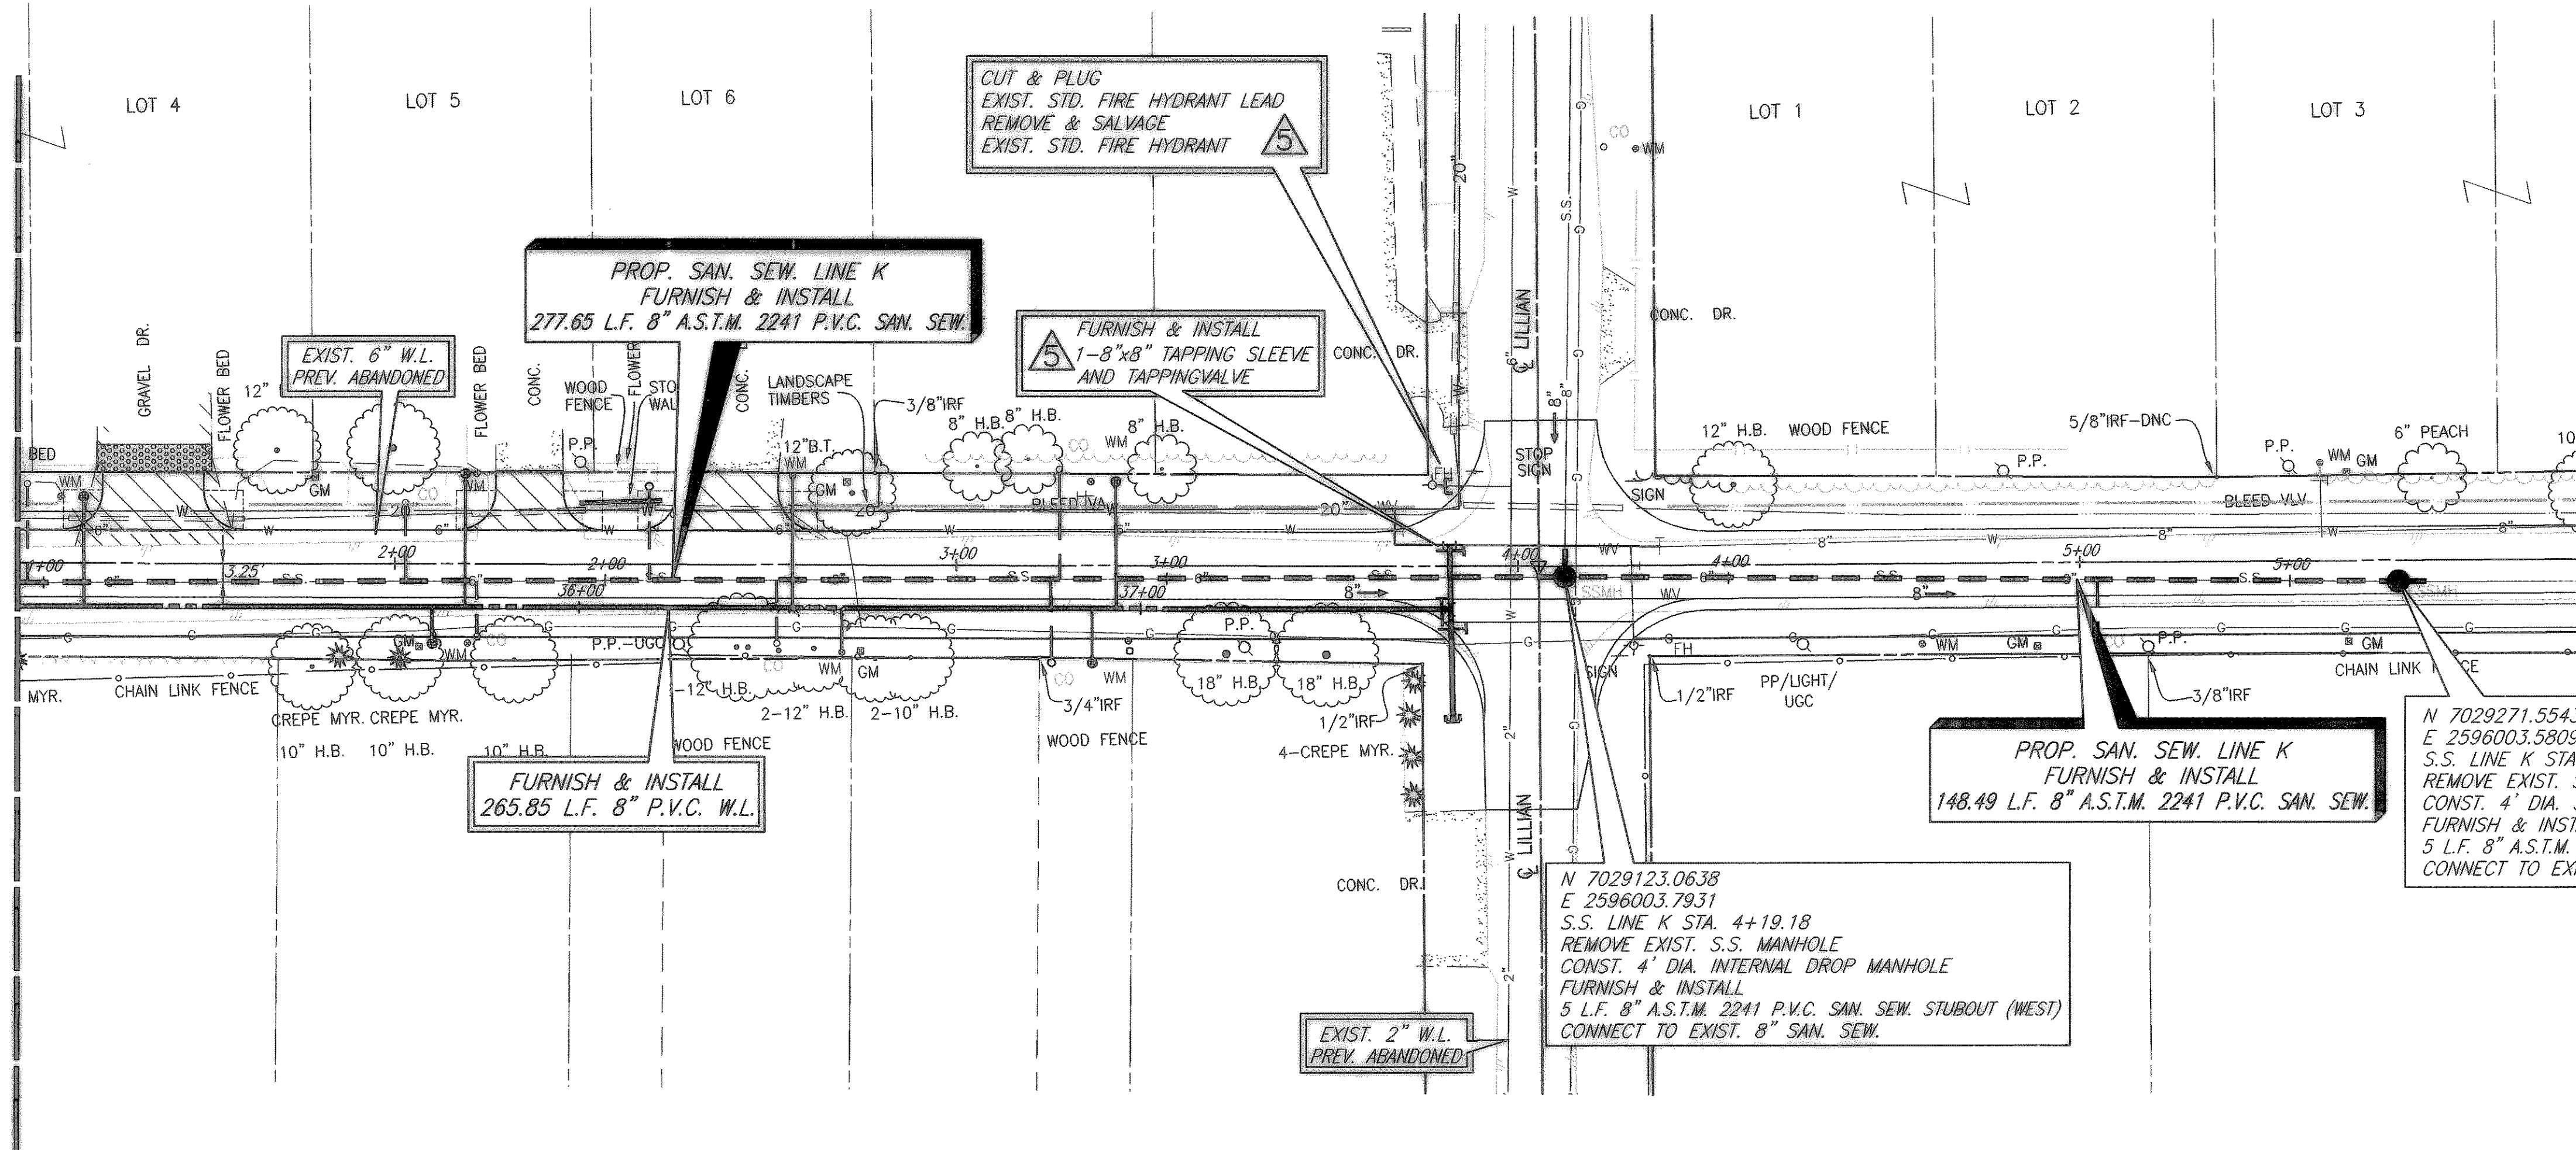

LEGEND
 — PROPOSED WATER SERVICE
 — PROPOSED SEWER SERVICE

PROPOSED CLARK ST. WATER SERVICES

LOCATION	PROPOSED 1 INCH SERVICE
W.L. STA. 35+11.84	19.5 L.F. (LT.)
W.L. STA. 35+73.78	6.5 L.F. (RT.)
W.L. STA. 35+79.70	24 L.F. (LT.)
W.L. STA. 36+37.98	23.5 L.F. (LT.)
W.L. STA. 36+46.80	8 L.F. (RT.)
W.L. STA. 36+87.99	6 L.F. (RT.)
W.L. STA. 36+95.64	22.5 L.F. (LT.)
TOTAL: 110 L.F.	

FURNISH & INSTALL PROP. 1" OUTLET AND NEW 1" SDR-9 (POLYTUBE) WATER SERVICE. TRANSFER OF WATER SERVICE SHALL INCLUDE METER BOX, FITTINGS, 1" SERVICE SADDLE, CONNECTION TO EXISTING SERVICE, AND INSTALLATION OF CITY PROVIDED METER AND SHALL BE PAID ON A PER EACH BASIS.

PROPOSED LINE "K" SEWER SERVICES


LOCATION	PROPOSED 4 INCH SERVICE
S.S. STA. 0+97.20	17.5 L.F. (LT.)
S.S. STA. 1+64.50	14 L.F. (LT.)
S.S. STA. 1+77.13	10 L.F. (RT.)
S.S. STA. 2+30.53	11.5 L.F. (RT.)
S.S. STA. 2+80.99	19.5 L.F. (LT.)
S.S. STA. 2+93.34	13 L.F. (RT.)
TOTAL: 85.5 L.F.	

FURNISH & INSTALL 1-8"x4" WYE 1-DOUBLE CLEANOUT 1-4" PLUG CONNECT TO EXIST. SAN. SEW. SERVICE PAYMENT FOR TRANSFER OF SANITARY SEWER SERVICE SHALL BE PAID ON A PER EACH BASIS.

REVISED TO CONFORM TO CONSTRUCTION RECORDS BY M.H. DATE 12/04/2006

THESE DOCUMENTS ARE FOR BIDDING, CONSTRUCTION, AND PERMIT PURPOSES.

DATE: 8/16/05

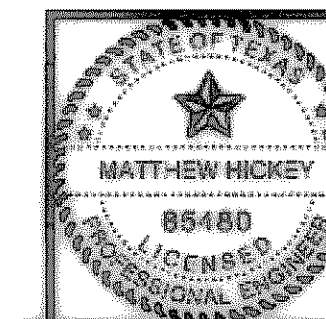

These plans and related specifications were prepared for construction of this specific project only. Reuse of these documents is not permitted without written authorization of Birkhoff, Hendricks & Conway, L.L.P.

CITY OF ROCKWALL, TEXAS

**CLARK STREET
 SANITARY SEWER & WATER LINE PLAN
 W.L. STA. 35+00 TO END (STA. 38+02.05)**

BIRKHOFF, HENDRICKS & CONWAY, L.L.P.
 CONSULTING ENGINEERS
 Dallas, Texas

DESIGNED BY: <u>M.H.</u>	PROJECT: <u>2003-120</u>	SHEET NO. <u>42</u>
DRAWN BY: <u>B.H.C.</u>	DATE: <u>AUGUST, 2004</u>	OF <u>X</u> SHEETS

05/16/05 FIELD CHANGE NO. 5