
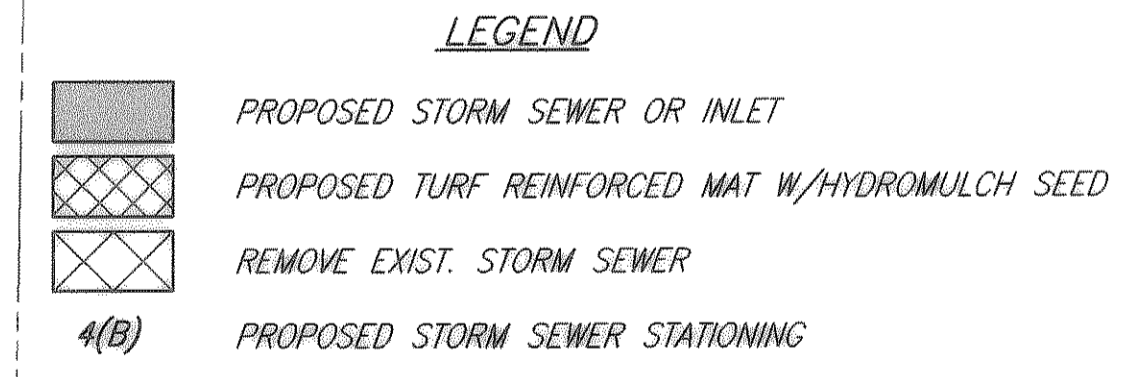
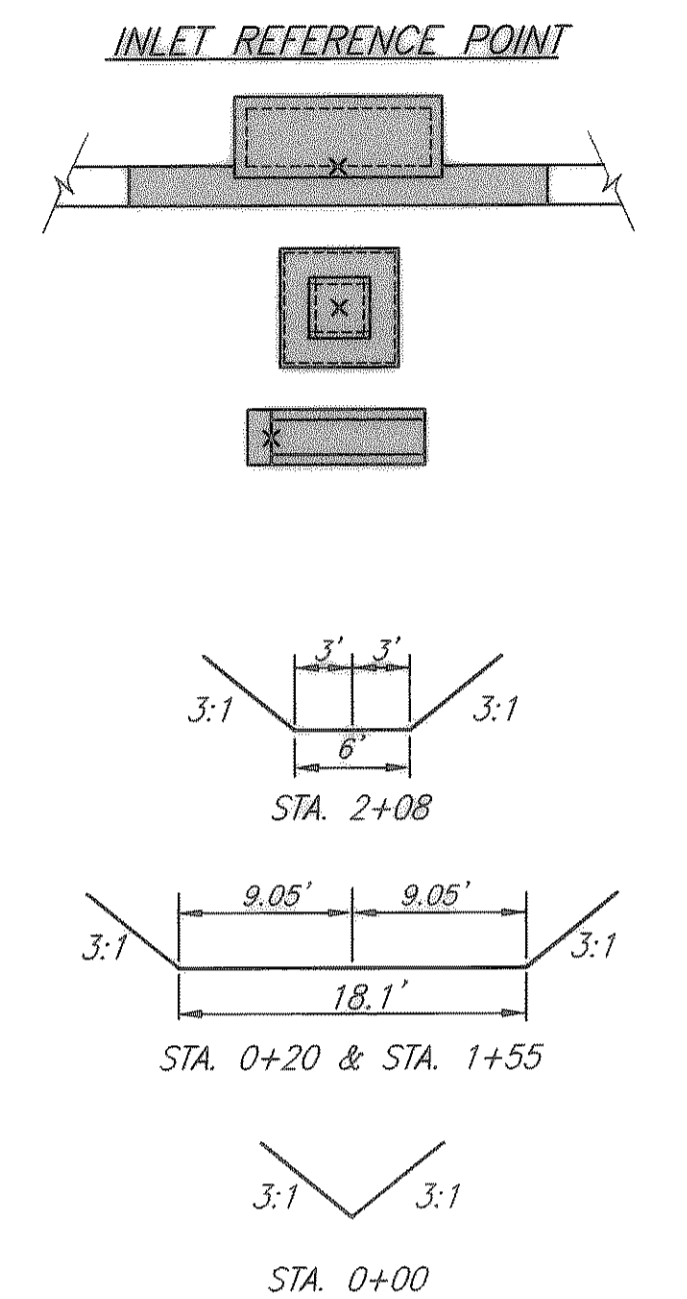
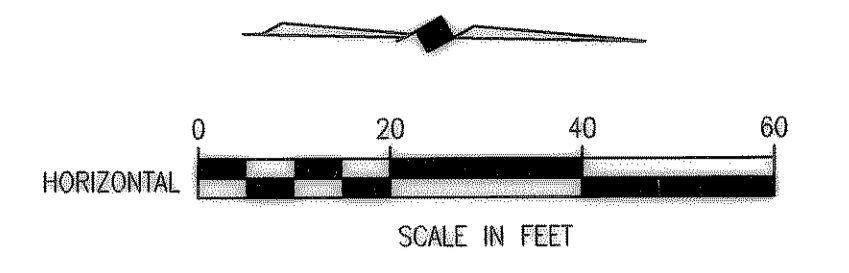


01/11/05 RLL H:\ROCKWALL\2003120\PLAN-SHEETS\2003120-STM-P-04.DWG SCALE: 1"=20' XREF: ROCKWALL\2003120\BASE\PROP-BASE

**STORM SEWER LINE 'B' MATCH LINE STA. 1+00  
CLARK STREET STA. 14+12.07**

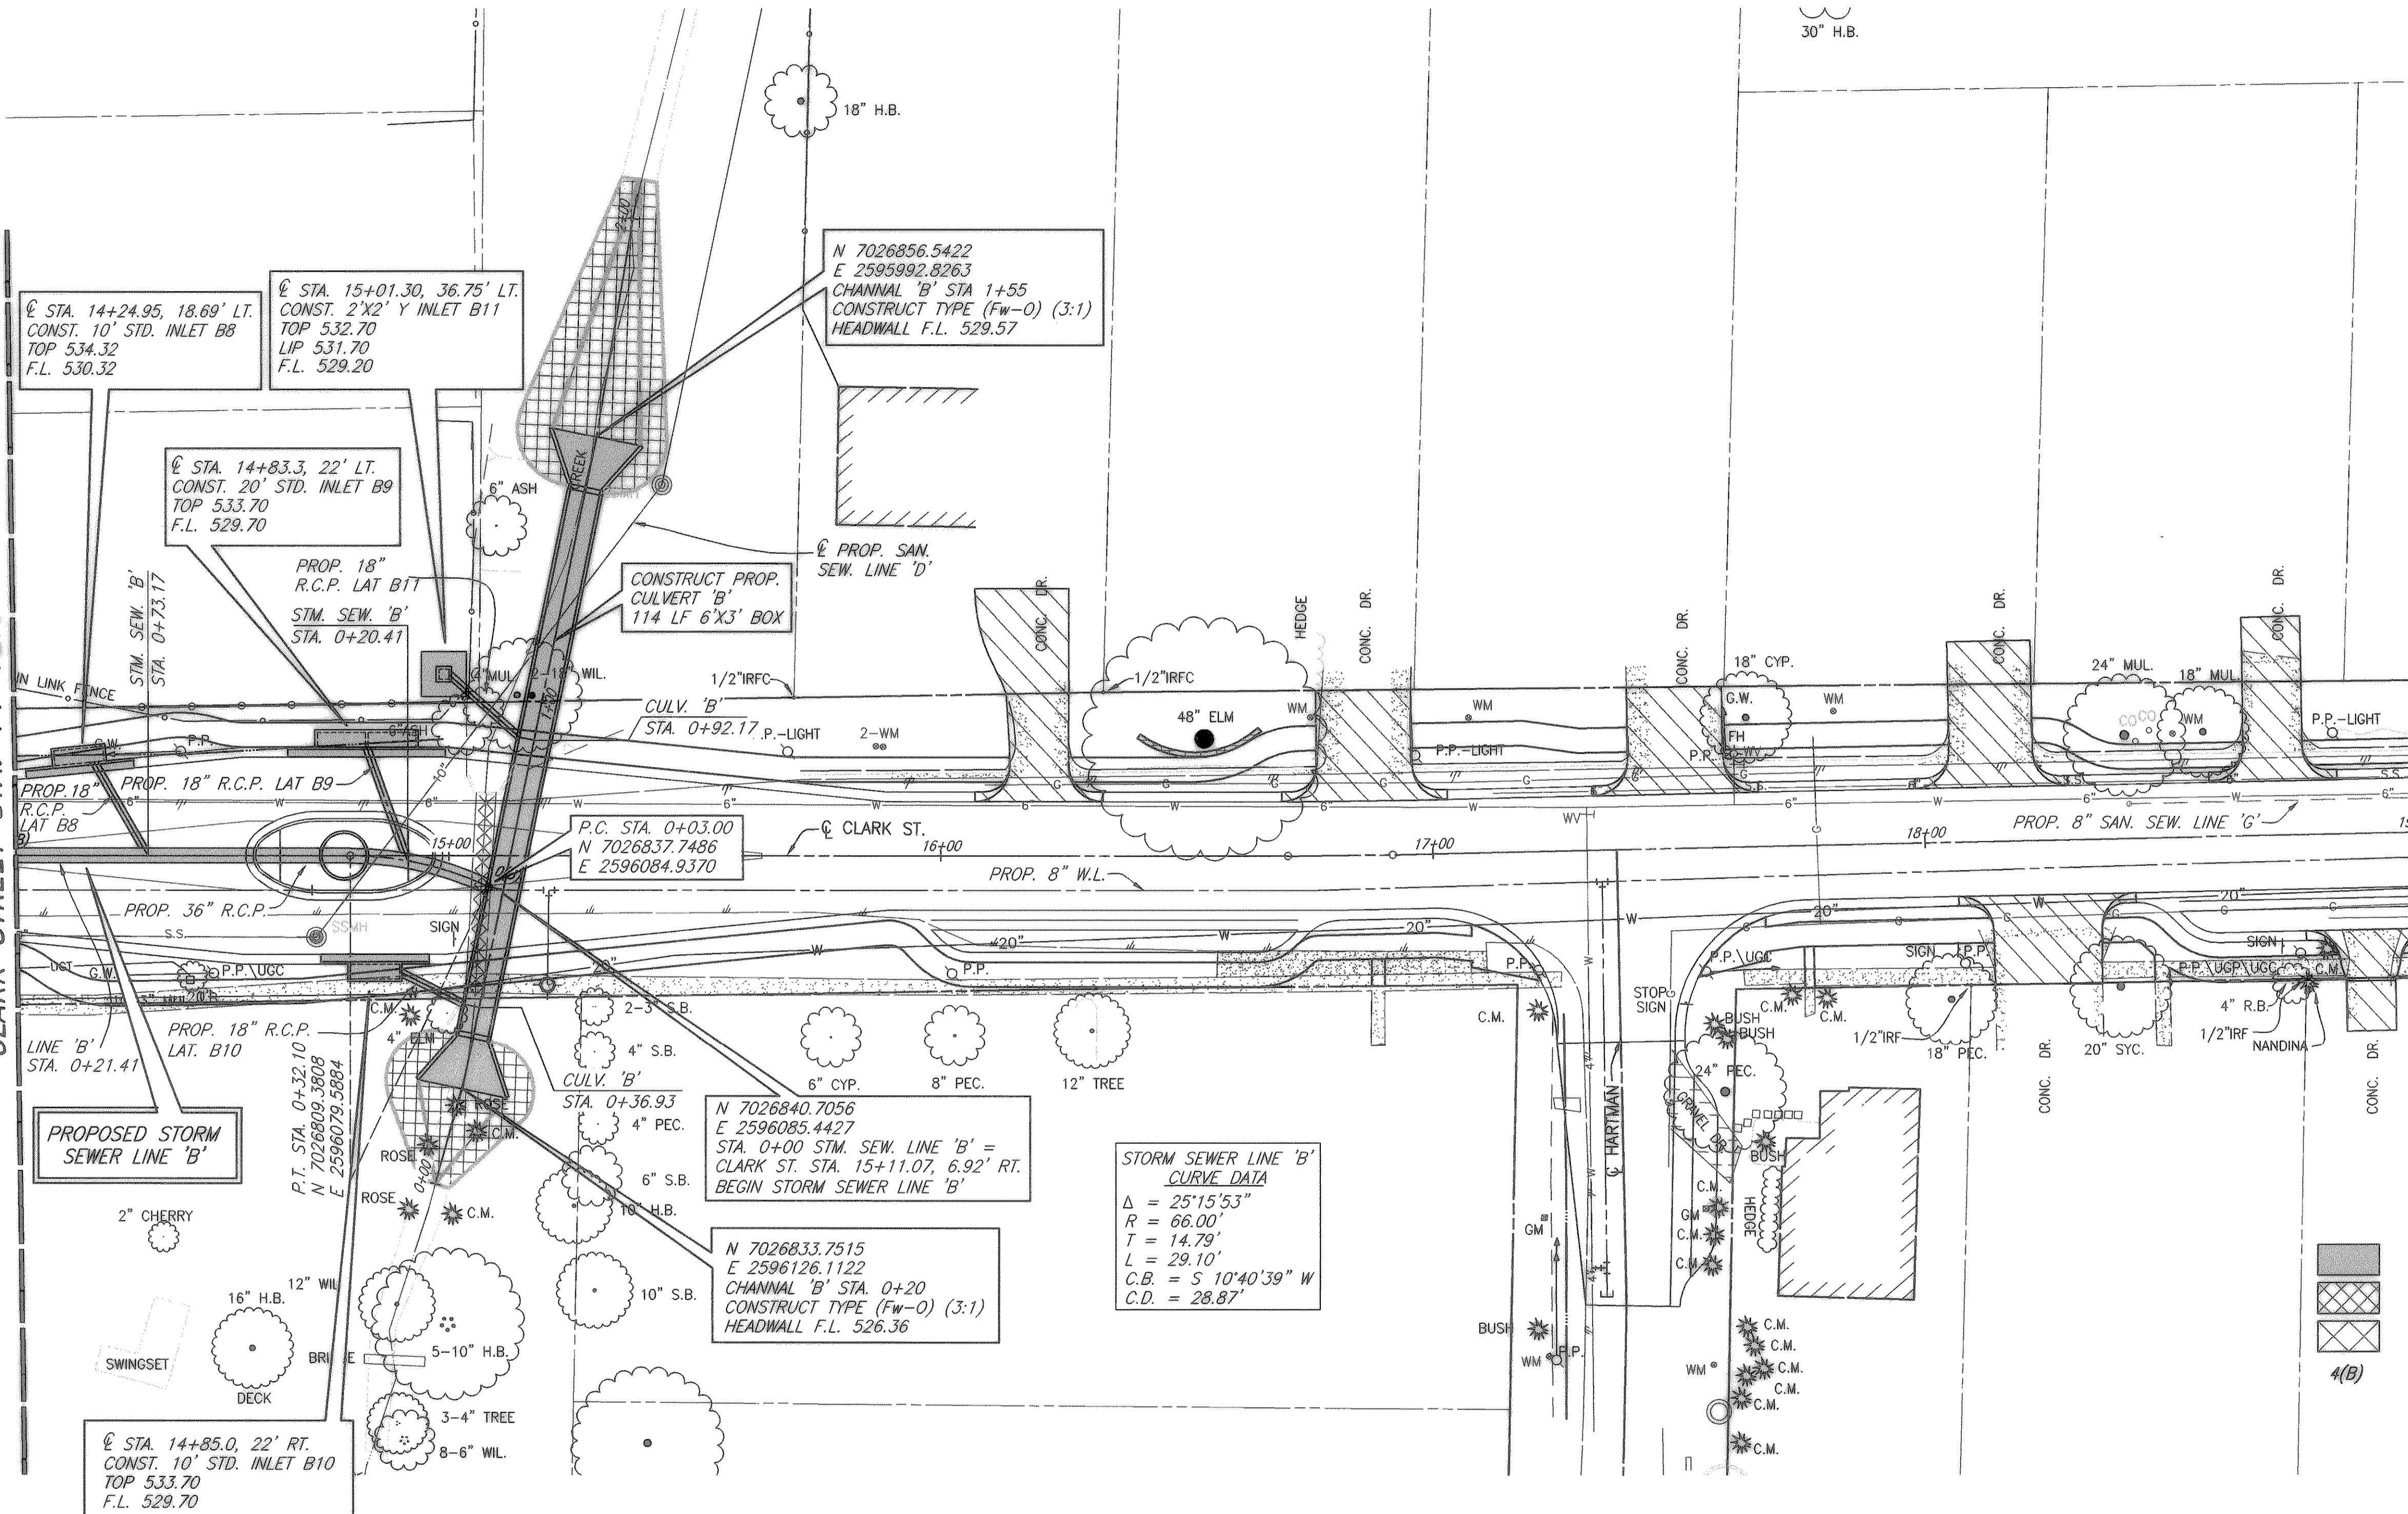


**STORM SEWER LINE 'B' CURVE DATA**

$\Delta = 25^{\circ}15'53''$   
 $R = 66.00'$   
 $T = 14.79'$   
 $L = 29.10'$   
 $C.B. = S^{\circ}10'40'39'' W$   
 $C.D. = 28.87'$

These plans and related specifications were prepared for construction of this specific project only. Reuse of these documents is not permitted without written authorization of Birkhoff, Hendricks & Conway, L.L.P.

REVISED TO CONFORM  
TO CONSTRUCTION RECORDS  
BY M.H. DATE 12/04/2006

THESE DOCUMENTS ARE FOR BIDDING, CONSTRUCTION, AND PERMIT PURPOSES.  
*Matthew Hickey*  
DATE: 8/2/04

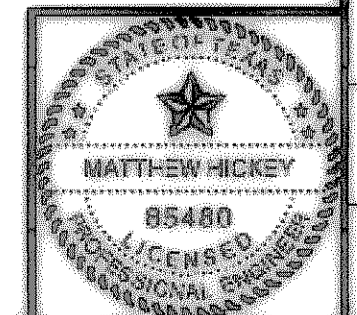

**CITY OF ROCKWALL, TEXAS**

**CLARK STREET  
STORM SEWER PLAN-4  
LINE 'B' - STA 1+00 TO STA. 0+00**

**BIRKHOFF, HENDRICKS & CONWAY, L.L.P.**  
CONSULTING ENGINEERS  
Dallas, Texas

DESIGNED BY: <u>M.H.</u>	PROJECT: <u>2003-120</u>	SHEET NO. <u>63</u>
DRAWN BY: <u>B.H.C.</u>	DATE: <u>AUGUST, 2004</u>	OF <u>X</u> SHEETS