


These plans and related specifications were prepared for construction of this specific project only. Reuse of these documents is not permitted without written authorization of Birkhoff, Hendricks & Conway, L.L.P.

REVISED TO CONFORM TO CONSTRUCTION RECORDS BY M.H. DATE 12/04/2006

THESE DOCUMENTS ARE FOR BIDDING, CONSTRUCTION, AND PERMIT PURPOSES.  
 DATE: 8/26/04

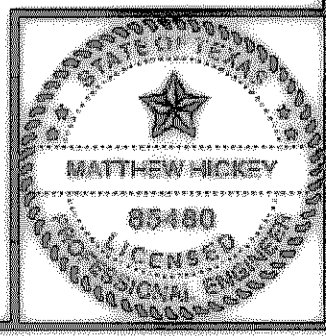

**CITY OF ROCKWALL, TEXAS**  
**CLARK STREET-STORM SEWER 'A'**  
**PROFILE SHEET**  
**LATERALS 'A4' THRU LATERAL 'A9'**  
**BIRKHOFF, HENDRICKS & CONWAY, L.L.P.**  
 CONSULTING ENGINEERS  
 Dallas, Texas

DESIGNED BY: M.H. PROJECT: 2003-120 SHEET NO. 69  
 DRAWN BY: G.C. DATE: AUGUST, 2004 OF X SHEETS