

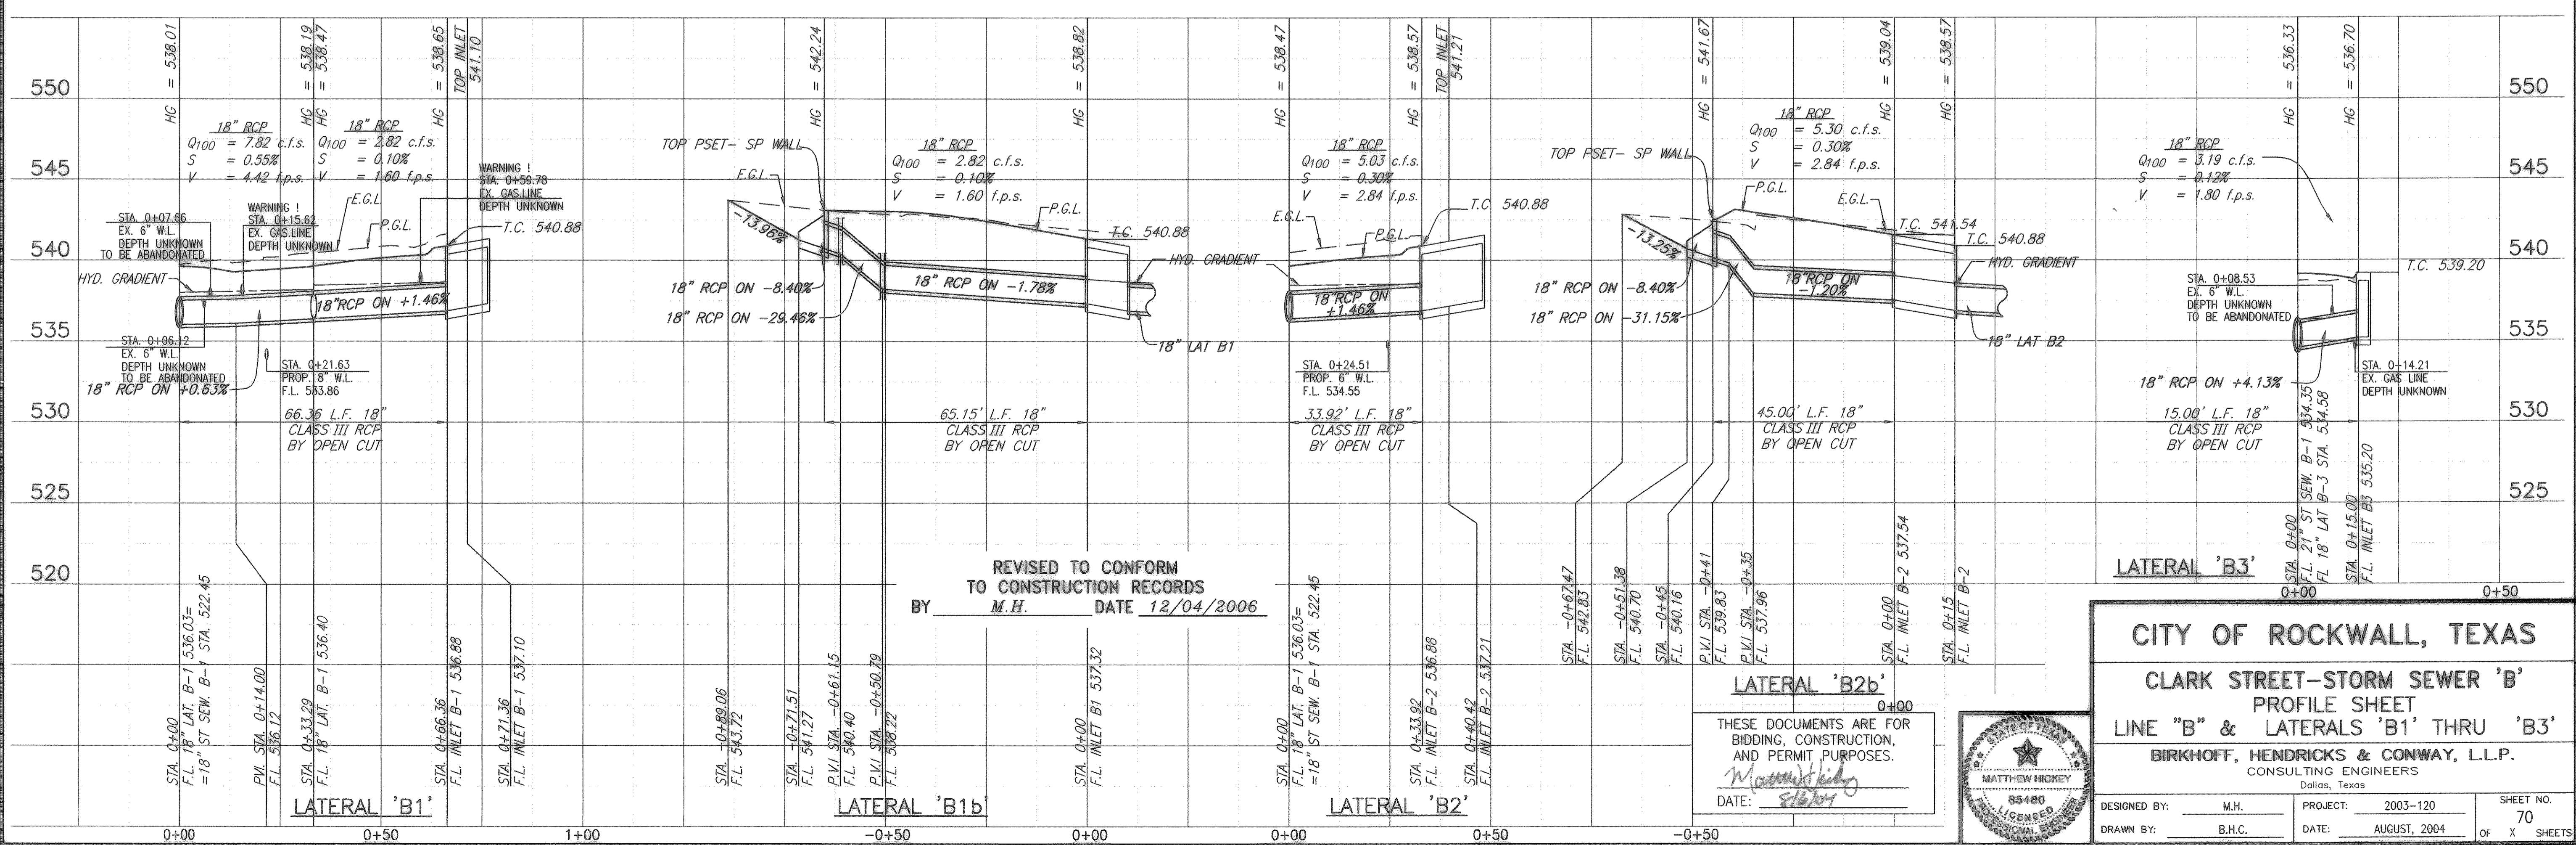


07/21/04 R.L. H:\ROCKWALL\2003\20\PLAN-SHEETS\2003\20-STM3.DWG SCALE: 1"=20' BLOCKS: ROCKWALL\2003\20\X.Y. XREF: ROCKWALL\2003\20\X.Y.

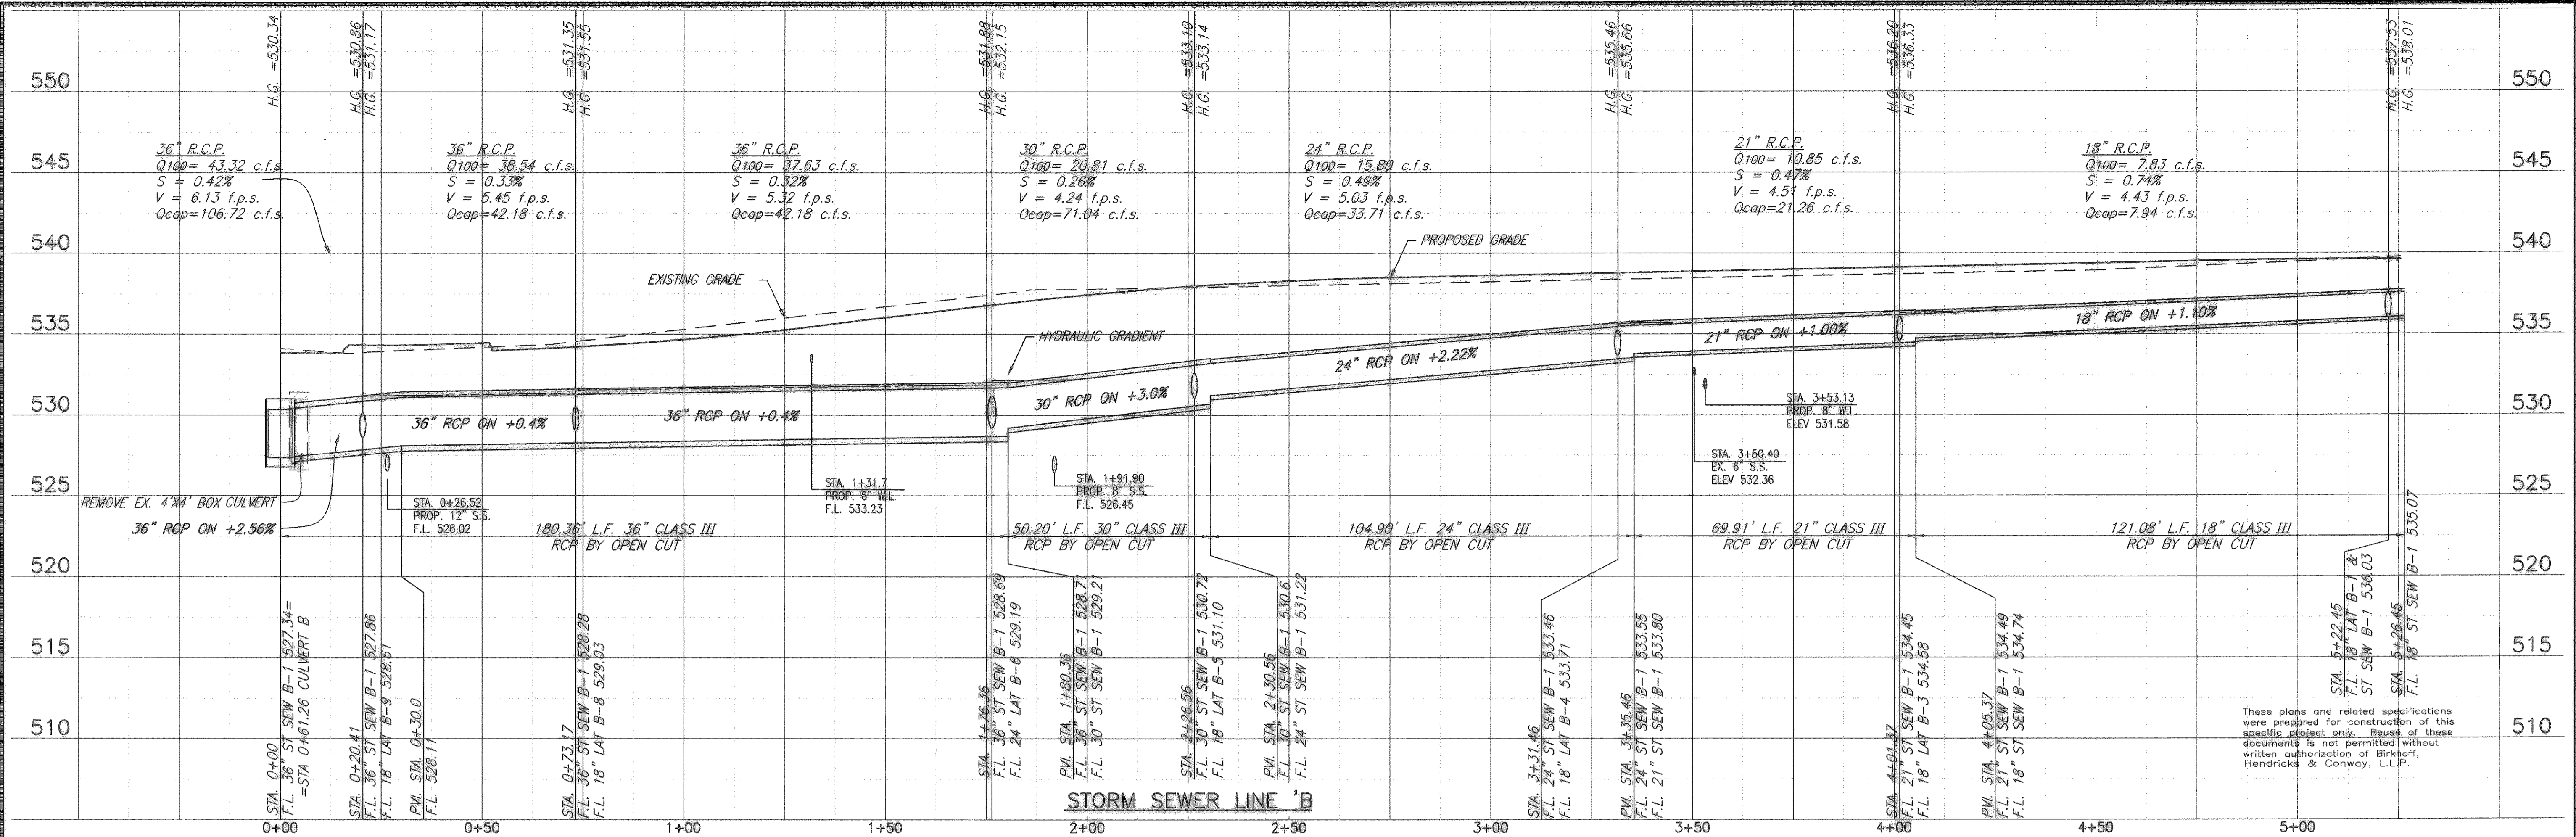

REVISED TO CONFORM TO CONSTRUCTION RECORDS BY M.H. DATE 12/04/2006

LATERAL 'B2b'  
 THESE DOCUMENTS ARE FOR BIDDING, CONSTRUCTION, AND PERMIT PURPOSES.  
 DATE: 8/6/04

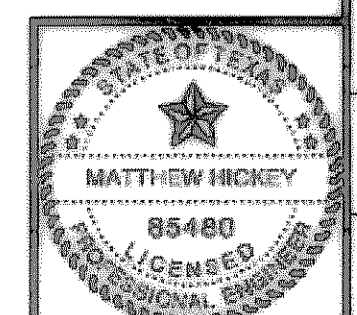

**CITY OF ROCKWALL, TEXAS**

**CLARK STREET-STORM SEWER 'B' PROFILE SHEET**

**LINE 'B' & LATERALS 'B1' THRU 'B3'**

**BIRKHOFF, HENDRICKS & CONWAY, L.L.P.**  
 CONSULTING ENGINEERS  
 Dallas, Texas

DESIGNED BY: M.H. PROJECT: 2003-120 SHEET NO. 70  
 DRAWN BY: B.H.C. DATE: AUGUST, 2004 OF X SHEETS

These plans and related specifications were prepared for construction of this specific project only. Reuse of these documents is not permitted without written authorization of Birkhoff, Hendricks & Conway, L.L.P.