


10 FIELD CHANGE NO. 10

These plans and related specifications were prepared for construction of this specific project only. Reuse of these documents is not permitted without written authorization of Birkhoff, Hendricks & Conway, L.L.P.

CITY OF ROCKWALL, TEXAS

CLARK STREET-STORM SEWER 'B' PROFILE SHEET
LATERALS 'B4' THRU LATERAL 'B11'

BIRKHOFF, HENDRICKS & CONWAY, L.L.P.
 CONSULTING ENGINEERS
 Dallas, Texas

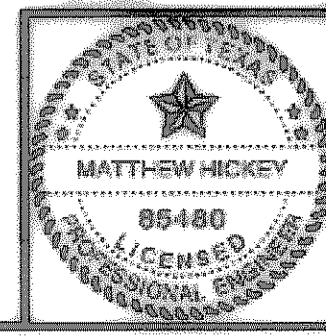

DESIGNED BY: M.H.	PROJECT: 2003-120	SHEET NO. 71
DRAWN BY: G.C.	DATE: AUGUST, 2004	OF X SHEETS

REVISED TO CONFORM TO CONSTRUCTION RECORDS
 BY M.H. DATE 12/04/2006

THESE DOCUMENTS ARE FOR BIDDING, CONSTRUCTION, AND PERMIT PURPOSES.
 DATE: 8/16/04