


These plans and related specifications were prepared for construction of this specific project only. Reuse of these documents is not permitted without written authorization of Birkhoff, Hendricks & Conway, L.L.P.

FIELD CHANGE NO. 1 (1-19-05)

REVISED TO CONFORM TO CONSTRUCTION RECORDS BY M.H. DATE 12/04/2006

THESE DOCUMENTS ARE FOR BIDDING, CONSTRUCTION, AND PERMIT PURPOSES. DATE: 11/19/05

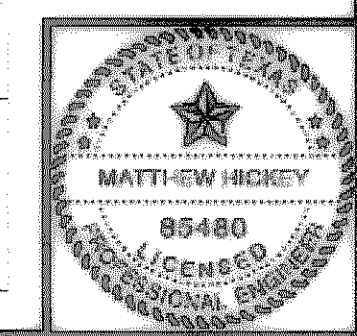

**CITY OF ROCKWALL, TEXAS**  
**CLARK STREET-STORM SEWER 'C'**  
**PROFILE SHEET**  
**LINES 'C1' & 'C2' & LATERALS 'C1'-'C6'**  
**BIRKHOFF, HENDRICKS & CONWAY, L.L.P.**  
 CONSULTING ENGINEERS  
 Dallas, Texas

DESIGNED BY: M.H. PROJECT: 2003-120 SHEET NO. 72  
 DRAWN BY: B.H.C. DATE: AUGUST, 2004 OF X SHEETS