



XREF: ROCKWALL 2003120 V X

BLOCKS: ROCKWALL 2003120 V X

SCALE: 1"=20'

H: ROCKWALL 2003120 PLAN-SHEETS 2003120-STMB.DWG


08/06/04 R.L.

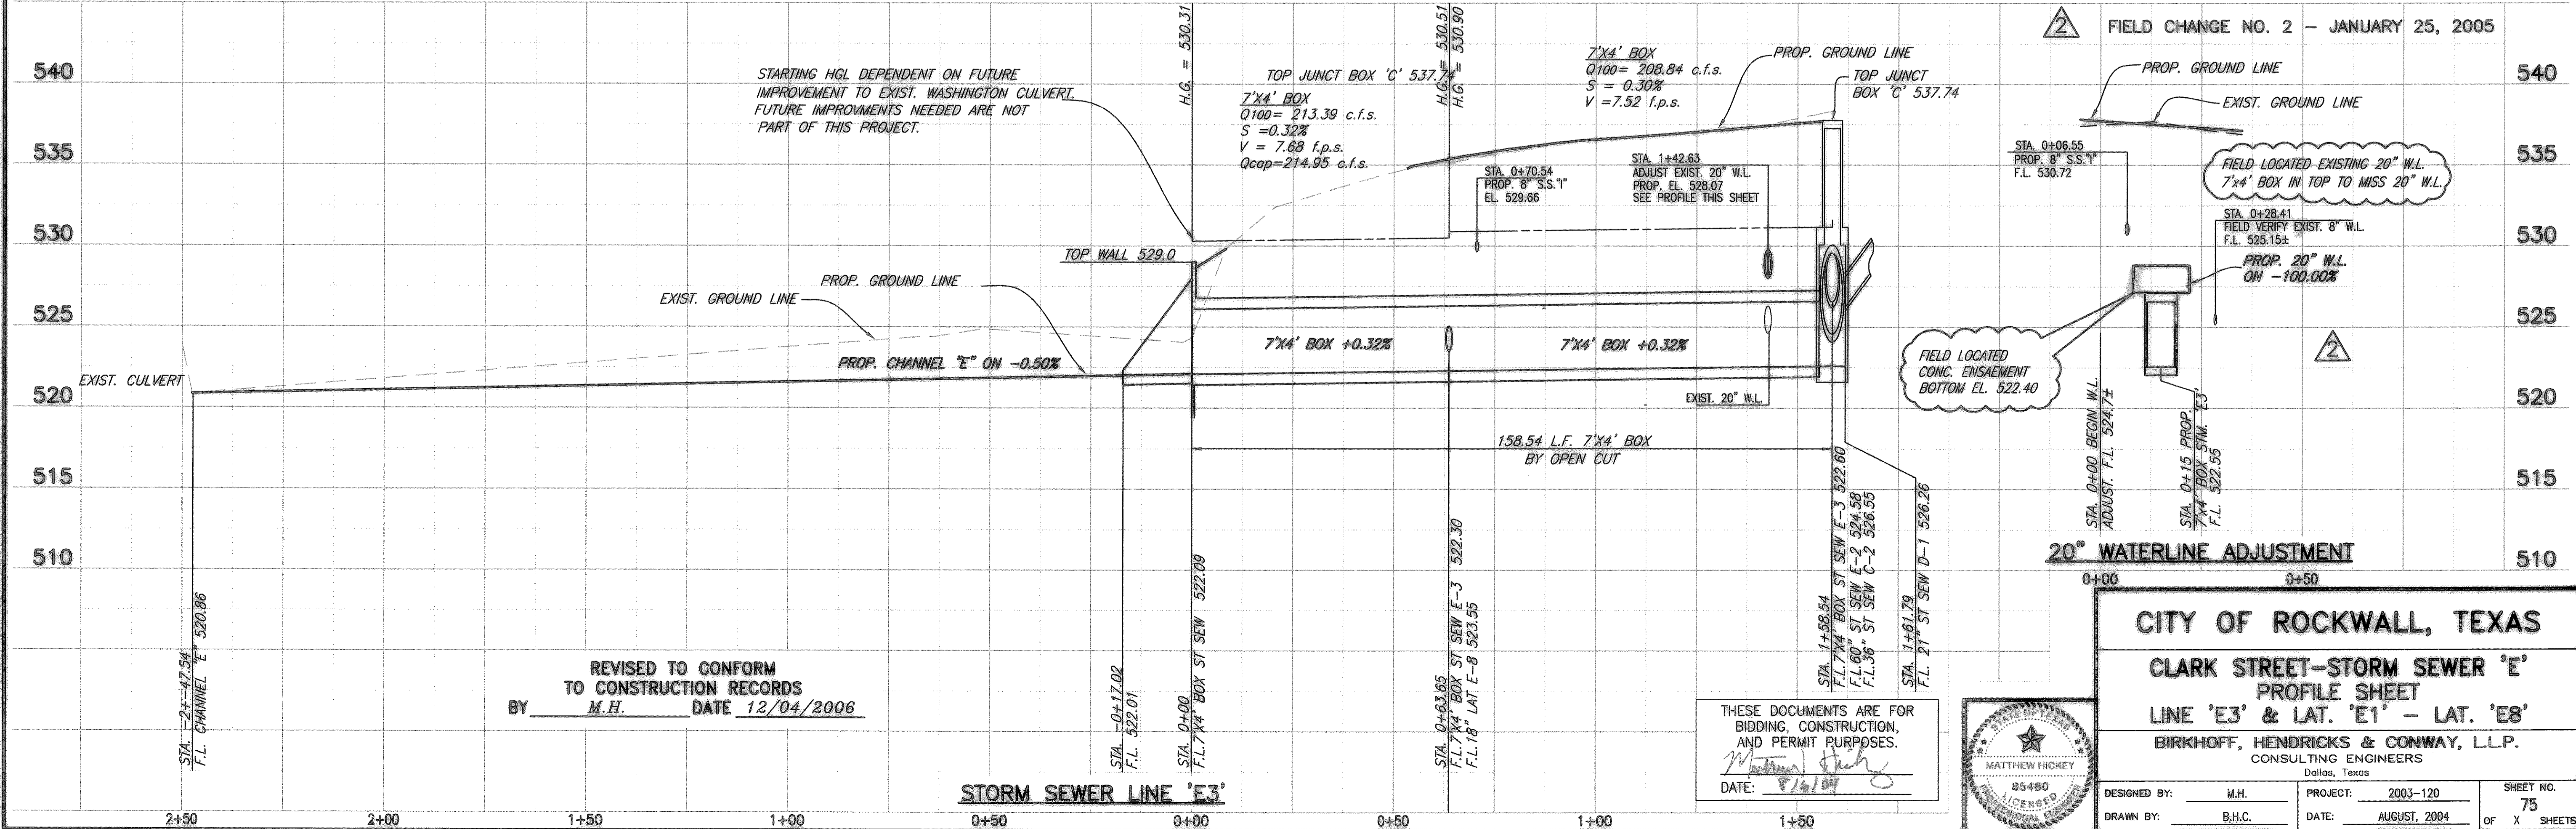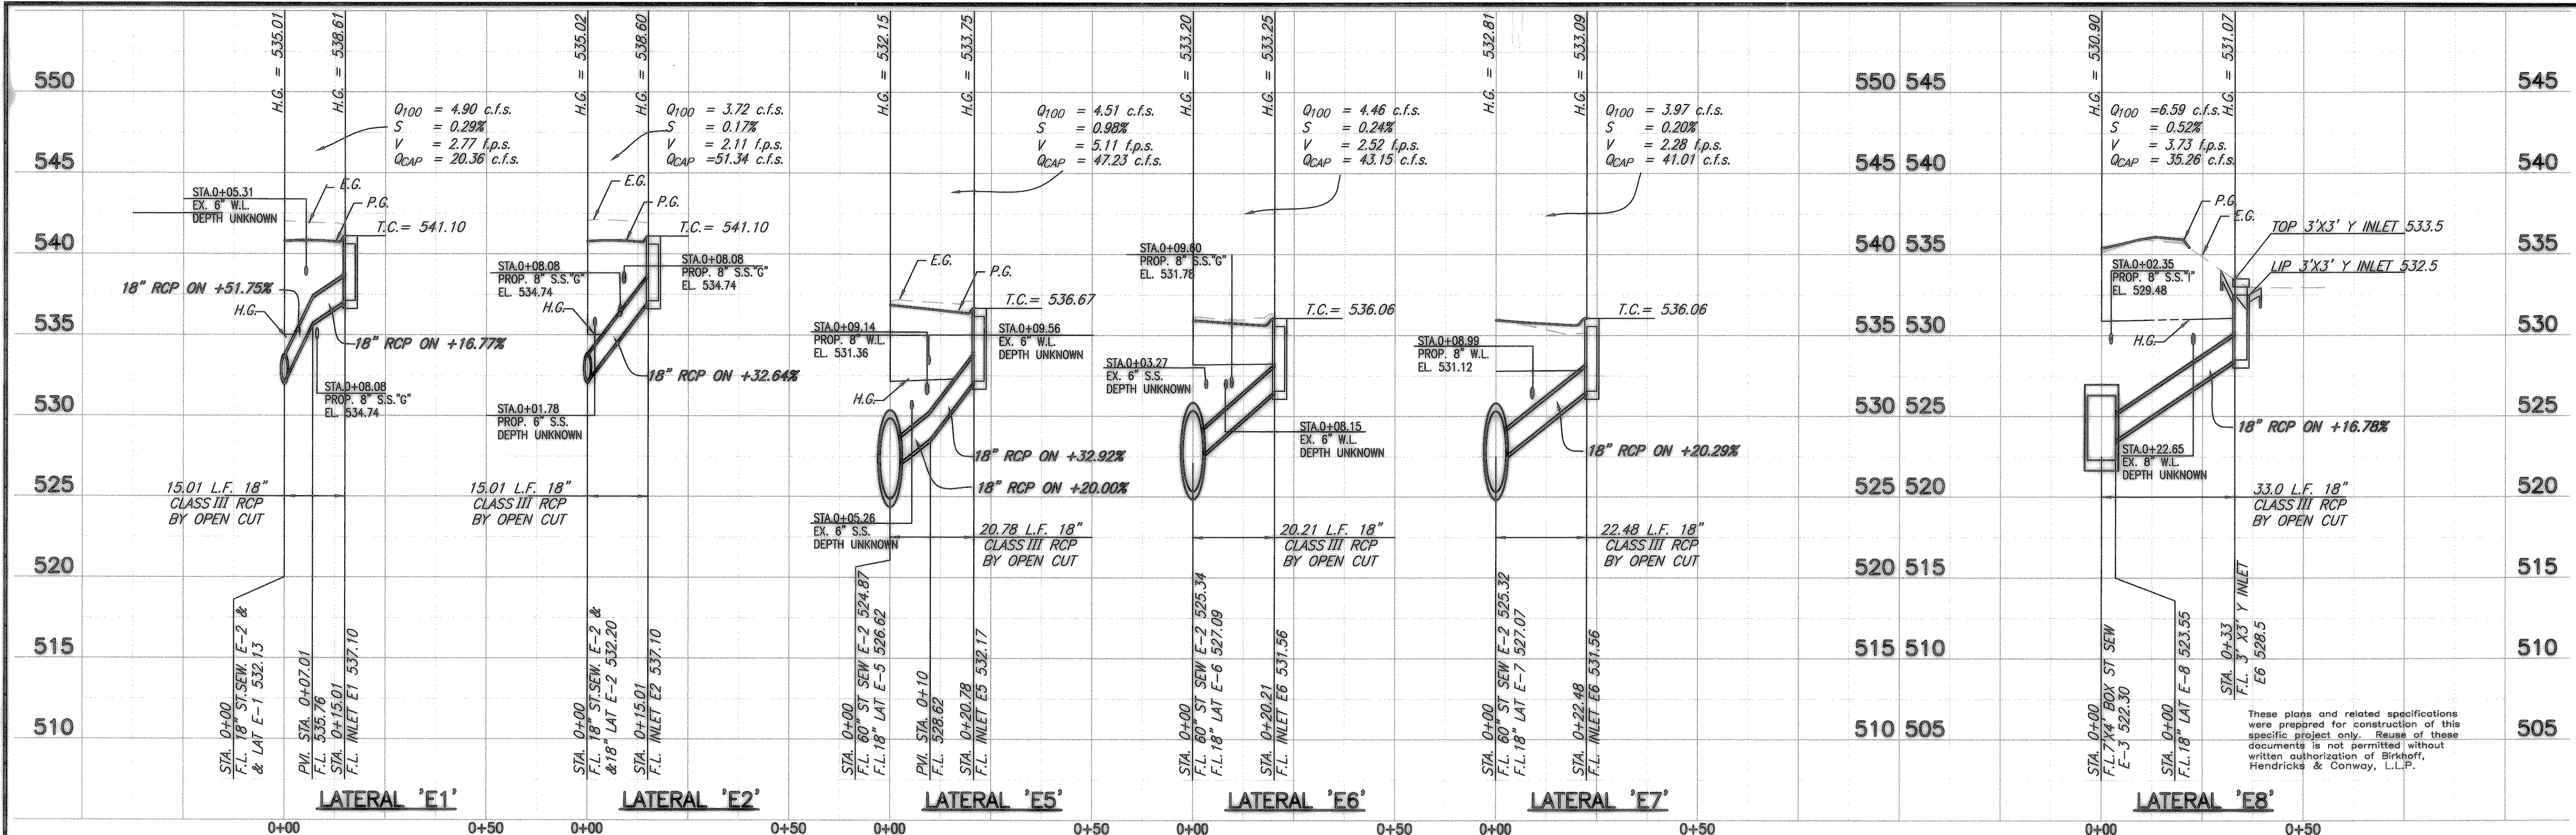

REVISED TO CONFORM
TO CONSTRUCTION RECORDS
BY M.H. DATE 12/04/2006

STORM SEWER LINE 'E3'

THESE DOCUMENTS ARE FOR
BIDDING, CONSTRUCTION,
AND PERMIT PURPOSES.
Matthew Hickey
DATE: 8/6/09

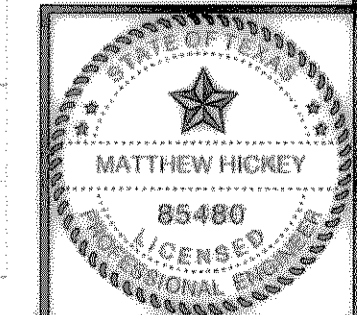

CITY OF ROCKWALL, TEXAS

**CLARK STREET-STORM SEWER 'E'
PROFILE SHEET
LINE 'E3' & LAT. 'E1' - LAT. 'E8'**

BIRKHOFF, HENDRICKS & CONWAY, L.L.P.
CONSULTING ENGINEERS
Dallas, Texas

DESIGNED BY: <u>M.H.</u>	PROJECT: <u>2003-120</u>
DRAWN BY: <u>B.H.C.</u>	DATE: <u>AUGUST, 2004</u>

SHEET NO. 75
OF X SHEETS