



07/16/04 LBS H:\ROCKWALL\2003120\PLAN-SHEETS\2003120-STIM1.DWG SCALE: 1=20 BLOCKS: ROCKWALL\2003120\X.Y XREF: ROCKWALL\2003120\X.Y

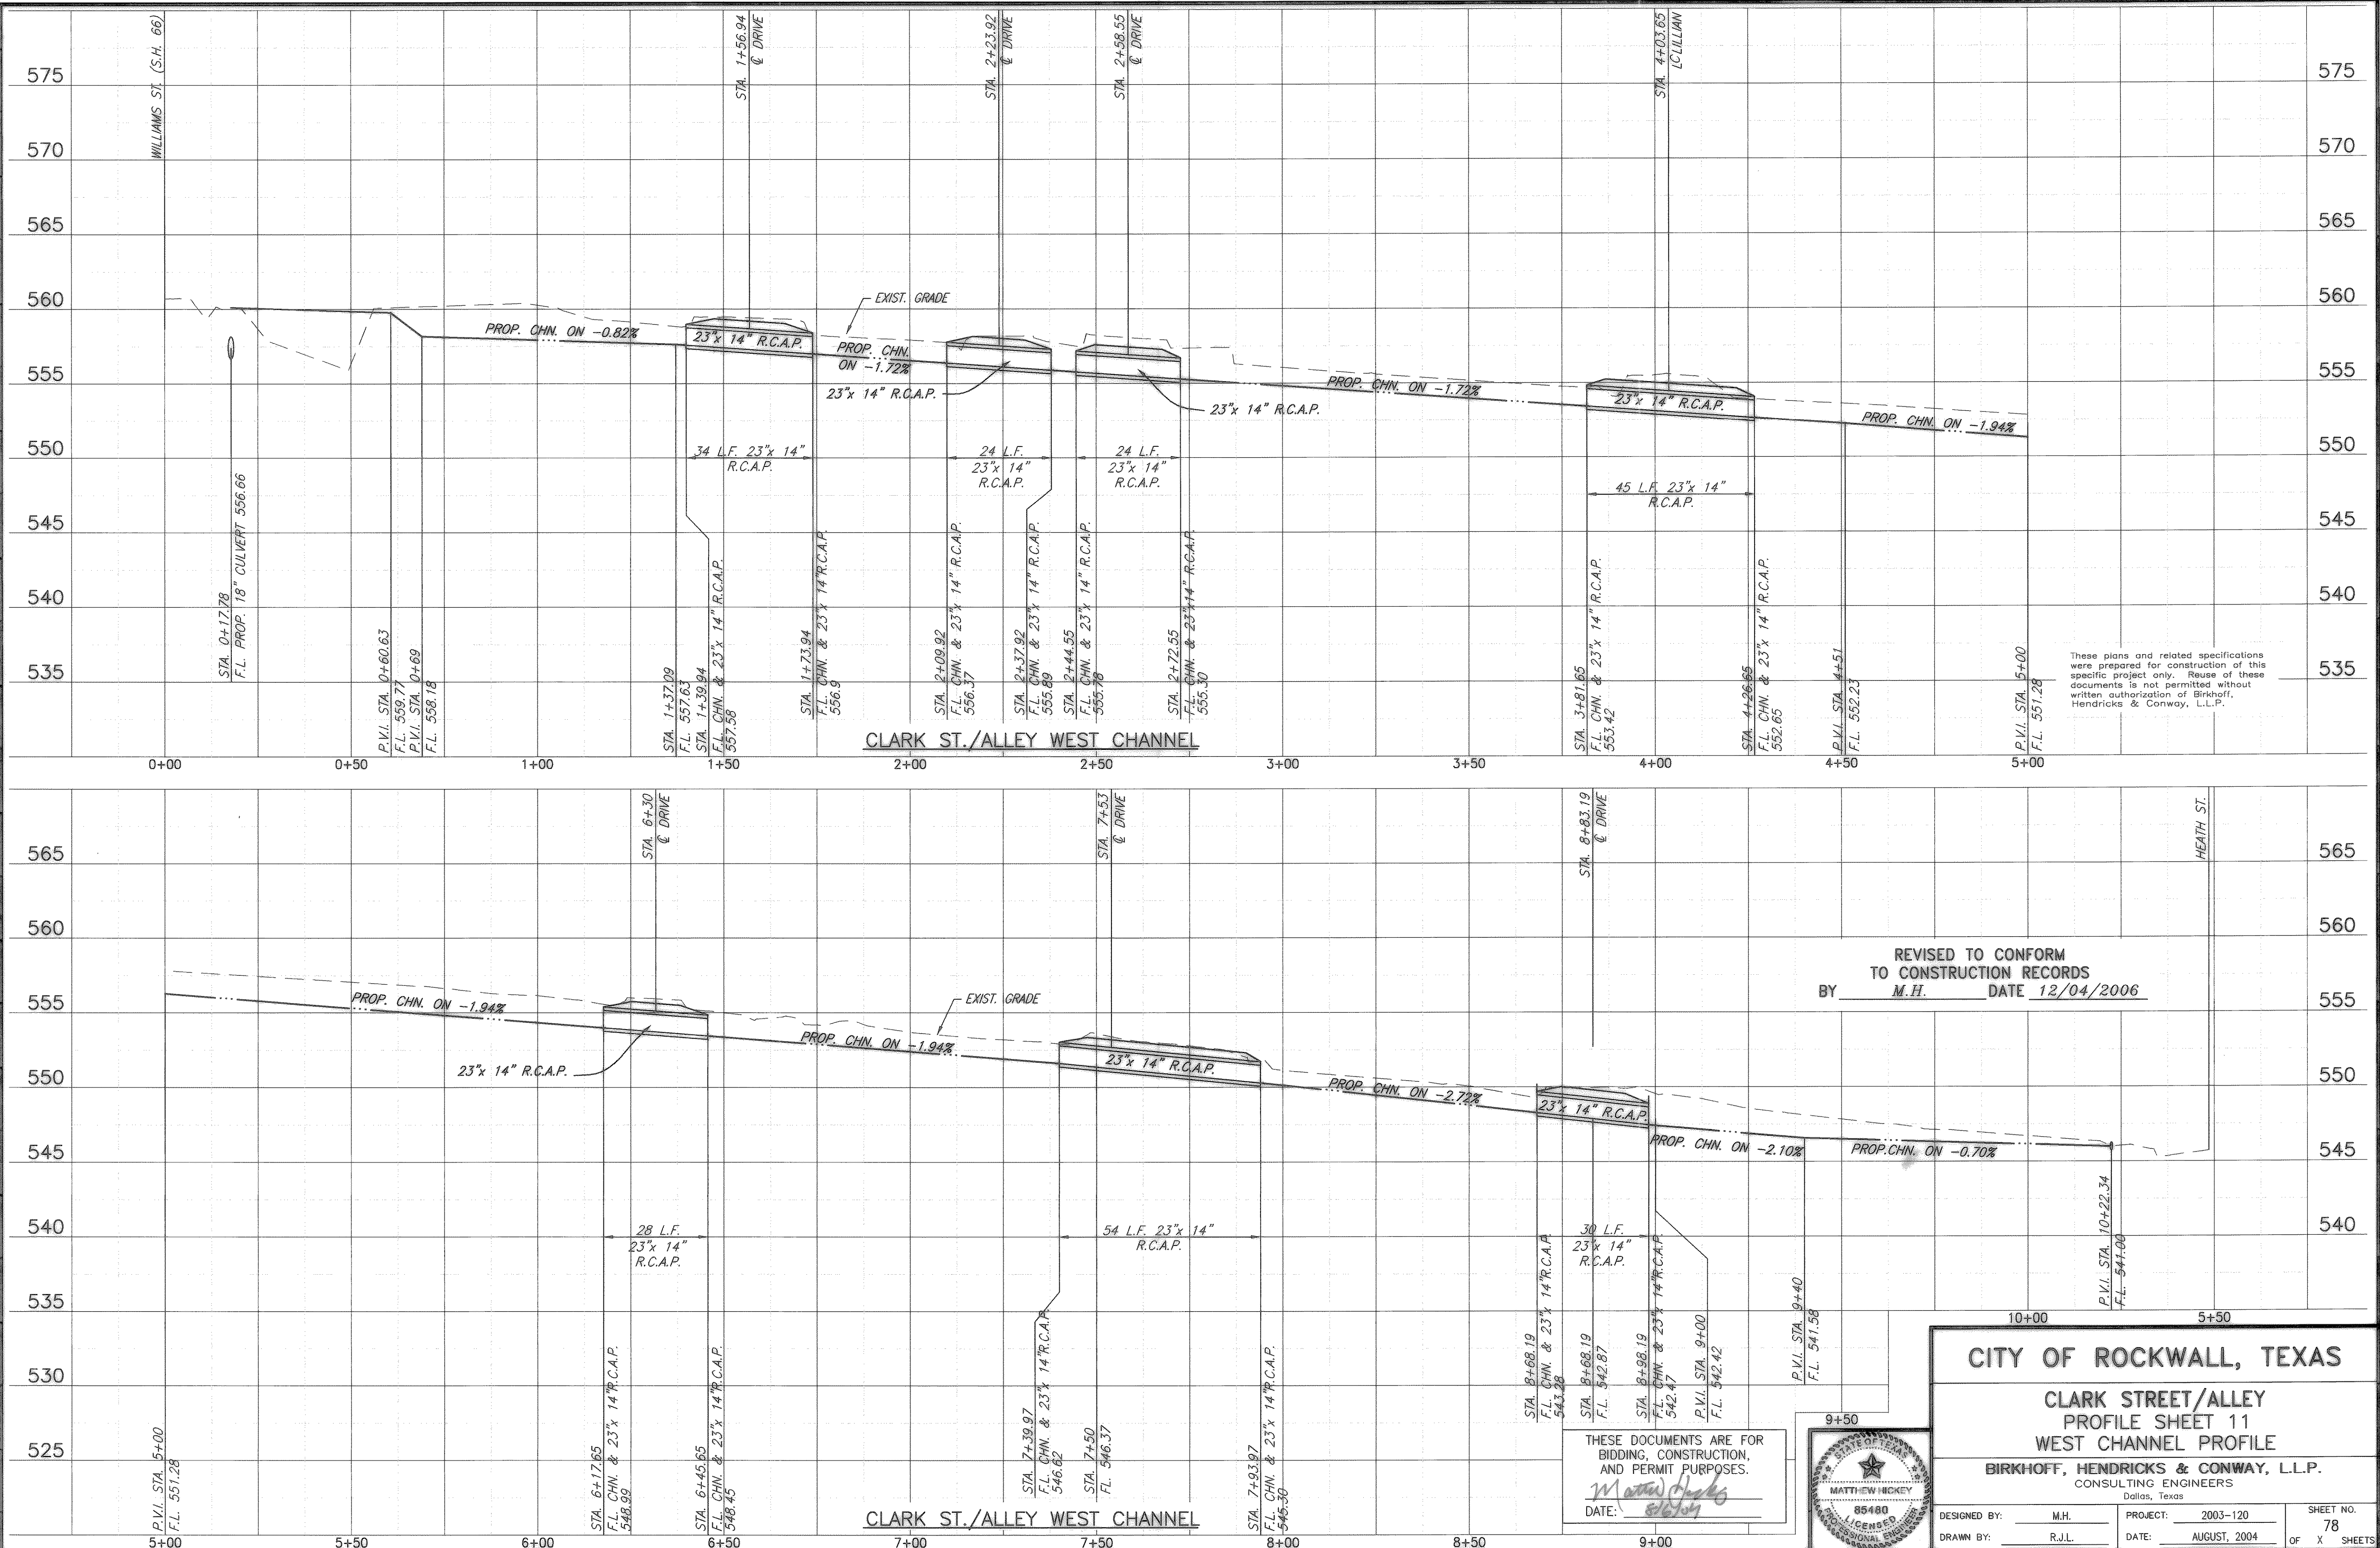

These plans and related specifications were prepared for construction of this specific project only. Reuse of these documents is not permitted without written authorization of Birkhoff, Hendricks & Conway, L.L.P.

REVISED TO CONFORM TO CONSTRUCTION RECORDS  
 BY M.H. DATE 12/04/2006

THESE DOCUMENTS ARE FOR BIDDING, CONSTRUCTION, AND PERMIT PURPOSES.  
 DATE: 8/6/04

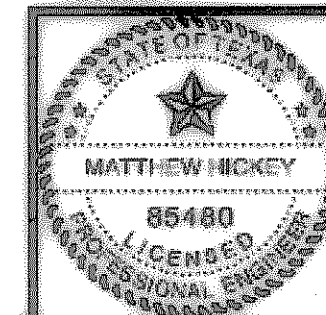

**CITY OF ROCKWALL, TEXAS**  
**CLARK STREET/ALLEY WEST CHANNEL PROFILE SHEET 11**  
**BIRKHOFF, HENDRICKS & CONWAY, L.L.P.**  
 CONSULTING ENGINEERS  
 Dallas, Texas

DESIGNED BY: M.H.	PROJECT: 2003-120	SHEET NO. 78
DRAWN BY: R.J.L.	DATE: AUGUST, 2004	OF X SHEETS