

- LEGEND**
- PROPOSED CONCRETE SIDEWALK
  - PROPOSED CONCRETE CURB & GUTTER
  - PROPOSED BRICK PAVERS

T.B.M. CS  
SQ. CUT ON TOWER BASE SOUTH  
WEST CORNER OF CLARK ST. &  
WASHINGTON ST.  
N:7027488.5763  
E:2596011.4576  
EL=545.17


T.B.M. 2176  
SQ. CUT ON WEST HEADWALL  
OF CLARK ST. & NORTH OF ST.  
MARY ST.  
N:7025946.3986  
E:2596088.3176  
EL=533.99

T.B.M. 2884  
SQ. CUT IN INLET EAST OF CLARK  
ST. & SOUTH OF BOYDSTUN ST.  
N:7025217.8375  
E:2596128.8878  
EL=537.38

POINT	COORDINATE N, E
(A)	N 7026306.3406, E 2596093.5759
(B)	N 7026552.0090, E 2596088.3731
(C)	N 7026575.5947, E 2596087.5680
(D)	N 7026576.1795, E 2596087.5481

REVISED TO CONFORM  
TO CONSTRUCTION RECORDS  
BY M.H. DATE 12/04/2006

THESE DOCUMENTS ARE FOR  
BIDDING, CONSTRUCTION,  
AND PERMIT PURPOSES.  
*Matthew Hickey*  
DATE: 8/6/04

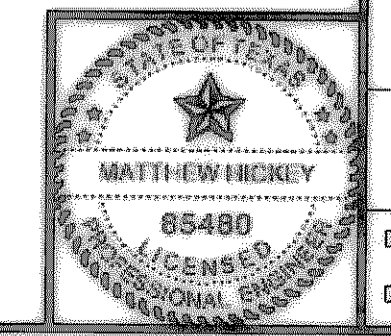

**CITY OF ROCKWALL, TEXAS**

**CLARK STREET  
COORDINATE/DIMENSION PLAN-3  
STA 9+00 TO STA. 14+00**

**BIRKHOFF, HENDRICKS & CONWAY, L.L.P.**  
CONSULTING ENGINEERS  
Dallas, Texas

DESIGNED BY: <u>M.H.</u>	PROJECT: <u>2003-120</u>	SHEET NO. <u>6</u>
DRAWN BY: <u>B.H.C.</u>	DATE: <u>AUGUST, 2004</u>	OF <u>X</u> SHEETS

08/05/04 CAG H:\ROCKWALL\2003\20\PLAN-SHEETS\2003\20-COORD-03.DWG SCALE: 1"=20' XREF: ROCKWALL\2003\20\BASE\PROP-BASE