


KAUFMAN W.L. MATCH LINE STA. 1+70 (SEE SH. 49)

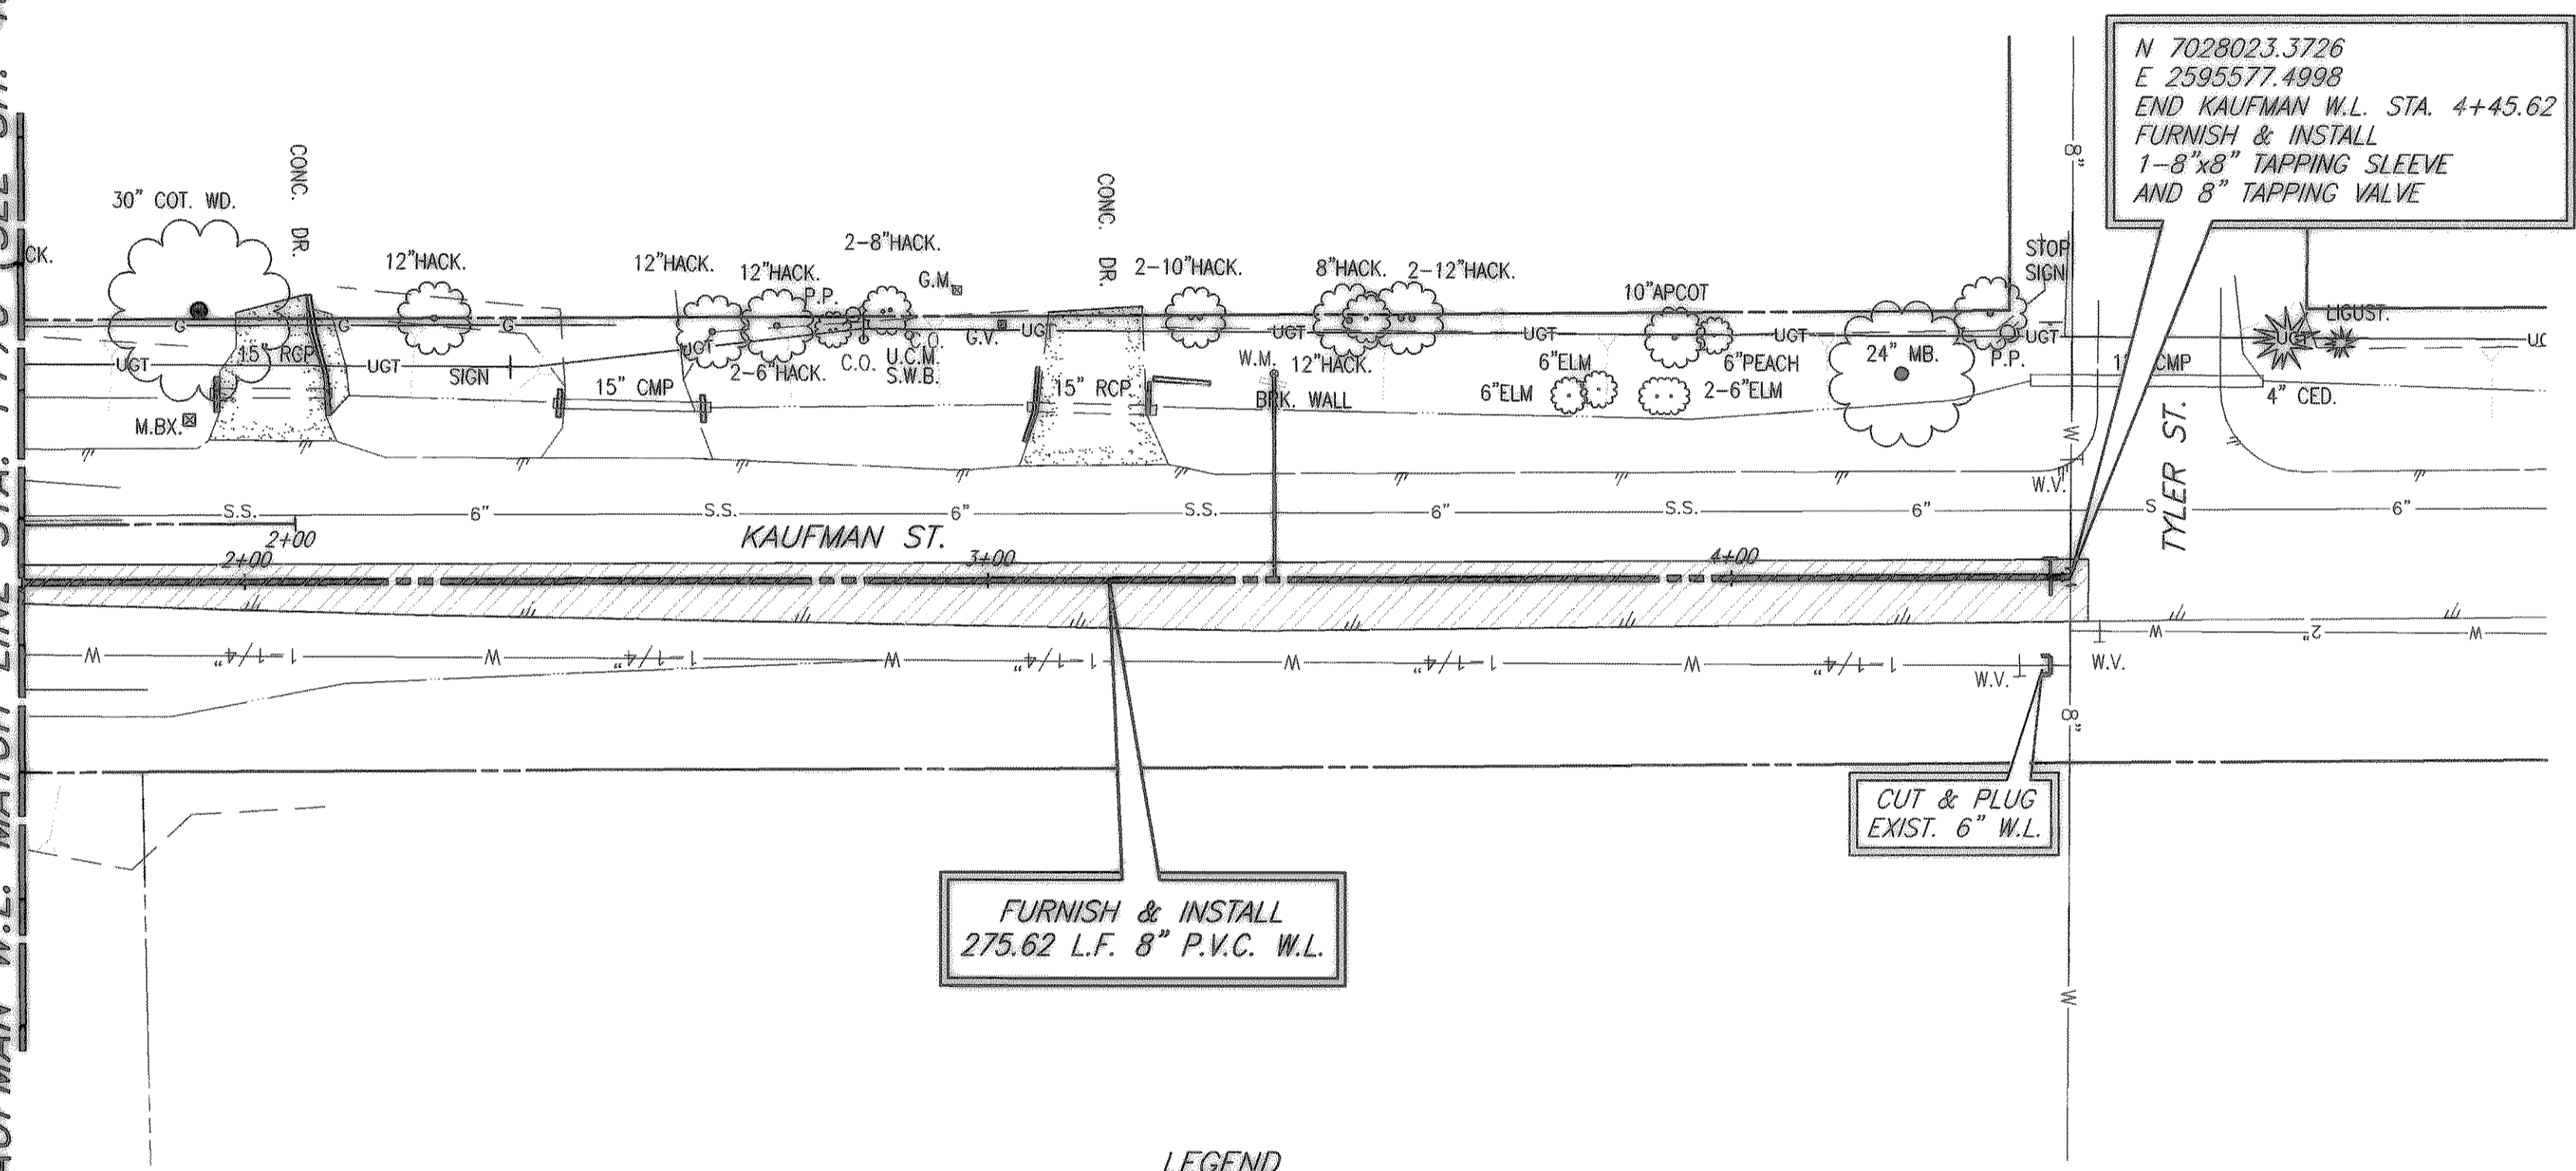

N 7028023.3726
E 2595577.4998
END KAUFMAN W.L. STA. 4+45.62
FURNISH & INSTALL
1-8"x8" TAPPING SLEEVE
AND 8" TAPPING VALVE

FURNISH & INSTALL
275.62 L.F. 8" P.V.C. W.L.

CUT & PLUG
EXIST. 6" W.L.

LEGEND

- — PROPOSED WATER SERVICE
- — PROPOSED SEWER SERVICE
- ▨ — HMAC PVMT. REPLACEMENT

PROPOSED KAUFMAN ST. WATER SERVICES

LOCATION	PROPOSED 1 INCH SERVICE
W.L. STA. 3+38.58	28 L.F. (LT.)
TOTAL: 28 L.F.	
FURNISH & INSTALL PROP. 1" OUTLET AND NEW 1" SDR-9 (POLYTUBE) WATER SERVICE. TRANSFER OF WATER SERVICE SHALL INCLUDE METER BOX, FITTINGS, 1" SERVICE SADDLE, CONNECTION TO EXISTING SERVICE, AND INSTALLATION OF CITY PROVIDED METER AND SHALL BE PAID ON A PER EACH BASIS.	

REVISED TO CONFORM
TO CONSTRUCTION RECORDS
BY M.H. DATE 12/04/2006

THESE DOCUMENTS ARE FOR
BIDDING, CONSTRUCTION,
AND PERMIT PURPOSES.
Matthew Hickey
DATE: 8/6/04



CITY OF ROCKWALL, TEXAS

**CLARK STREET
KAUFMAN WEST W.L. PLAN
W.L. STA. 1+70 TO END**

BIRKHOFF, HENDRICKS & CONWAY, L.L.P.
CONSULTING ENGINEERS
Dallas, Texas

DESIGNED BY: <u>M.H.</u>	PROJECT: <u>2003-120</u>	SHEET NO. <u>49</u>
DRAWN BY: <u>B.H.C.</u>	DATE: <u>AUGUST, 2004</u>	OF <u>X</u> SHEETS

These plans and related specifications were prepared for construction of this specific project only. Reuse of these documents is not permitted without written authorization of Birkhoff, Hendricks & Conway, L.L.P.

08/07/04 CAG H:\ROCKWALL\2003120\PLAN-SHEETS\2003120-SAN-WL-16.DWG BLOCKS: ROCKWALL\2003120\X.Y REF: ROCKWALL\2003120\X.Y