



H:\ROCKWALL\2003-120\PLAN-SHEETS\2003120-DRN-AREA.DWG SCALE: 1"=200 XREF: ROCKWALL\2003120\DRAINAGE AREA E3.TOP.DWG 07/21/04 CAG

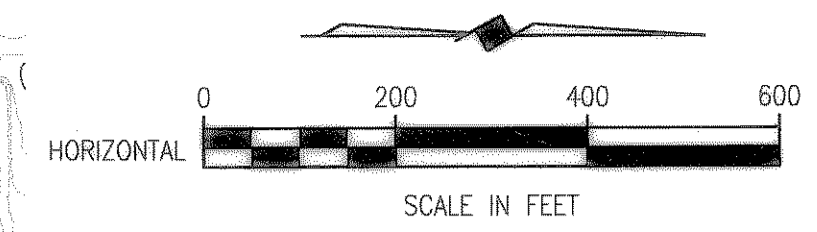

REVISED TO CONFORM
TO CONSTRUCTION RECORDS
BY M.H. DATE 12/04/2006

THESE DOCUMENTS ARE FOR
BIDDING, CONSTRUCTION,
AND PERMIT PURPOSES.
Matthew Hickey
DATE: 8/6/04

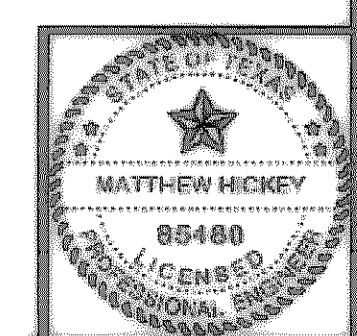

CITY OF ROCKWALL, TEXAS
CLARK STREET-STORM SEWER
OVERALL DRAINAGE AREA MAP

BIRKHOFF, HENDRICKS & CONWAY, L.L.P.
CONSULTING ENGINEERS
Dallas, Texas

DESIGNED BY: <u>M.H.</u>	PROJECT: <u>2003-120</u>	SHEET NO. <u>56</u>
DRAWN BY: <u>X.X.X.</u>	DATE: <u>AUGUST, 2004</u>	OF <u>X</u> SHEETS