


**LEGEND**

- CONSTRUCT H.M.A.C. PAVEMENT
- CONSTRUCT REINF. CONC. CURB & GUTTER
- CONSTRUCT REINF. CONC. SIDEWALK
- CONSTRUCT BRICK PAVERS
- CONSTRUCT REINF. CONC. DRIVEWAY
- CONSTRUCT GRAVEL DRIVEWAY
- PROPOSED TREEWELL

T.B.M. CS  
 SQ. CUT ON TOWER BASE SOUTH  
 WEST CORNER OF CLARK ST. &  
 WASHINGTON ST.  
 N:7027488.5763  
 E:2596011.4576  
 EL=545.17

T.B.M. 2176  
 SQ. CUT ON WEST HEADWALL  
 OF CLARK ST. & NORTH OF ST.  
 MARY ST.  
 N:7025946.3986  
 E:2596088.3176  
 EL=533.99

These plans and related specifications  
 were prepared for construction of this  
 specific project only. Reuse of these  
 documents is not permitted without  
 written authorization of Birkhoff,  
 Hendricks & Conway, L.L.P.

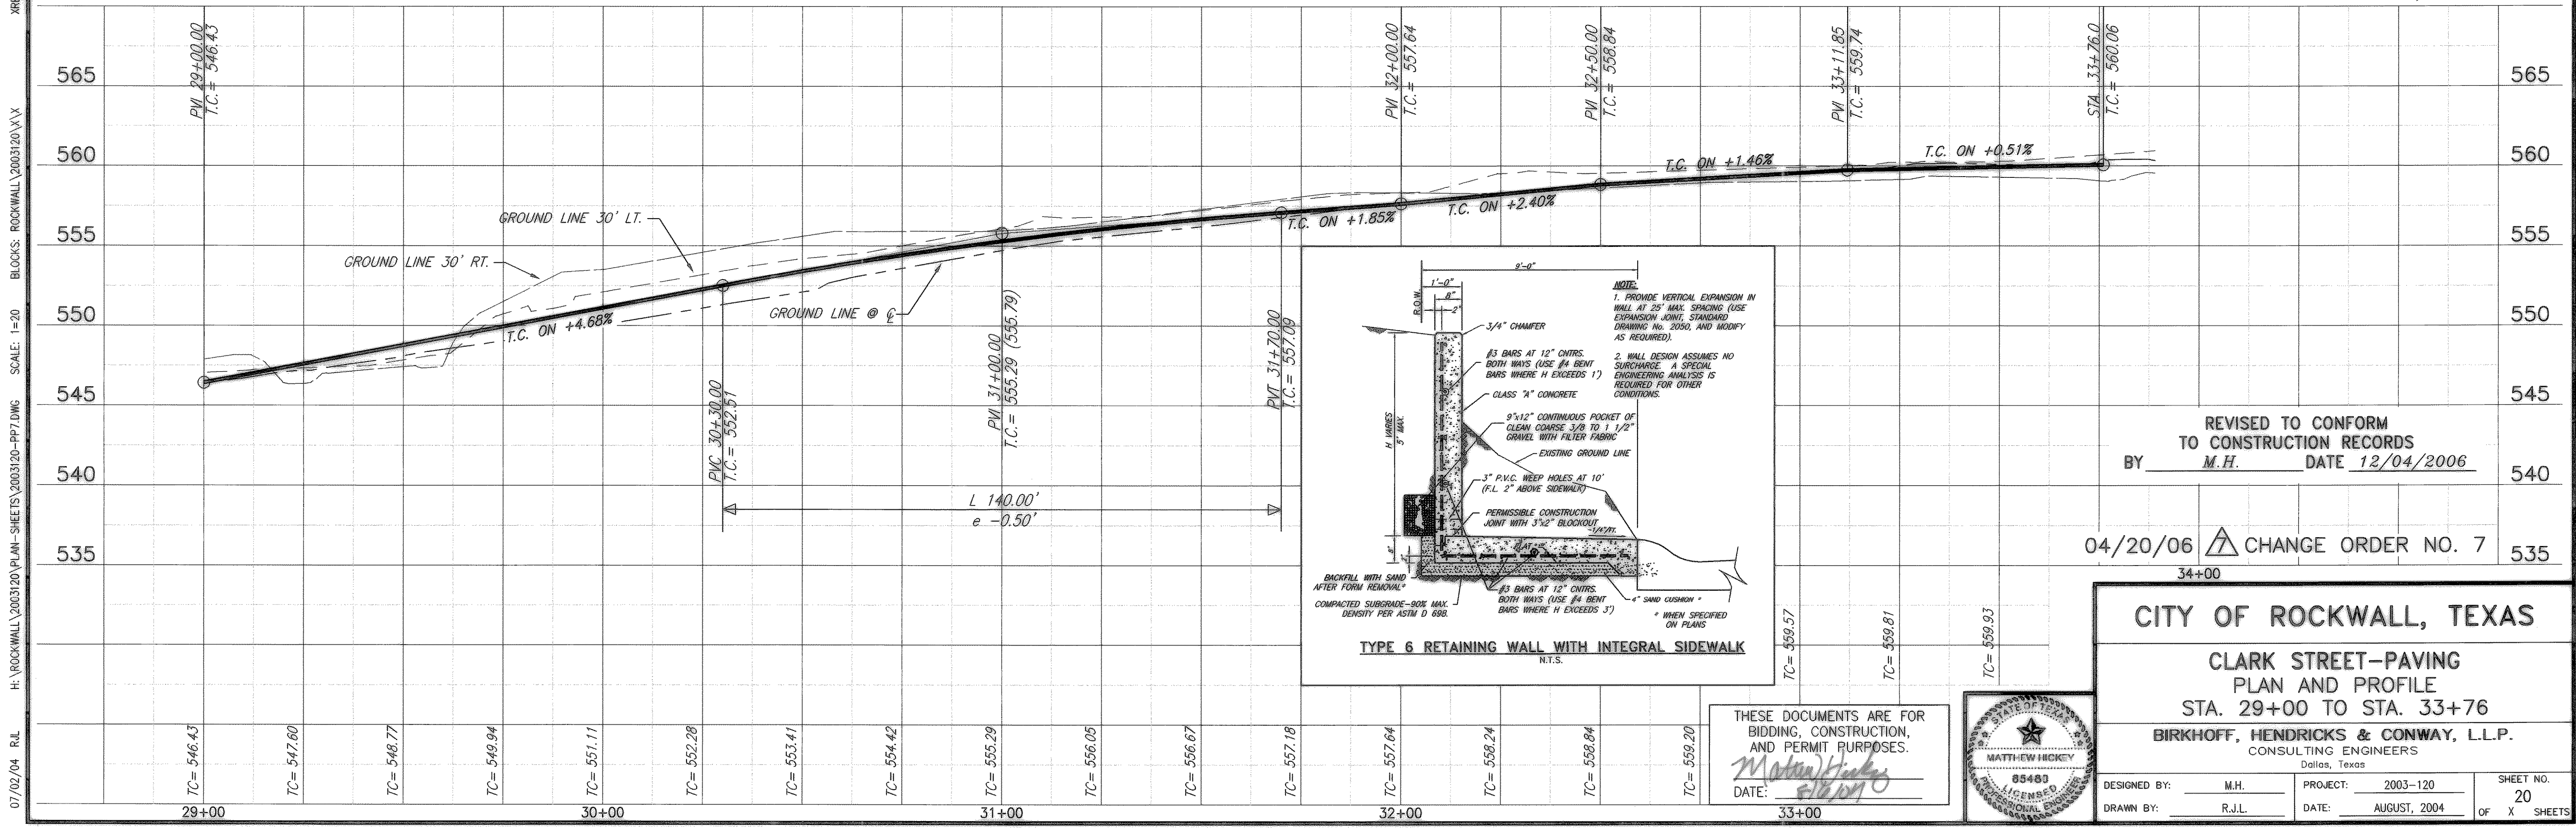

07/02/04 R.L.  
 H:\ROCKWALL\2003120\PLAN-SHEETS\2003120-PP7.DWG SCALE: 1=20  
 BLOCKS: ROCKWALL\2003120\X.V.X  
 PREP: ROCKWALL\2003120\X.V.X