








LEGEND

-  CONSTRUCT REINFORCED CONC. SIDEWALK
-  PROPOSED TURF REINFORCED MAT W/HYDROMULCH SEED

NOTE
FOR EXPANSION JOINT SPACING & MATERIALS REFER TO NCTCOG STANDARD DETAILS DRAWING NO. 2170.

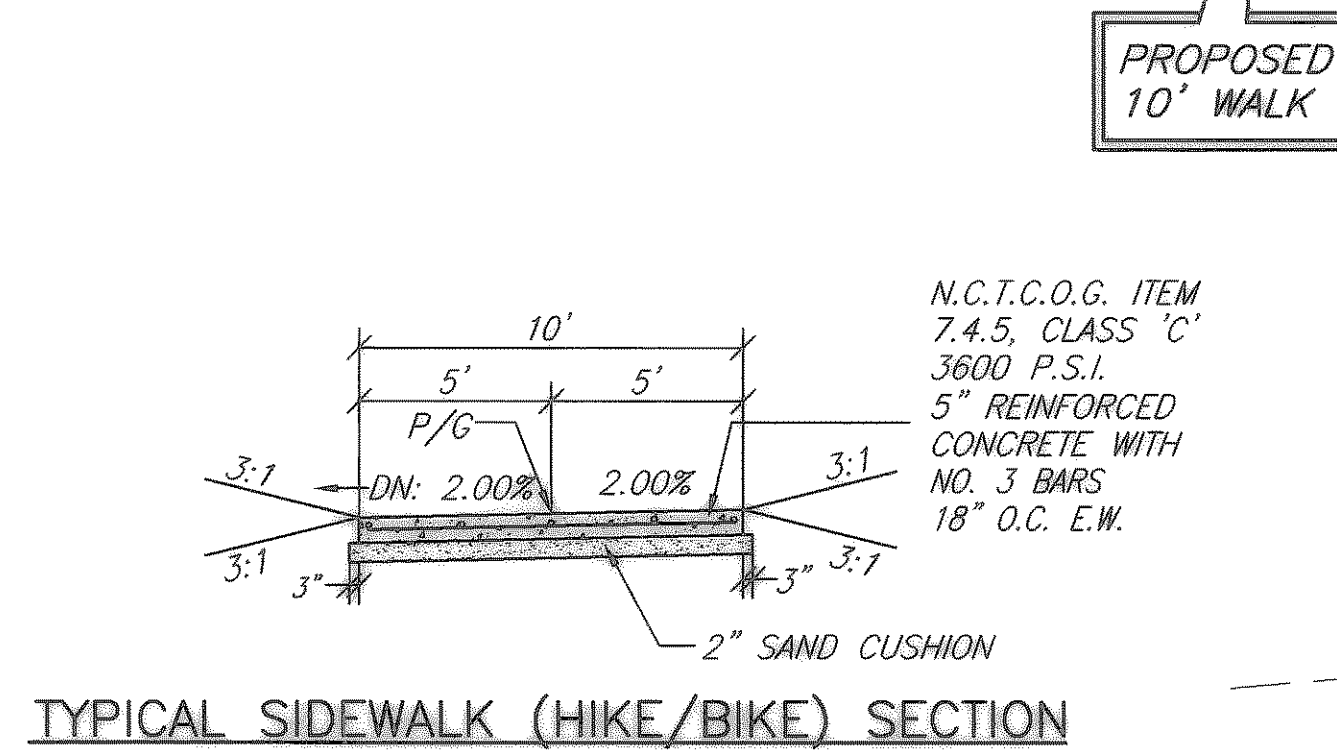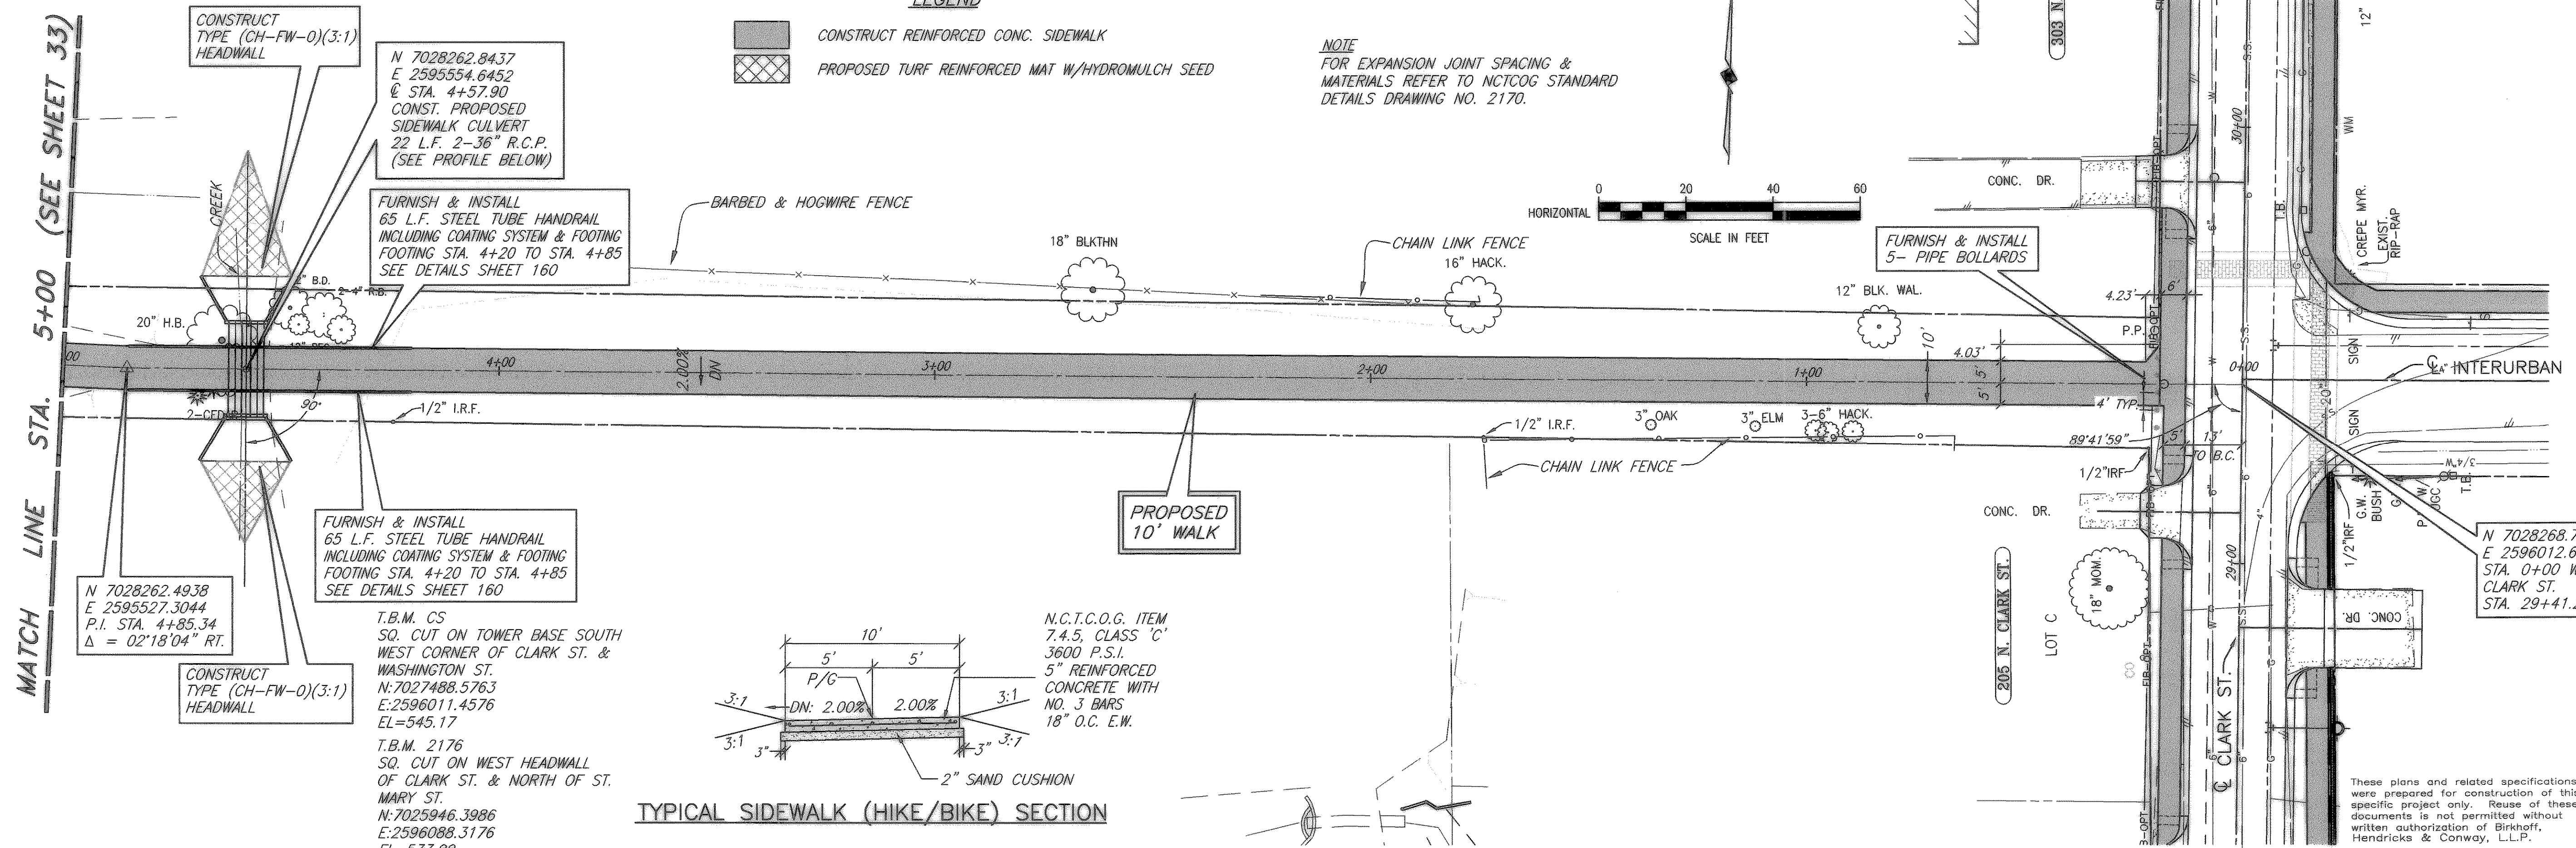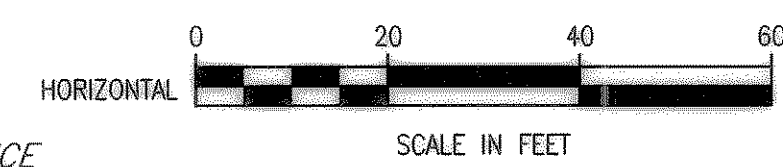


These plans and related specifications were prepared for construction of this specific project only. Reuse of these documents is not permitted without written authorization of Birkhoff, Hendricks & Conway, L.L.P.

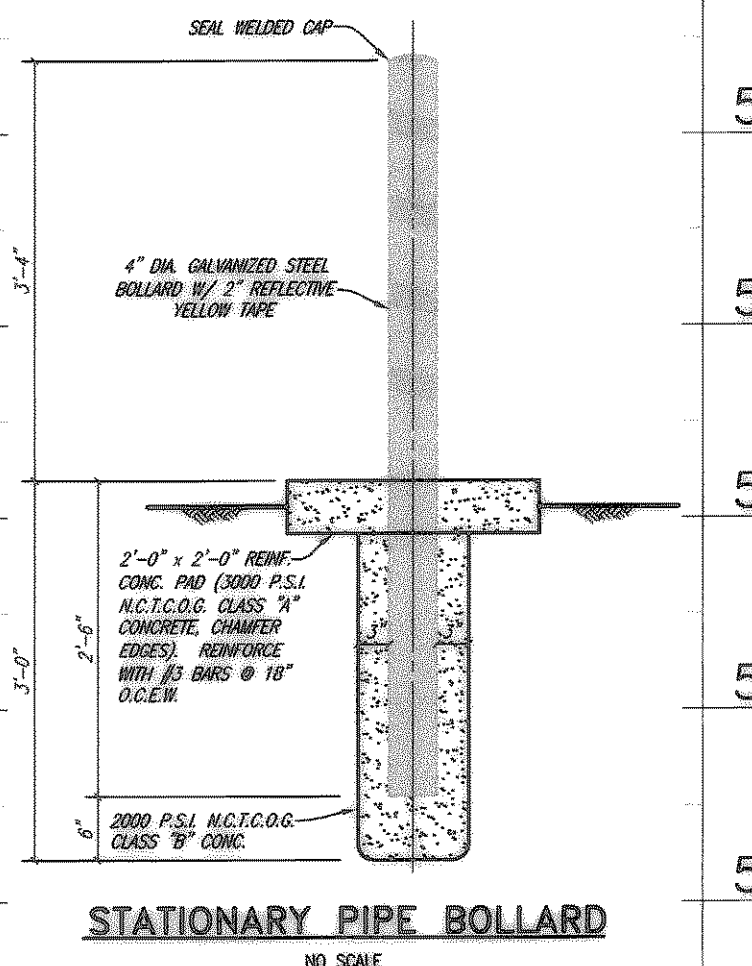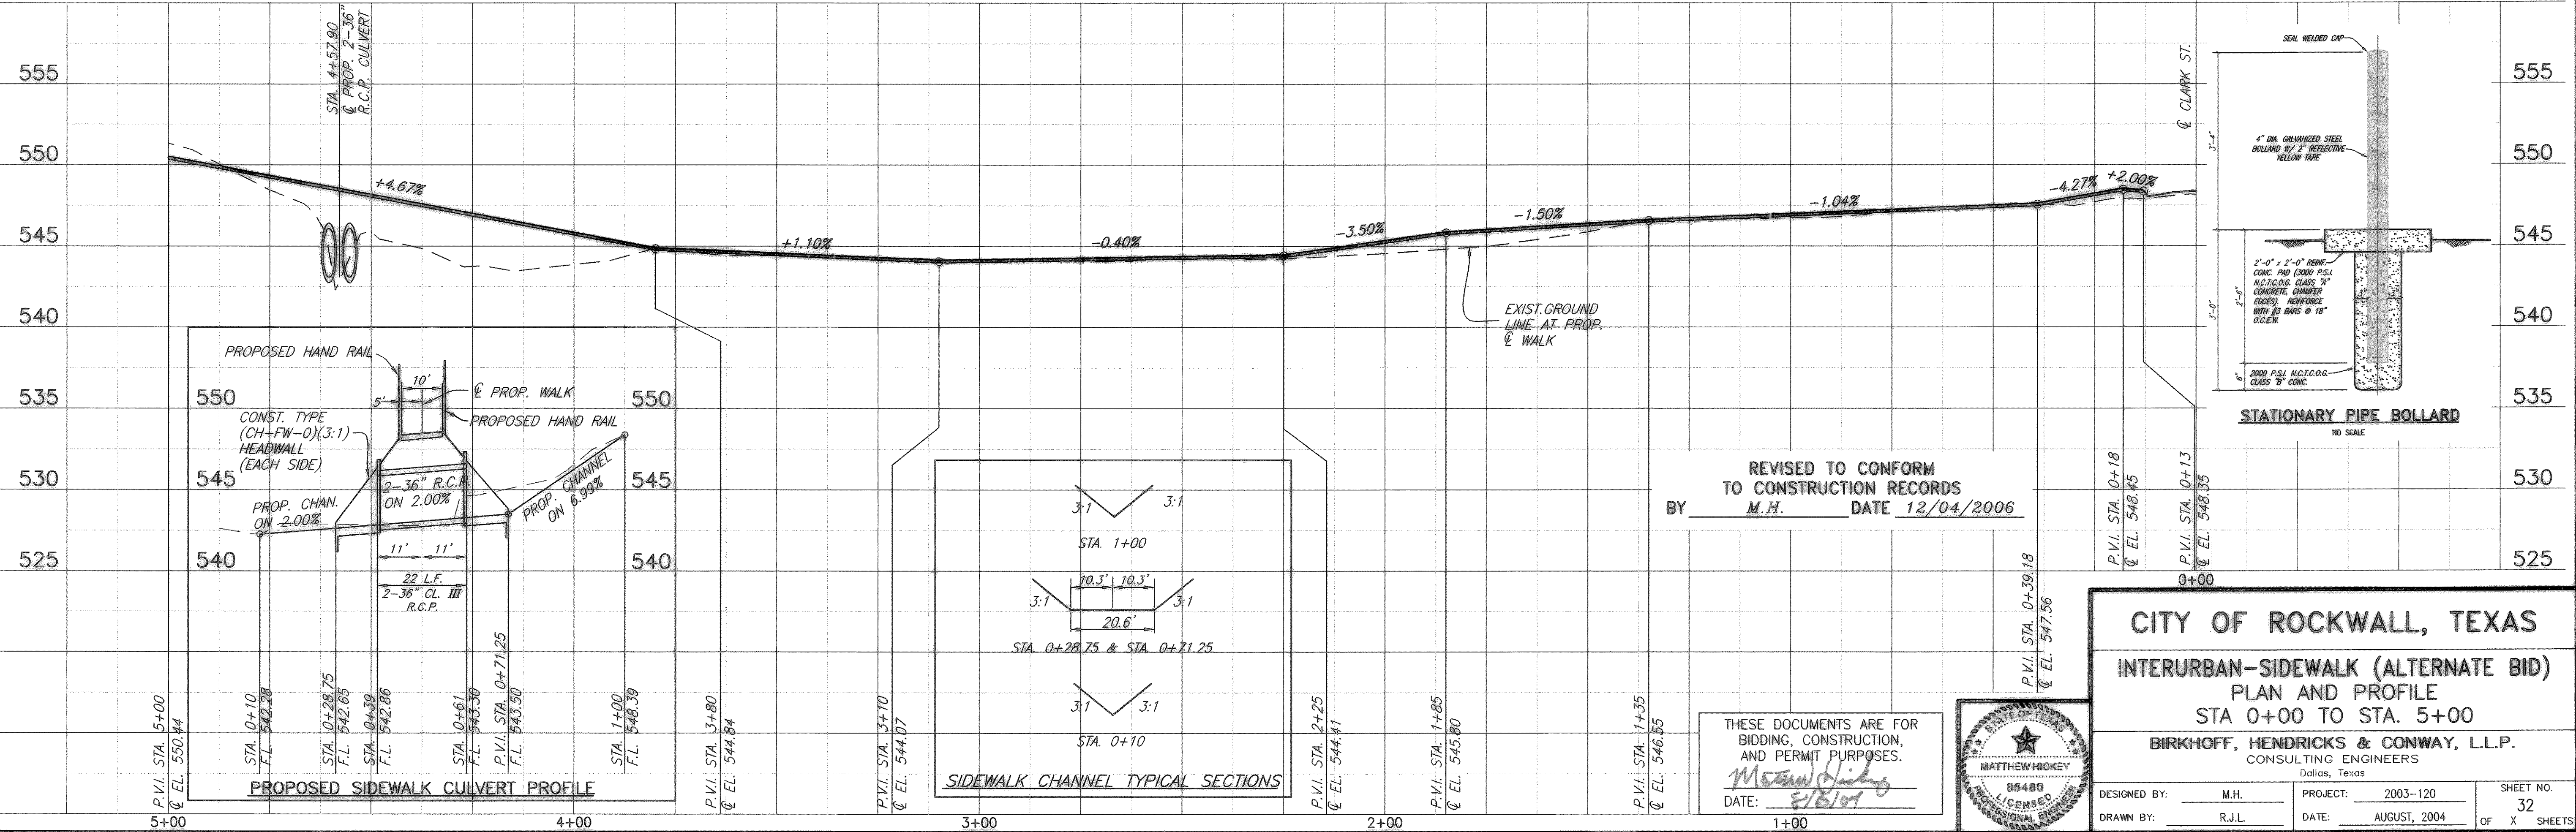

REVISED TO CONFORM TO CONSTRUCTION RECORDS
BY M.H. DATE 12/04/2006

THESE DOCUMENTS ARE FOR BIDDING, CONSTRUCTION, AND PERMIT PURPOSES.
Matthew Hickey
DATE: 8/15/07

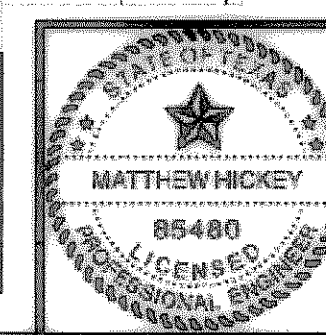

CITY OF ROCKWALL, TEXAS
INTERURBAN-SIDEWALK (ALTERNATE BID)
PLAN AND PROFILE
STA 0+00 TO STA. 5+00

BIRKHOFF, HENDRICKS & CONWAY, L.L.P.
CONSULTING ENGINEERS
Dallas, Texas

DESIGNED BY: M.H.	PROJECT: 2003-120	SHEET NO. 32
DRAWN BY: R.J.L.	DATE: AUGUST, 2004	OF X SHEETS

08/09/04 CAG H:\ROCKWALL\2003120\PLAN-SHEETS\2003120-10-WALK-PP1.DWG SCALE: 1=20 BLOCKS: ROCKWALL\2003120\X.Y. XREF: ROCKWALL\2003120\X.Y.