


These plans and related specifications were prepared for construction of this specific project only. Reuse of these documents is not permitted without written authorization of Birkhoff, Hendricks & Conway, L.L.P.

REVISED TO CONFORM TO CONSTRUCTION RECORDS  
 BY M.H. DATE 12/04/2006

THESE DOCUMENTS ARE FOR BIDDING, CONSTRUCTION, AND PERMIT PURPOSES.  
 DATE: 12/12/04

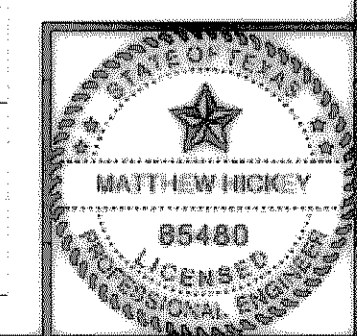

**CITY OF ROCKWALL, TEXAS**

**CLARK STREET-SANITARY SEWER PROFILE SHEET**

**SANITARY SEWER LINES A, B, & C**

**BIRKHOFF, HENDRICKS & CONWAY, L.L.P.**  
 CONSULTING ENGINEERS  
 Dallas, Texas

DESIGNED BY: M.H. PROJECT: 2003-120 SHEET NO. 51  
 DRAWN BY: B.H.C. DATE: AUGUST, 2004 OF X SHEETS