

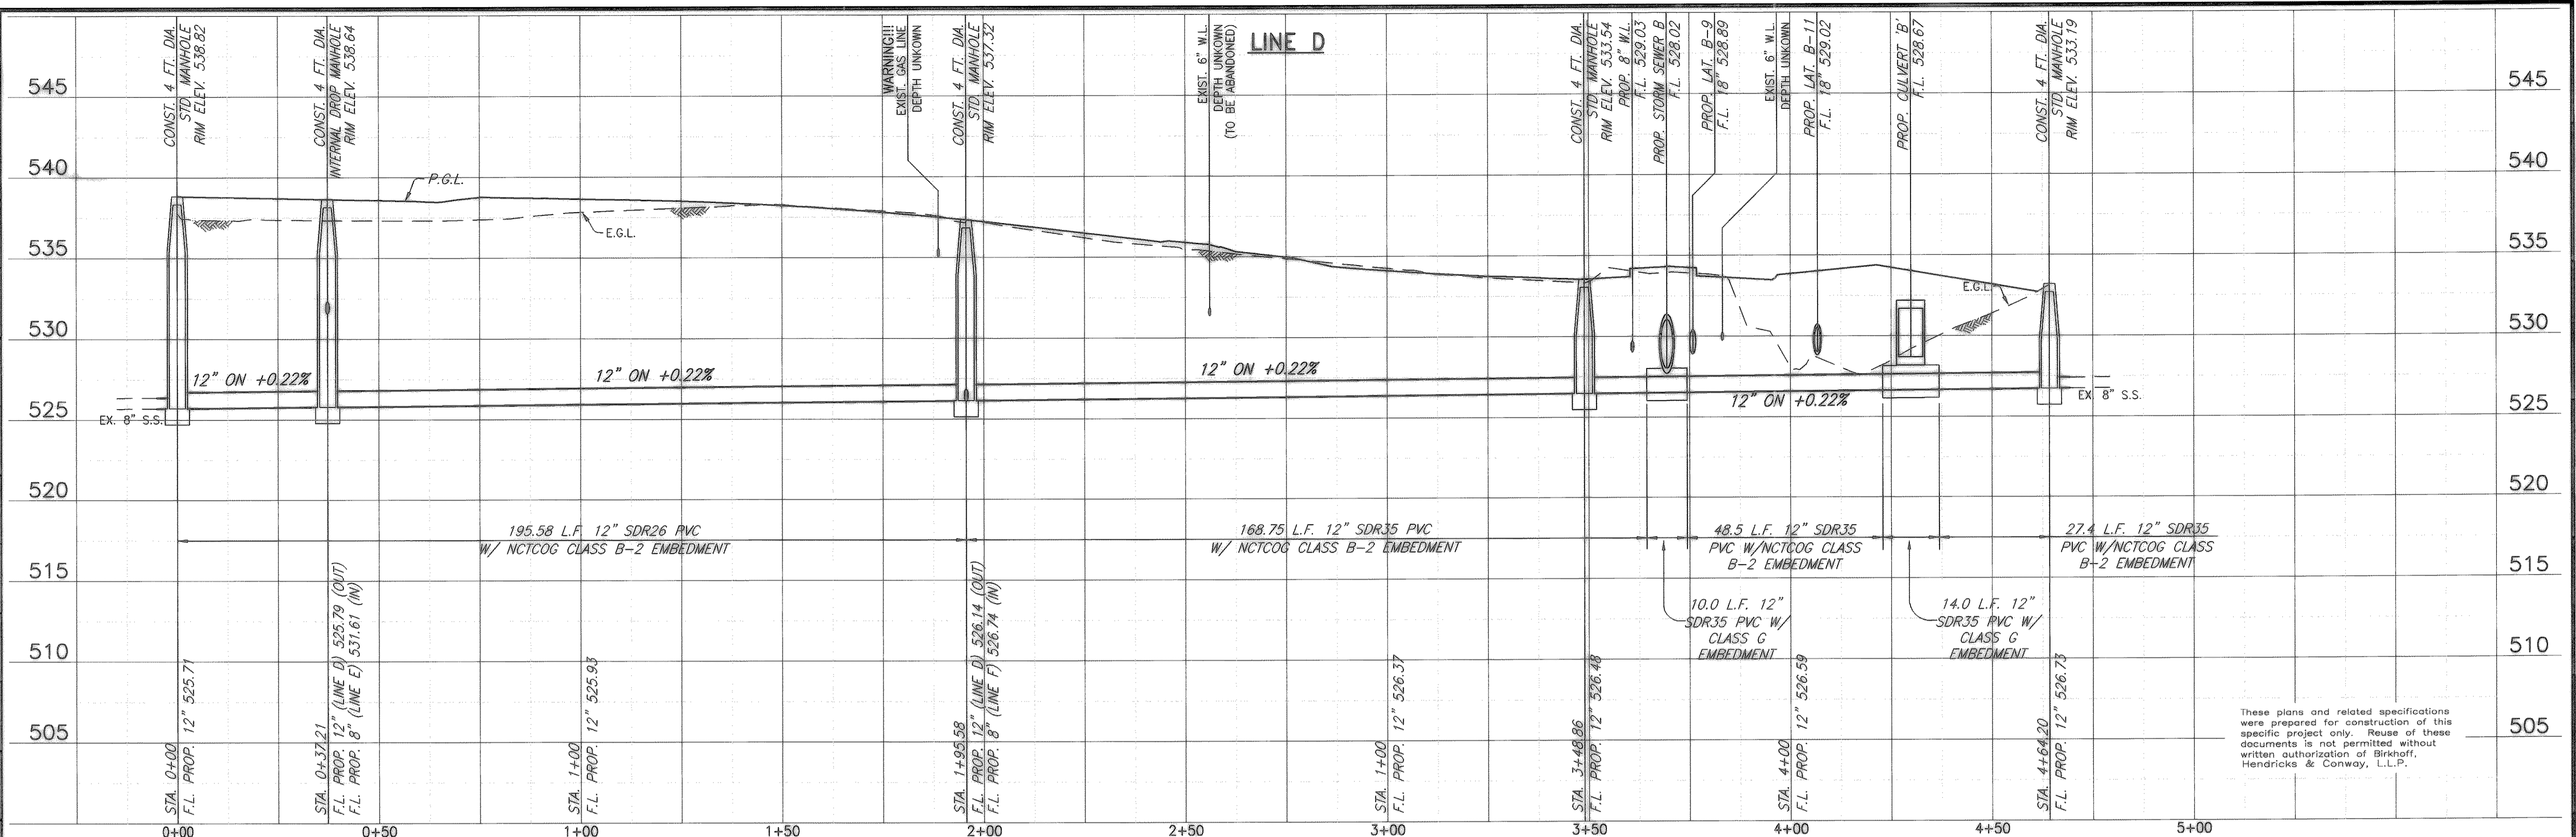


08/21/04 R.L. H:\ROCKWALL\2003120\PLAN-SHEETS\2003120-SAN-PRO-2.DWG SCALE: 1"=20' BLOCKS: ROCKWALL\2003120\X.Y. XREF: ROCKWALL\2003120\X.Y.

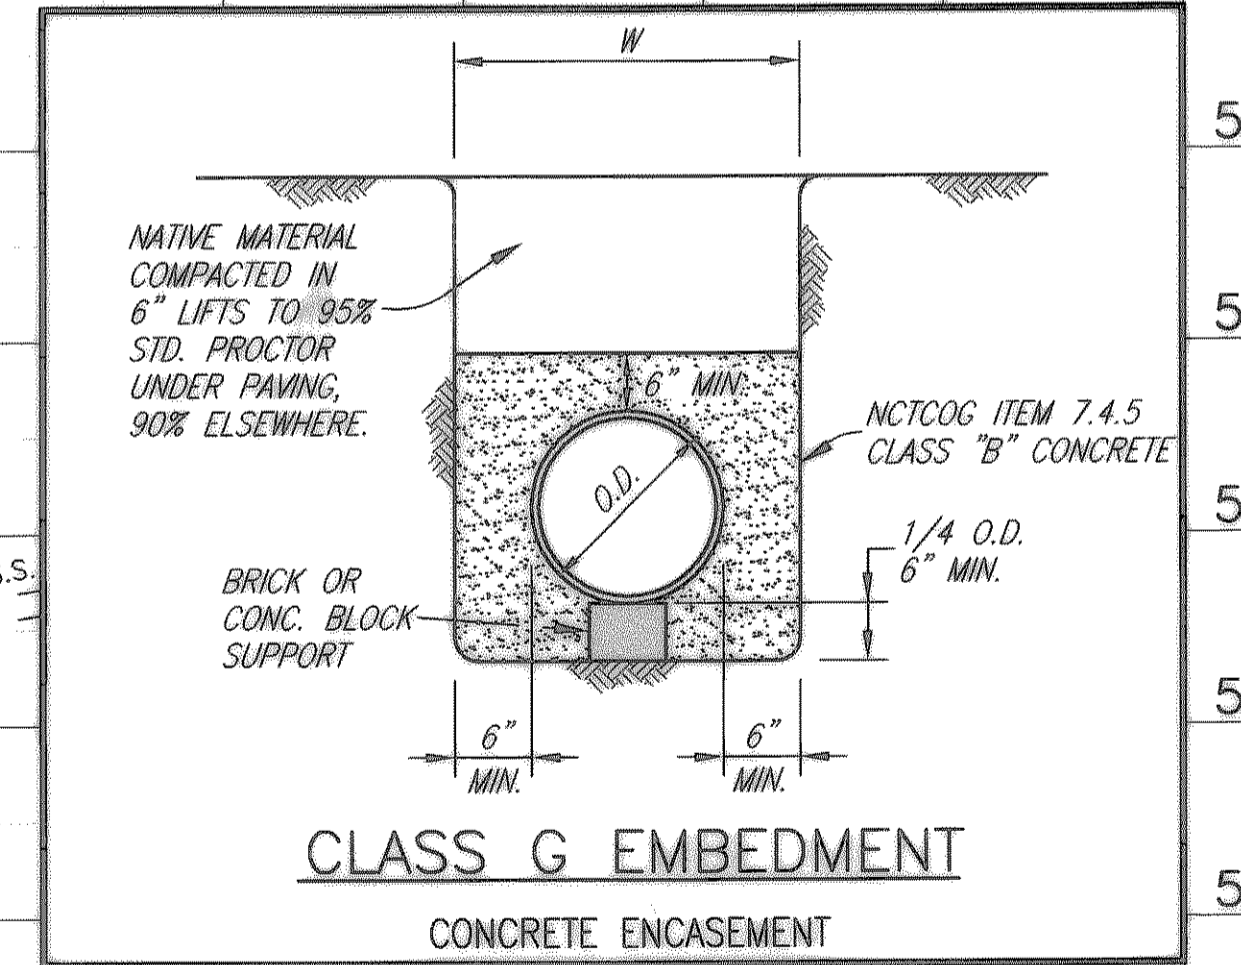


These plans and related specifications were prepared for construction of this specific project only. Reuse of these documents is not permitted without written authorization of Birkhoff, Hendricks & Conway, L.L.P.

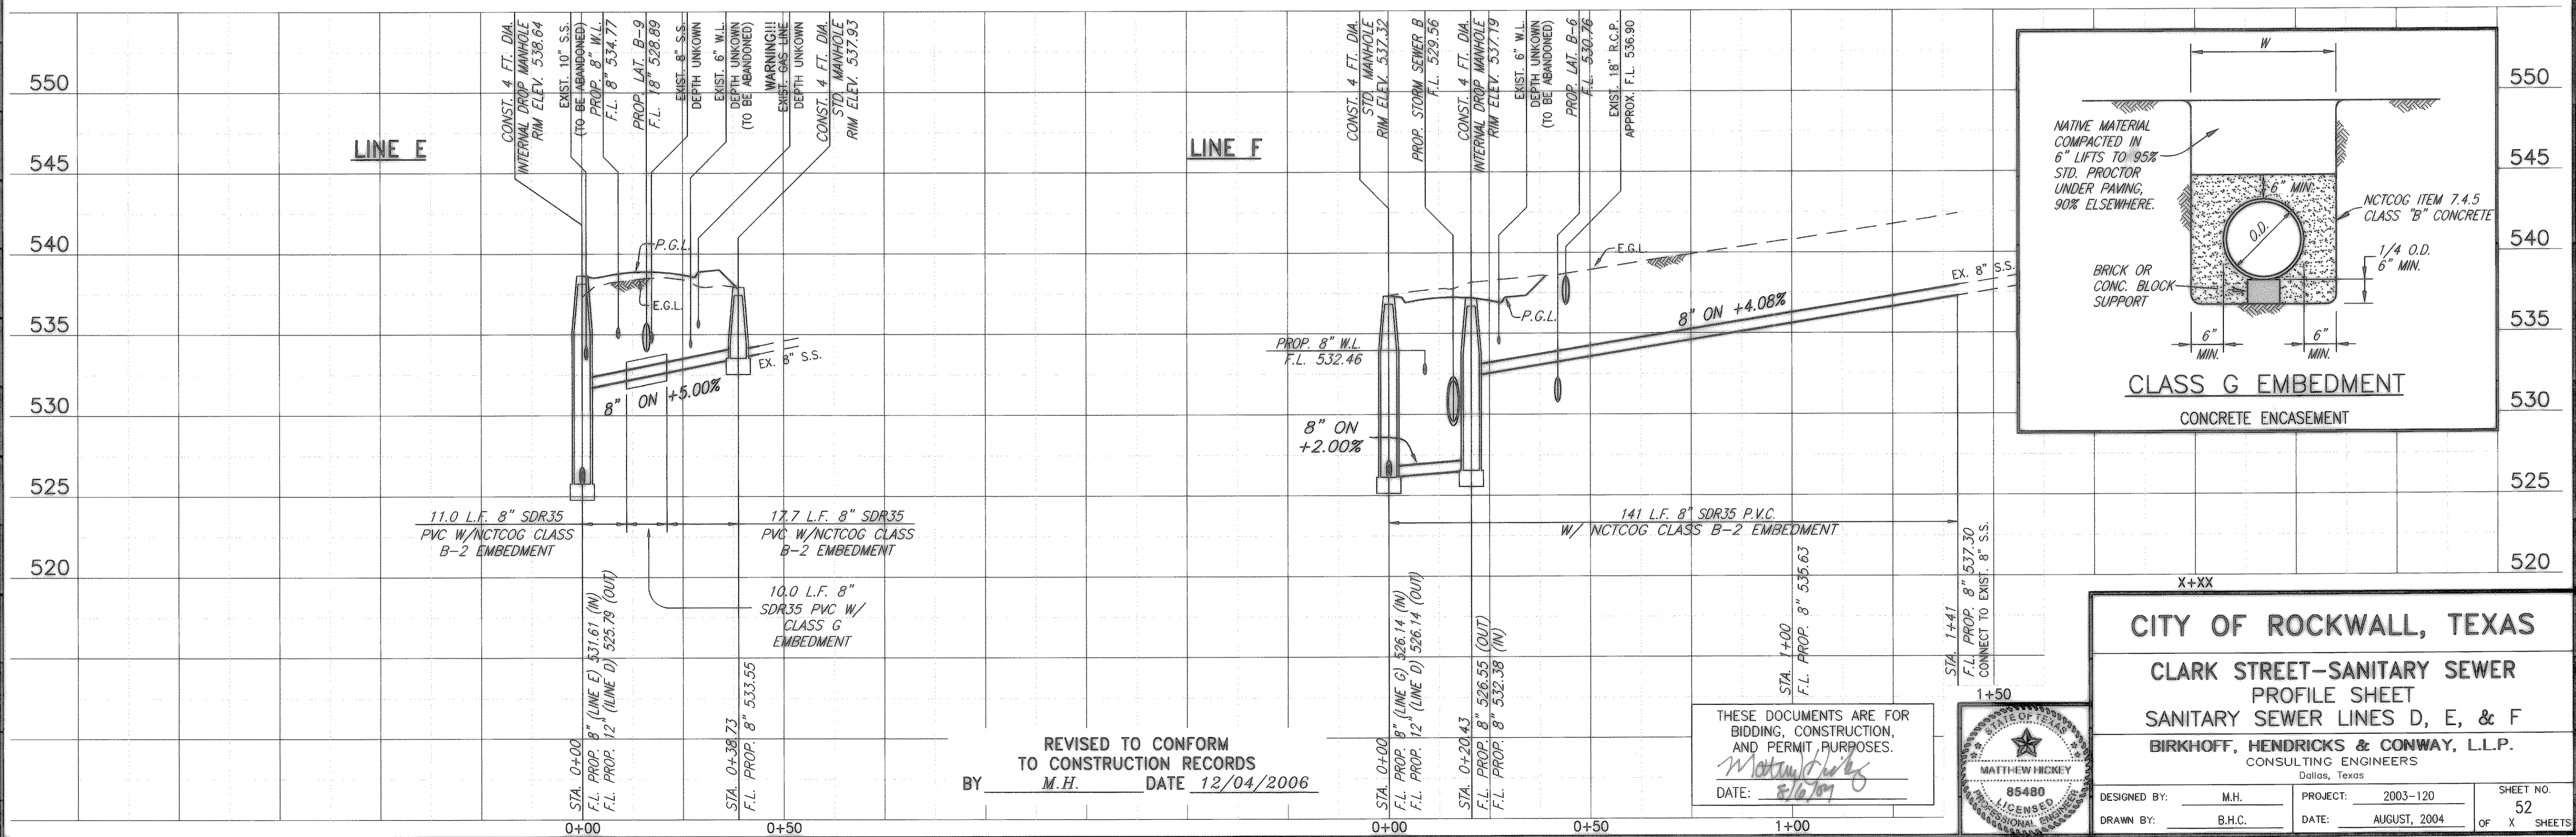

REVISED TO CONFORM TO CONSTRUCTION RECORDS
 BY M.H. DATE 12/04/2006

THESE DOCUMENTS ARE FOR BIDDING, CONSTRUCTION, AND PERMIT PURPOSES.
 DATE: 8/6/04

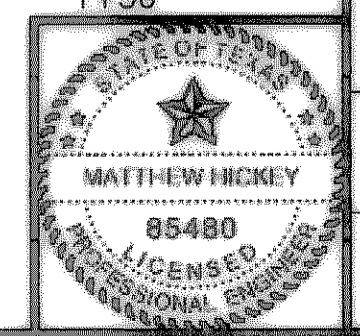

CITY OF ROCKWALL, TEXAS
CLARK STREET-SANITARY SEWER
PROFILE SHEET
SANITARY SEWER LINES D, E, & F
BIRKHOFF, HENDRICKS & CONWAY, L.L.P.
 CONSULTING ENGINEERS
 Dallas, Texas

DESIGNED BY: M.H. PROJECT: 2003-120 SHEET NO. 52
 DRAWN BY: B.H.C. DATE: AUGUST, 2004 OF X SHEETS