
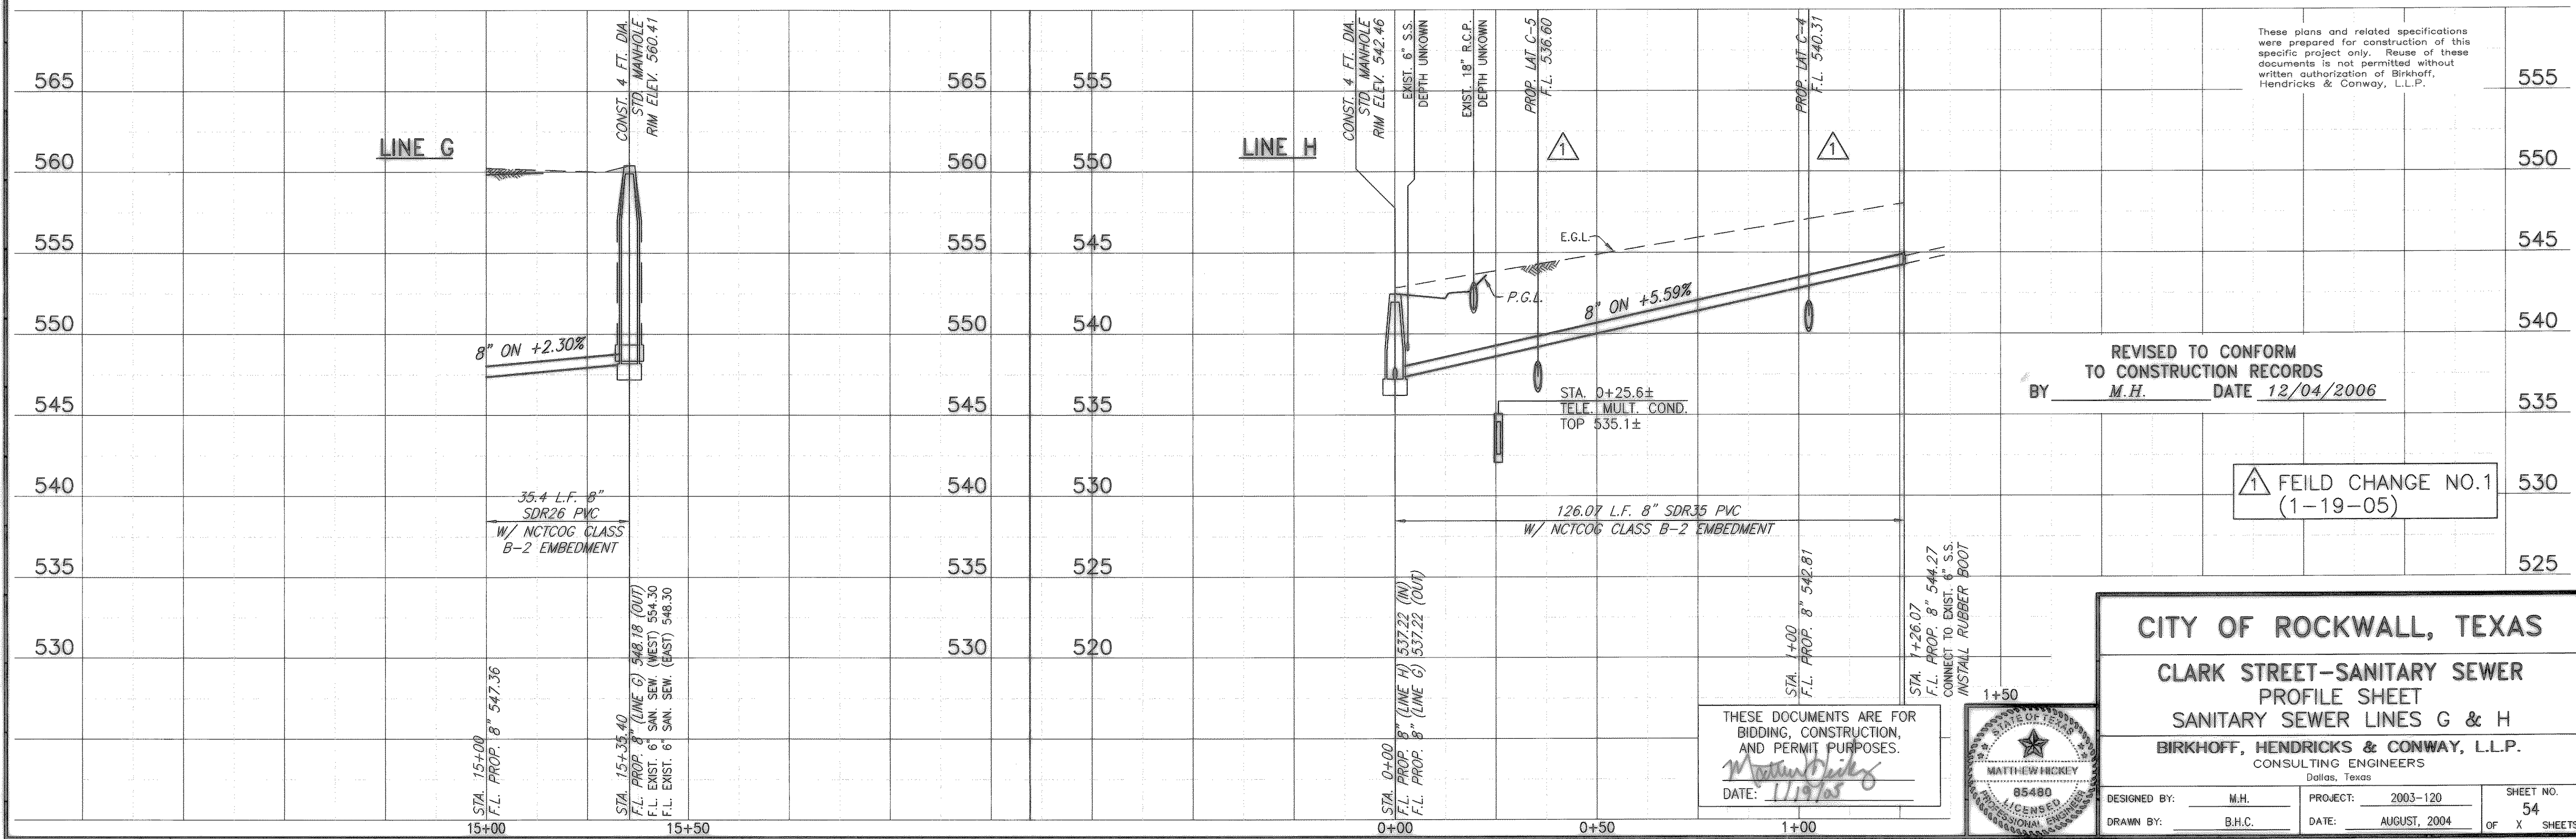


XREF: ROCKWALL\_2003120 V V X

H:\ROCKWALL\_2003120\PLAN-SHEETS\2003120-SAN-PRO-4\DWG SCALE: 1=20 BLOCKS: ROCKWALL\_2003120 V V X

01/16/05 R.L.

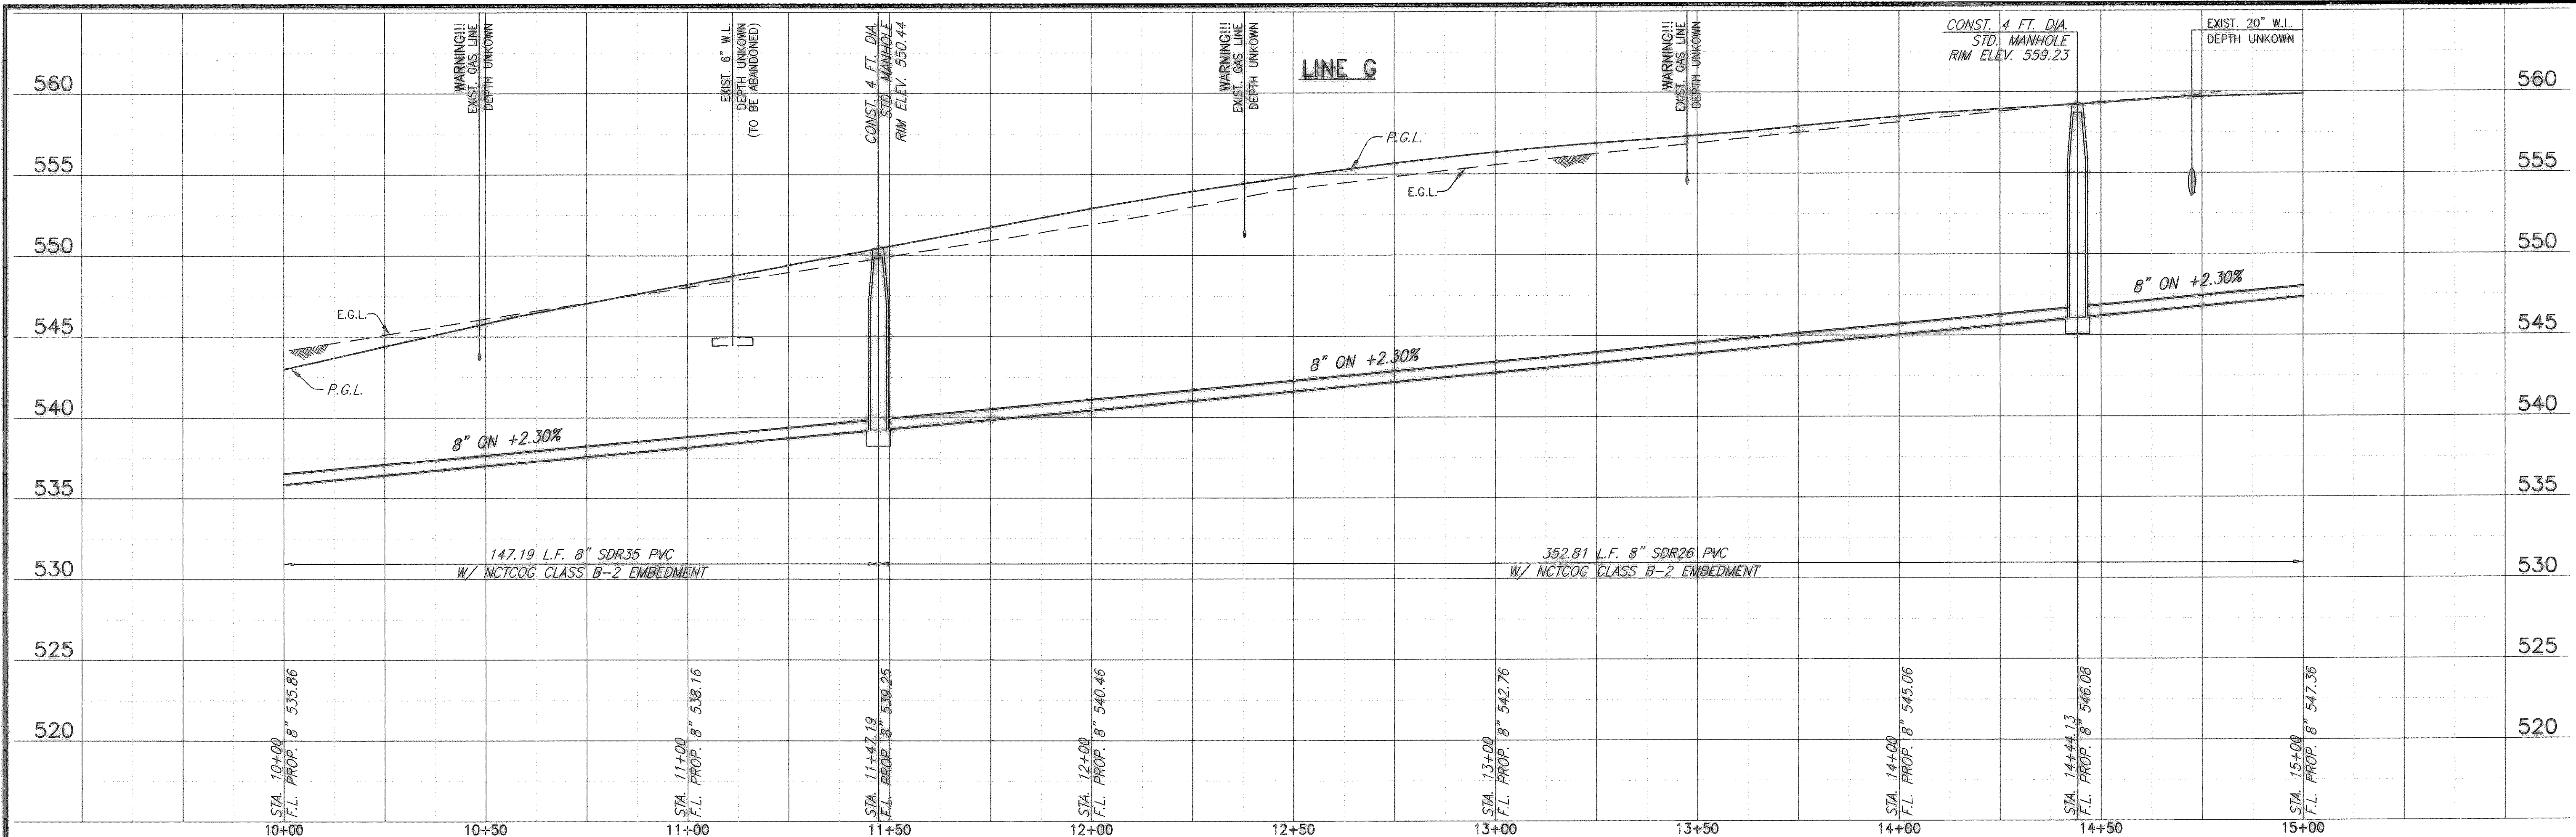


These plans and related specifications were prepared for construction of this specific project only. Reuse of these documents is not permitted without written authorization of Birkhoff, Hendricks & Conway, L.L.P.

REVISED TO CONFORM TO CONSTRUCTION RECORDS  
 BY M.H. DATE 12/04/2006

△ FIELD CHANGE NO.1  
 (1-19-05)

THESE DOCUMENTS ARE FOR BIDDING, CONSTRUCTION, AND PERMIT PURPOSES.  
 DATE: 11/19/05

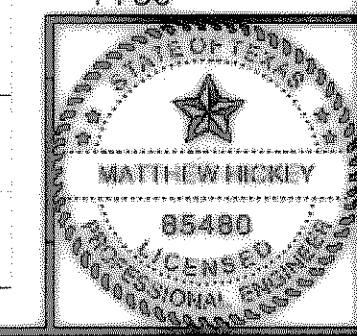

**CITY OF ROCKWALL, TEXAS**  
**CLARK STREET-SANITARY SEWER**  
**PROFILE SHEET**  
**SANITARY SEWER LINES G & H**  
**BIRKHOFF, HENDRICKS & CONWAY, L.L.P.**  
 CONSULTING ENGINEERS  
 Dallas, Texas

DESIGNED BY: M.H. PROJECT: 2003-120 SHEET NO. 54  
 DRAWN BY: B.H.C. DATE: AUGUST, 2004 OF X SHEETS