
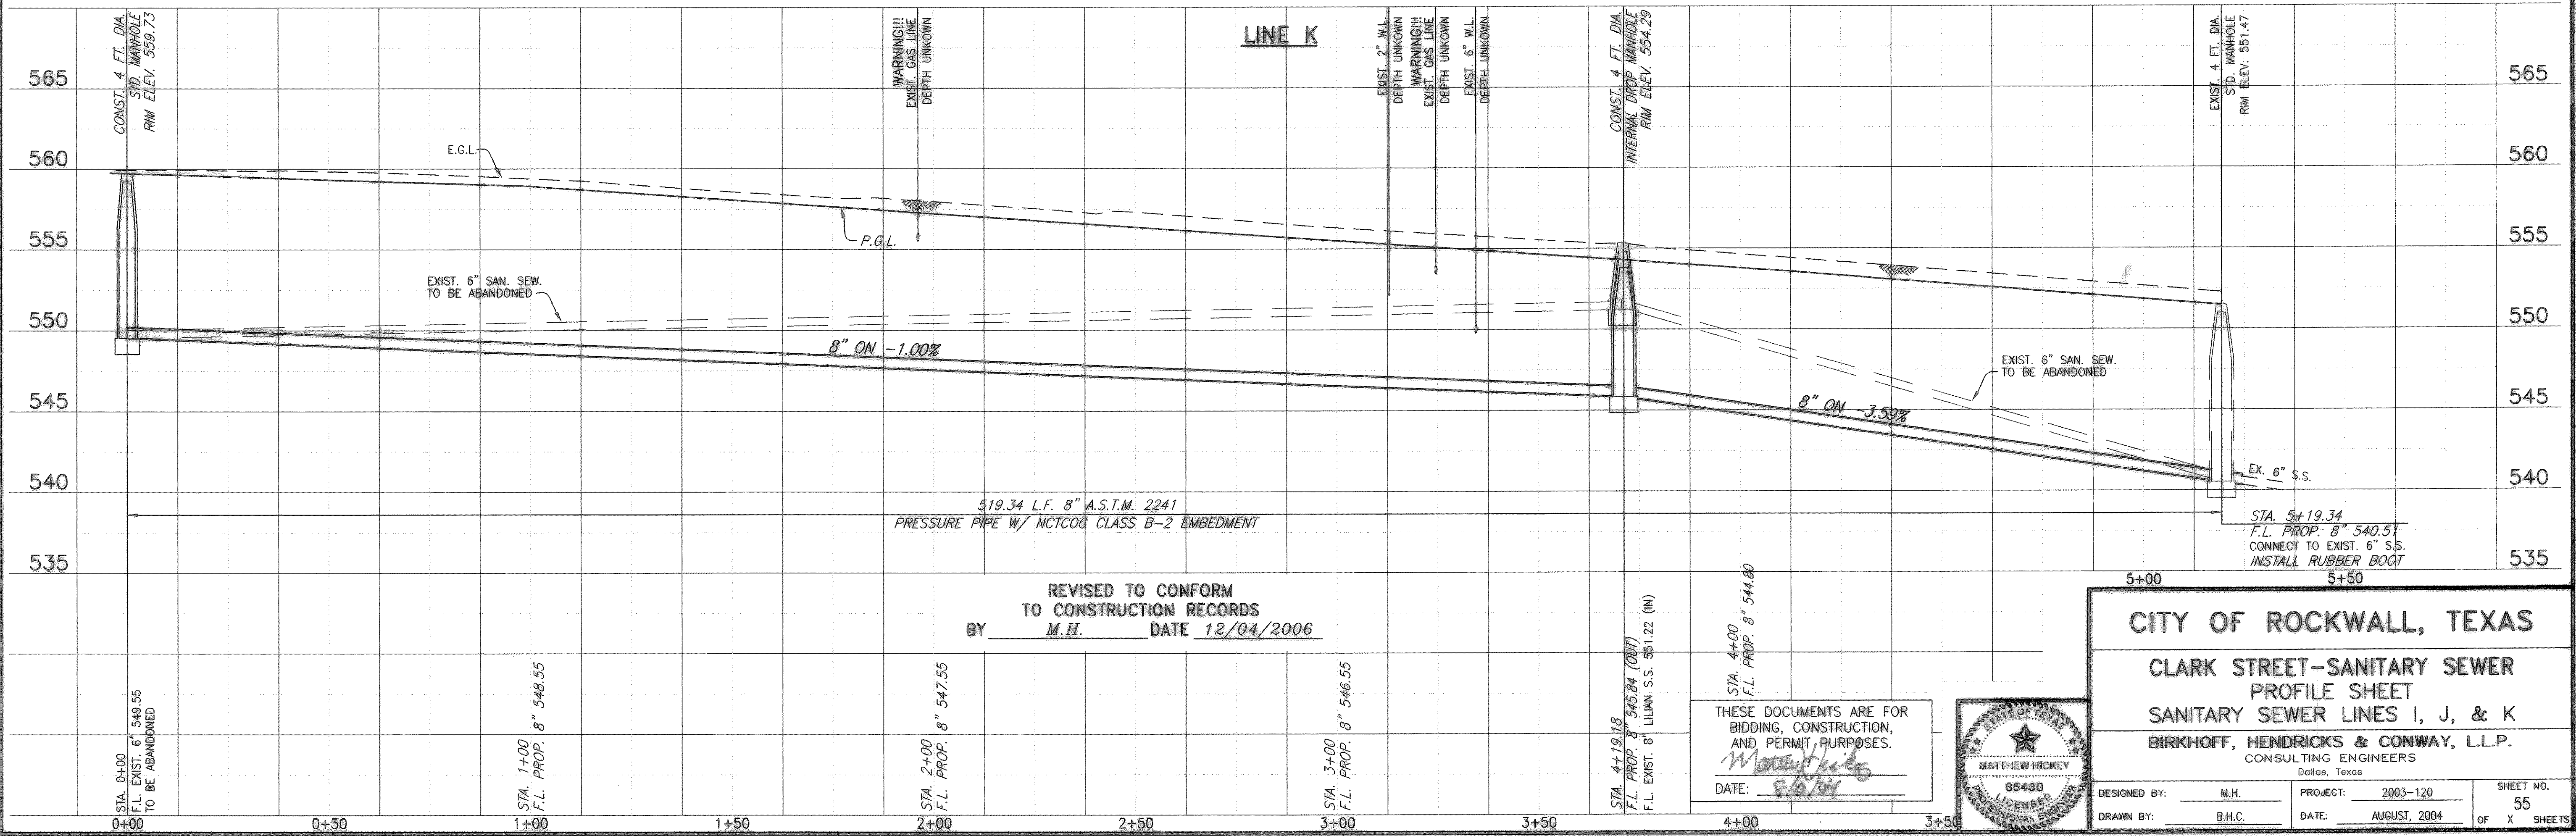


XREF: ROCKWALL\_20031201.X


H:\ROCKWALL\20031201\PLAN-SHEETS\20031201-SAN-PRO-5.DWG SCALE: 1"=20' BLOCKS: ROCKWALL\_20031201.X

10/25/04 R.L

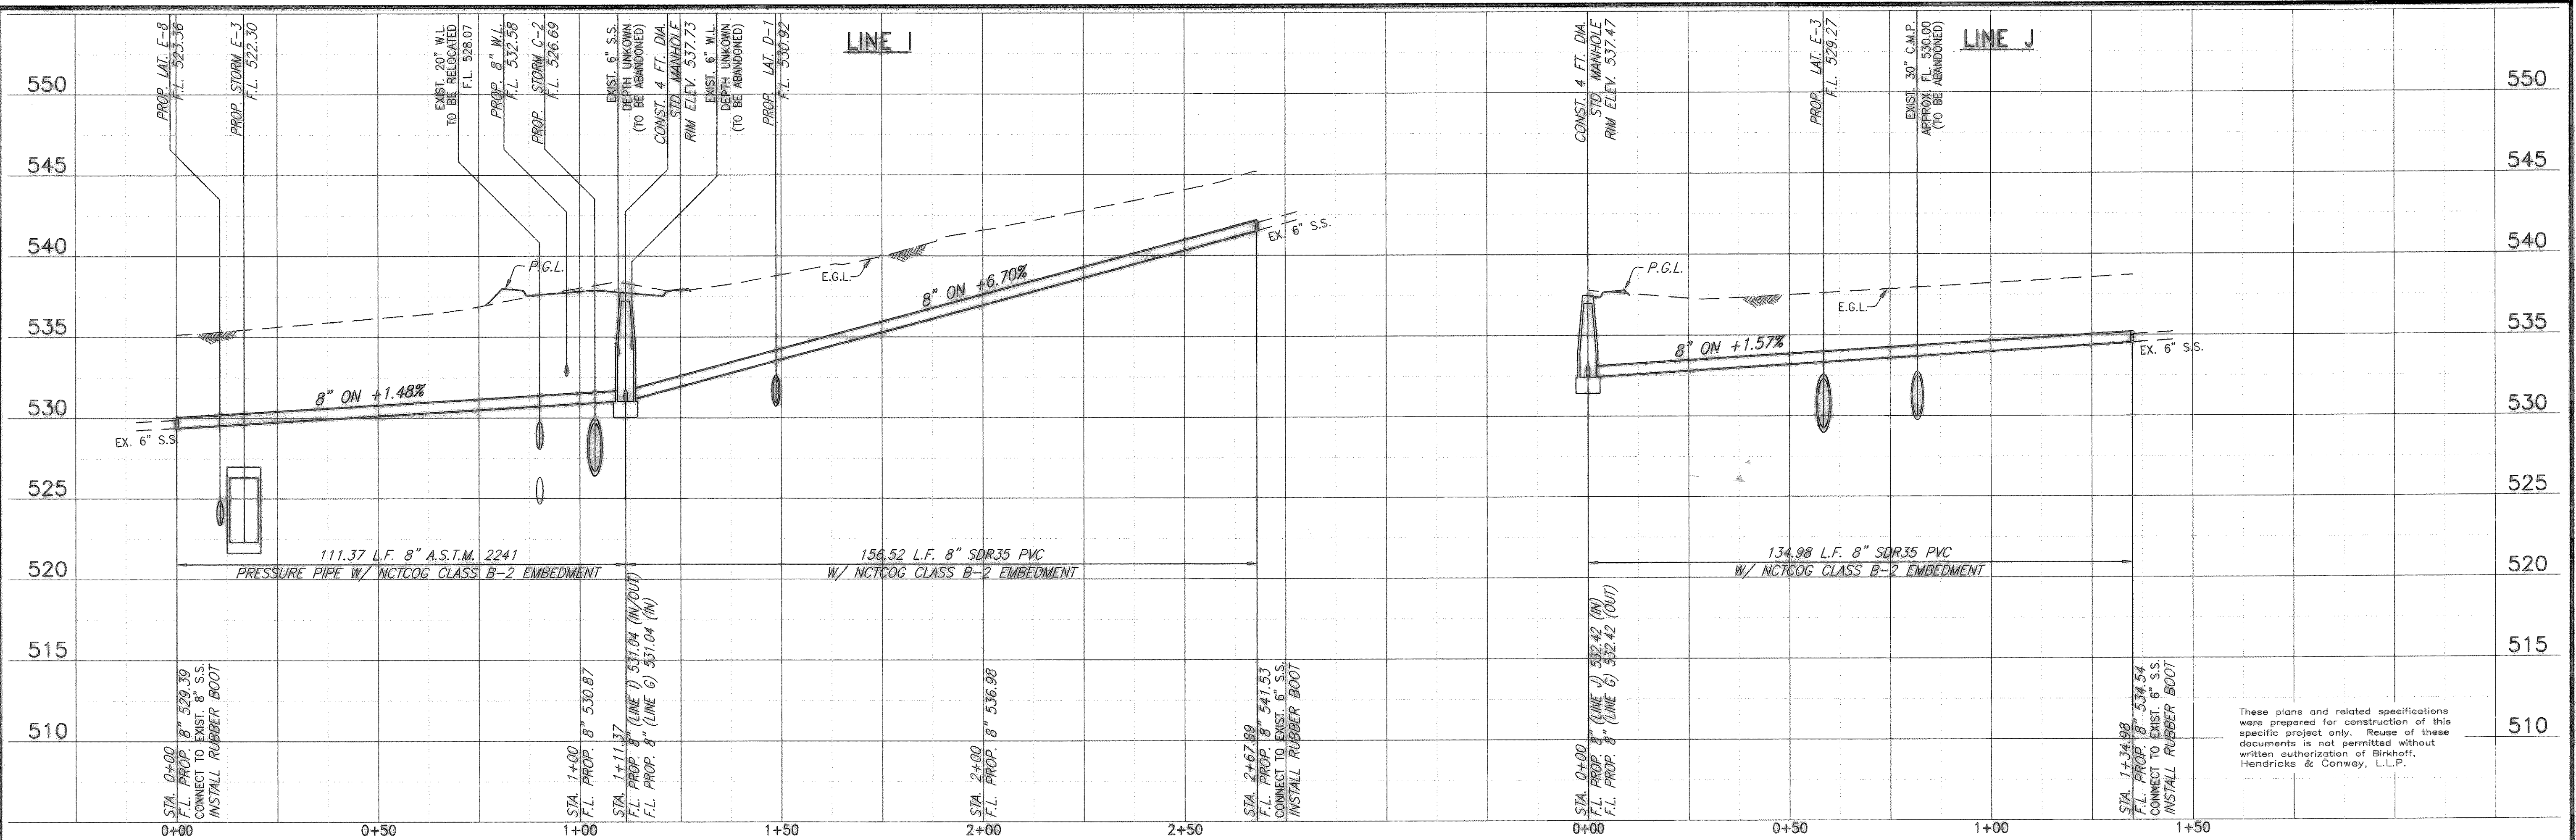

REVISED TO CONFORM  
TO CONSTRUCTION RECORDS  
BY M.H. DATE 12/04/2006

THESE DOCUMENTS ARE FOR  
BIDDING, CONSTRUCTION,  
AND PERMIT PURPOSES.  
*Matthew Hickey*  
DATE: 8/6/04

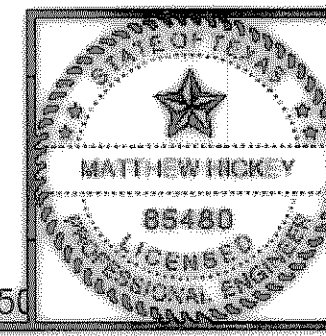

**CITY OF ROCKWALL, TEXAS**  
**CLARK STREET-SANITARY SEWER**  
**PROFILE SHEET**  
**SANITARY SEWER LINES I, J, & K**  
**BIRKHOFF, HENDRICKS & CONWAY, L.L.P.**  
 CONSULTING ENGINEERS  
 Dallas, Texas

DESIGNED BY: M.H. PROJECT: 2003-120 SHEET NO. 55  
 DRAWN BY: B.H.C. DATE: AUGUST, 2004 OF X SHEETS

These plans and related specifications were prepared for construction of this specific project only. Reuse of these documents is not permitted without written authorization of Birkhoff, Hendricks & Conway, L.L.P.