



REF: ROCKWALL\_20031201.VXD

BLOCKS: ROCKWALL\_20031201.VXD

SCALE: 1"=20'


H: ROCKWALL\_20031201.PLAN-SHEETS\20031201-SHM.DWG

08/03/04 LBS

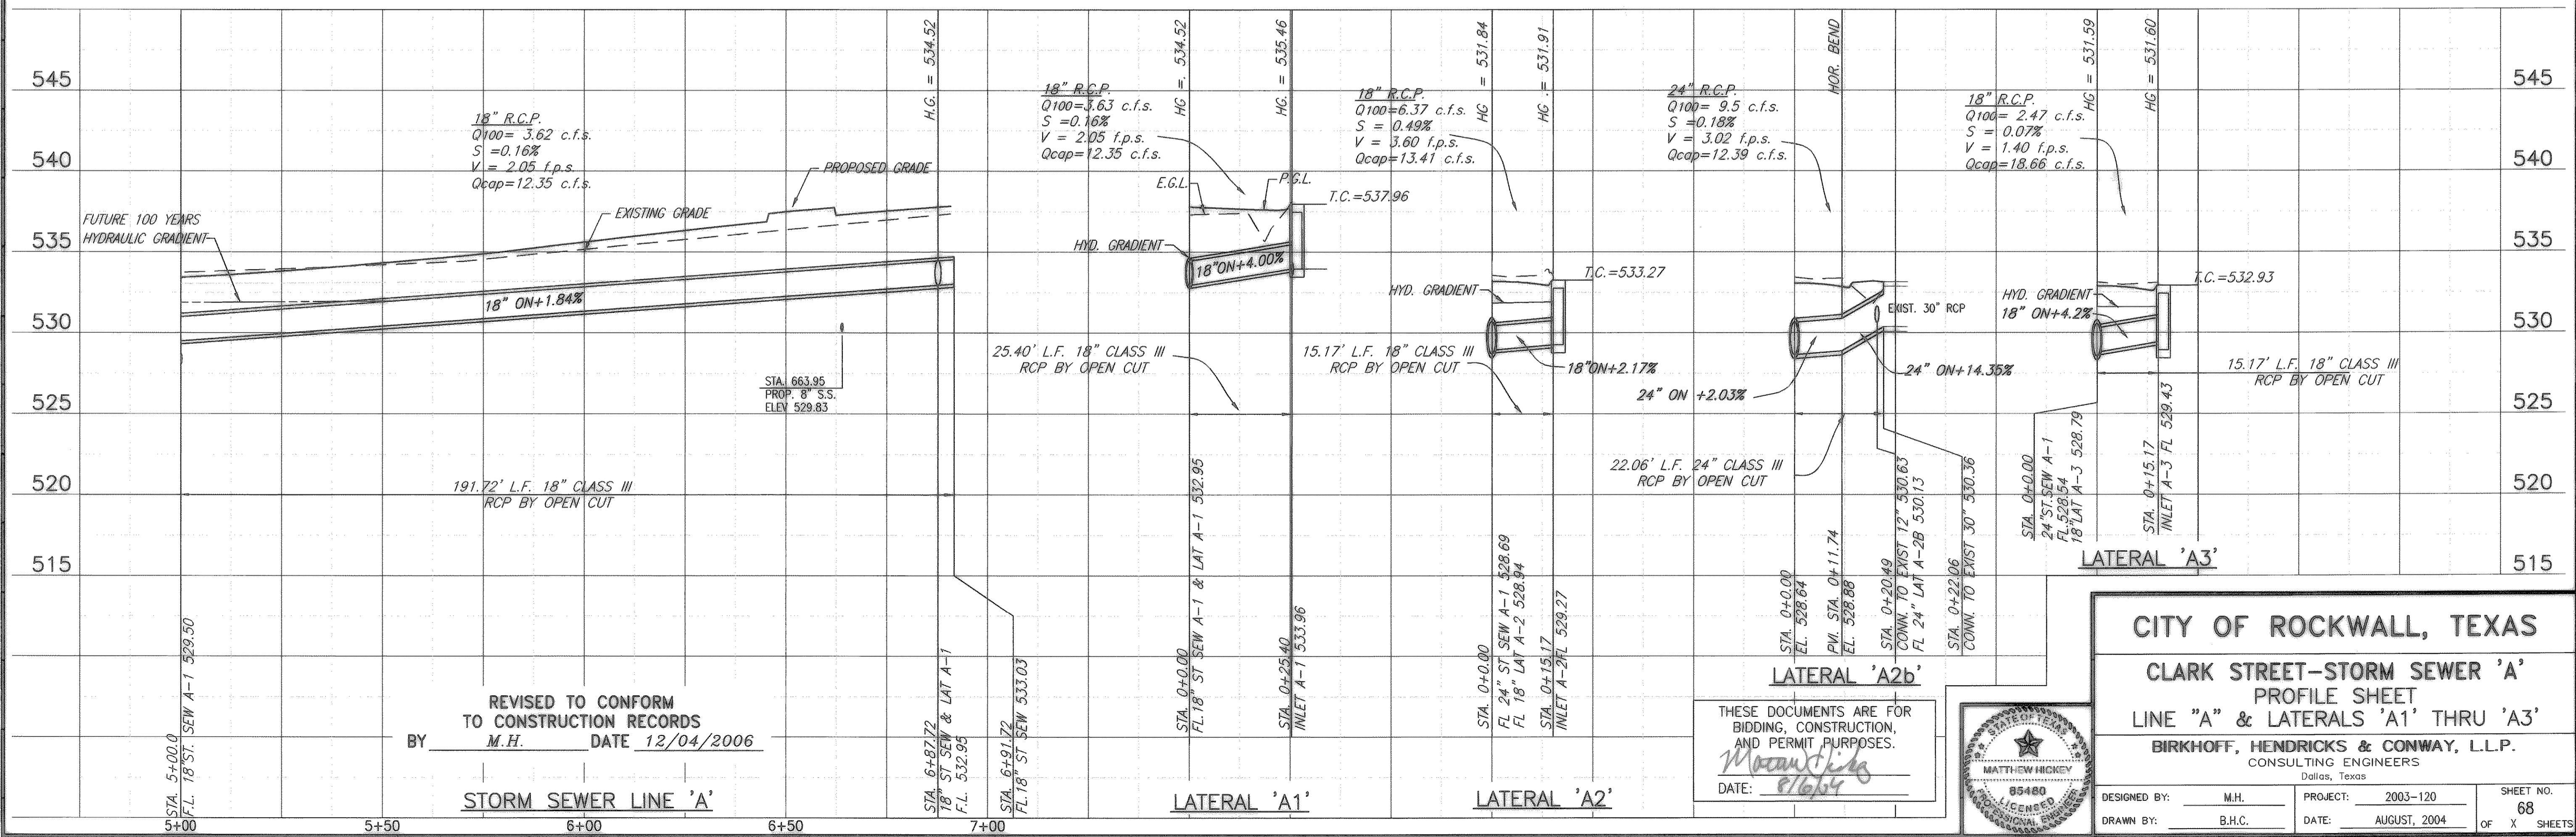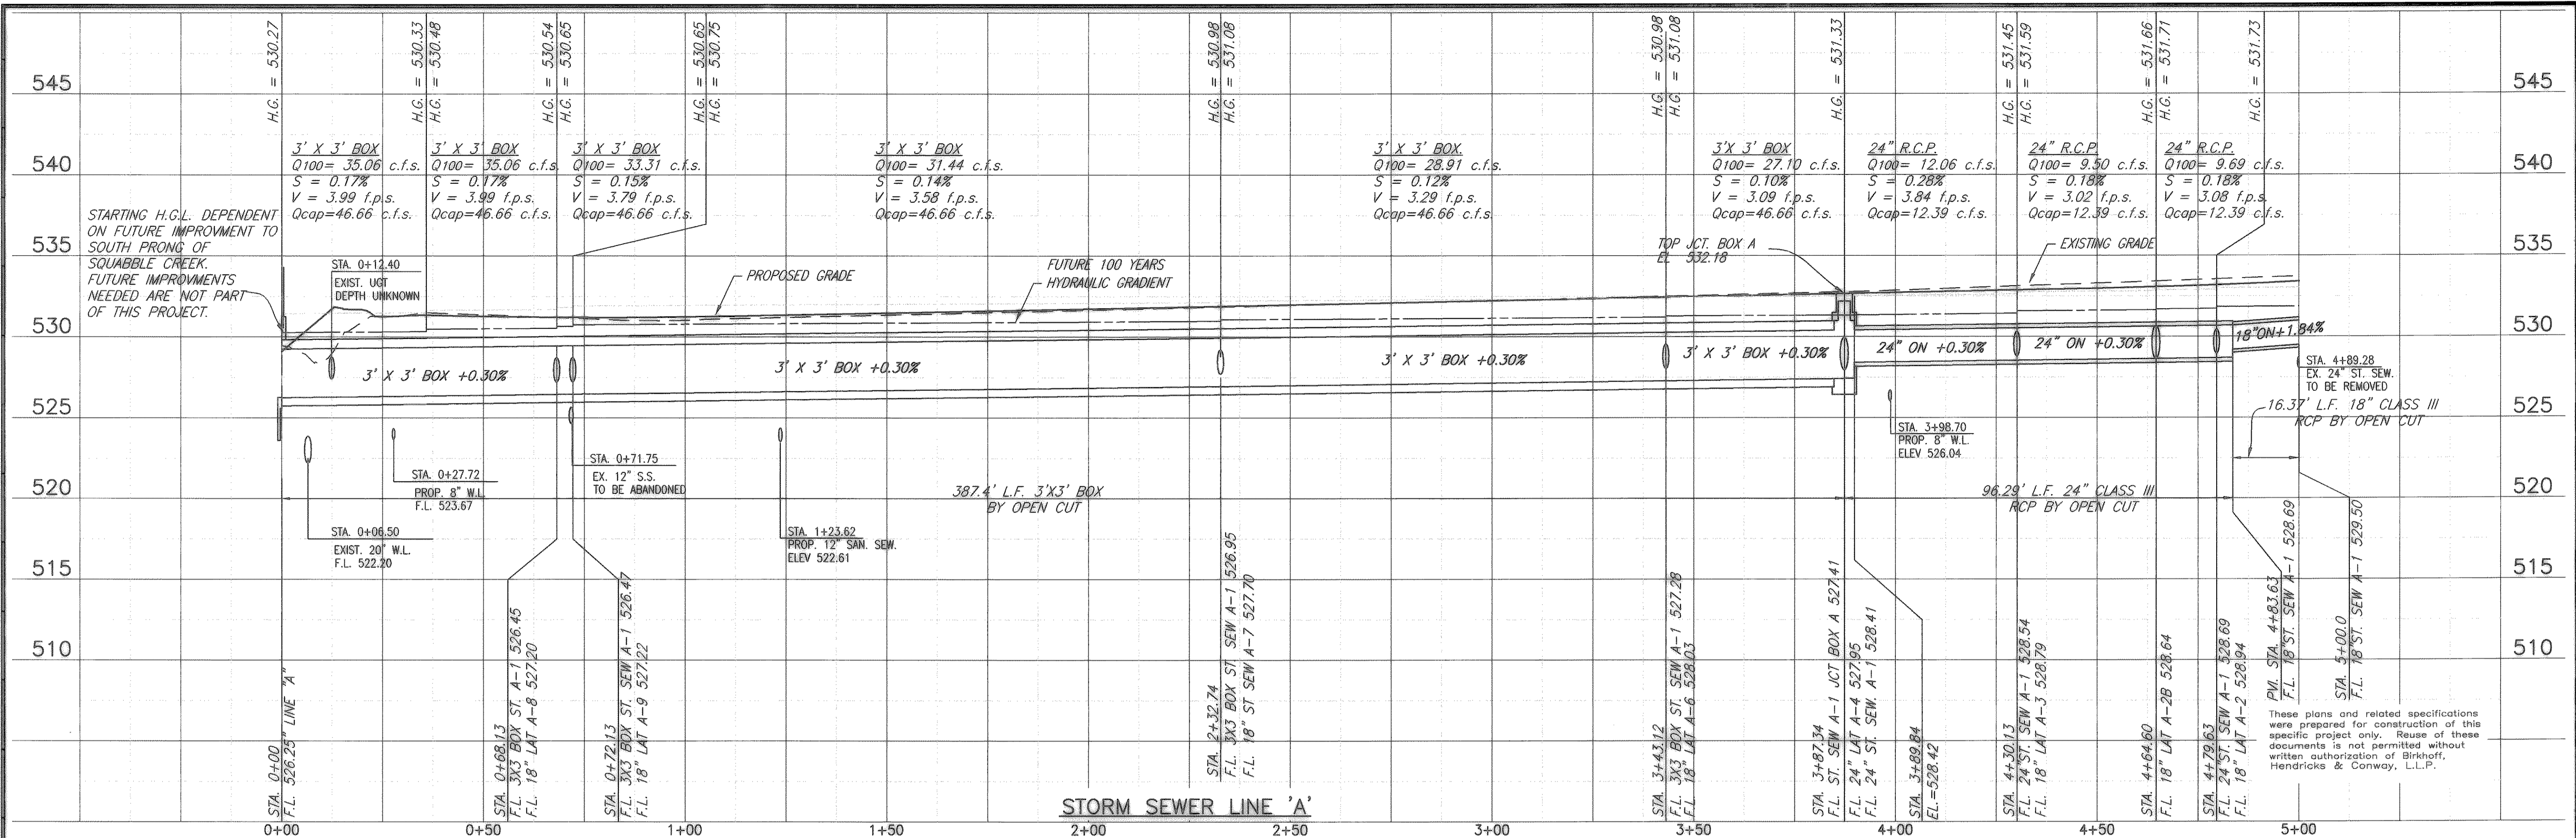

REVISED TO CONFORM  
TO CONSTRUCTION RECORDS  
BY M.H. DATE 12/04/2006

THESE DOCUMENTS ARE FOR  
BIDDING, CONSTRUCTION,  
AND PERMIT PURPOSES.  
*Morgan*  
DATE: 8/6/04

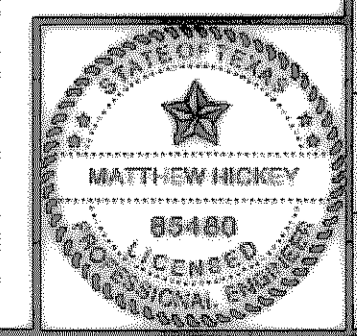

**CITY OF ROCKWALL, TEXAS**  
**CLARK STREET-STORM SEWER 'A'**  
**PROFILE SHEET**  
**LINE 'A' & LATERALS 'A1' THRU 'A3'**  
**BIRKHOFF, HENDRICKS & CONWAY, L.L.P.**  
 CONSULTING ENGINEERS  
 Dallas, Texas

DESIGNED BY: M.H. PROJECT: 2003-120 SHEET NO. 68  
 DRAWN BY: B.H.C. DATE: AUGUST, 2004 OF X SHEETS