


REVISED TO CONFORM  
TO CONSTRUCTION RECORDS  
BY M.H. DATE 12/04/2006

THESE DOCUMENTS ARE FOR  
BIDDING, CONSTRUCTION,  
AND PERMIT PURPOSES.  
*Matthew Hickey*  
DATE: 8/6/04

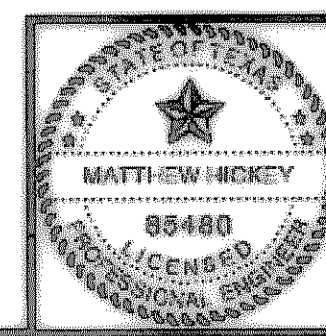

**CITY OF ROCKWALL, TEXAS**

**CLARK STREET-STORM SEWER 'D'  
LINE 'D1' & LATERALS 'D-1' THRU 'D-2b'**

**BIRKHOFF, HENDRICKS & CONWAY, L.L.P.**  
CONSULTING ENGINEERS  
Dallas, Texas

DESIGNED BY: M.H. PROJECT: 2003-120 SHEET NO. 73  
DRAWN BY: B.H.C. DATE: AUGUST, 2004 OF X SHEETS

These plans and related specifications  
were prepared for construction of this  
specific project only. Reuse of these  
documents is not permitted without  
written authorization of Birkhoff,  
Hendricks & Conway, L.L.P.