
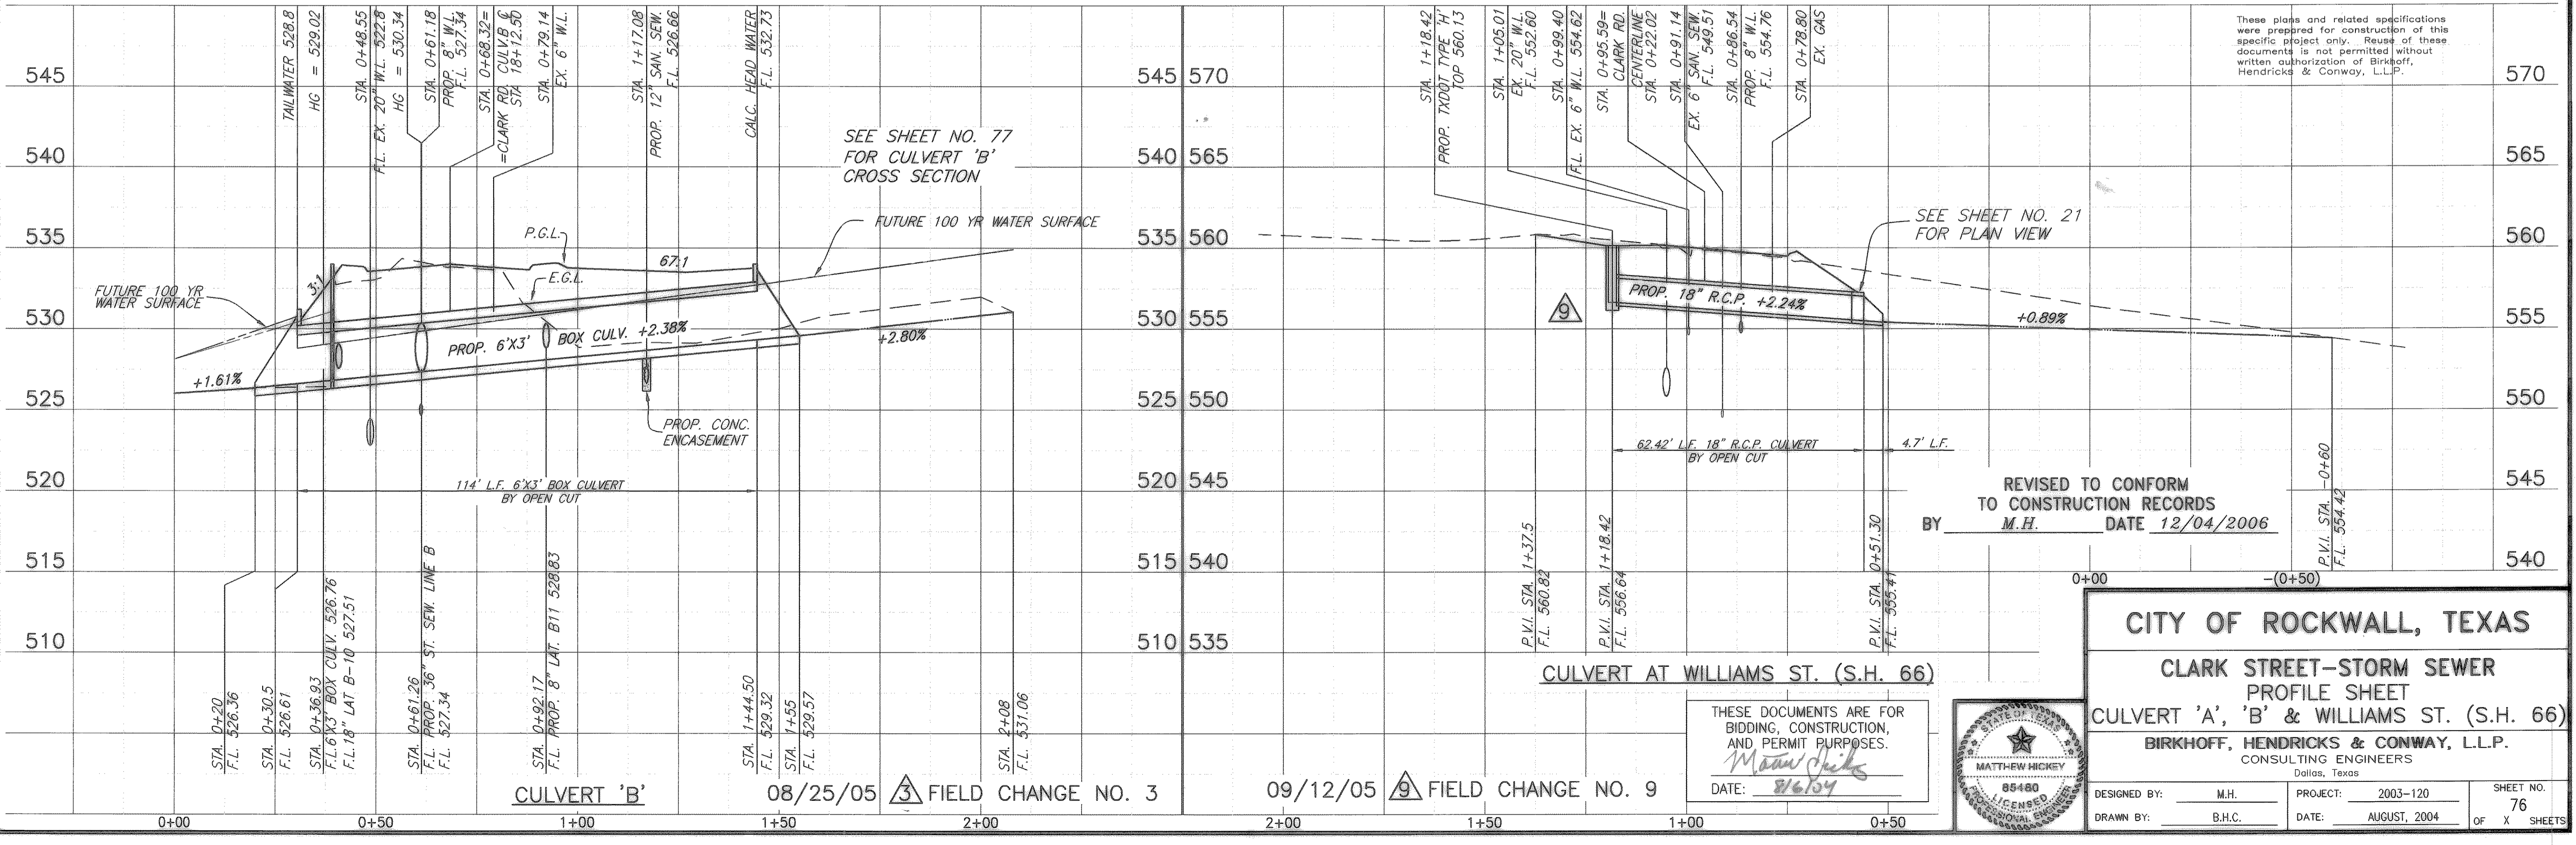
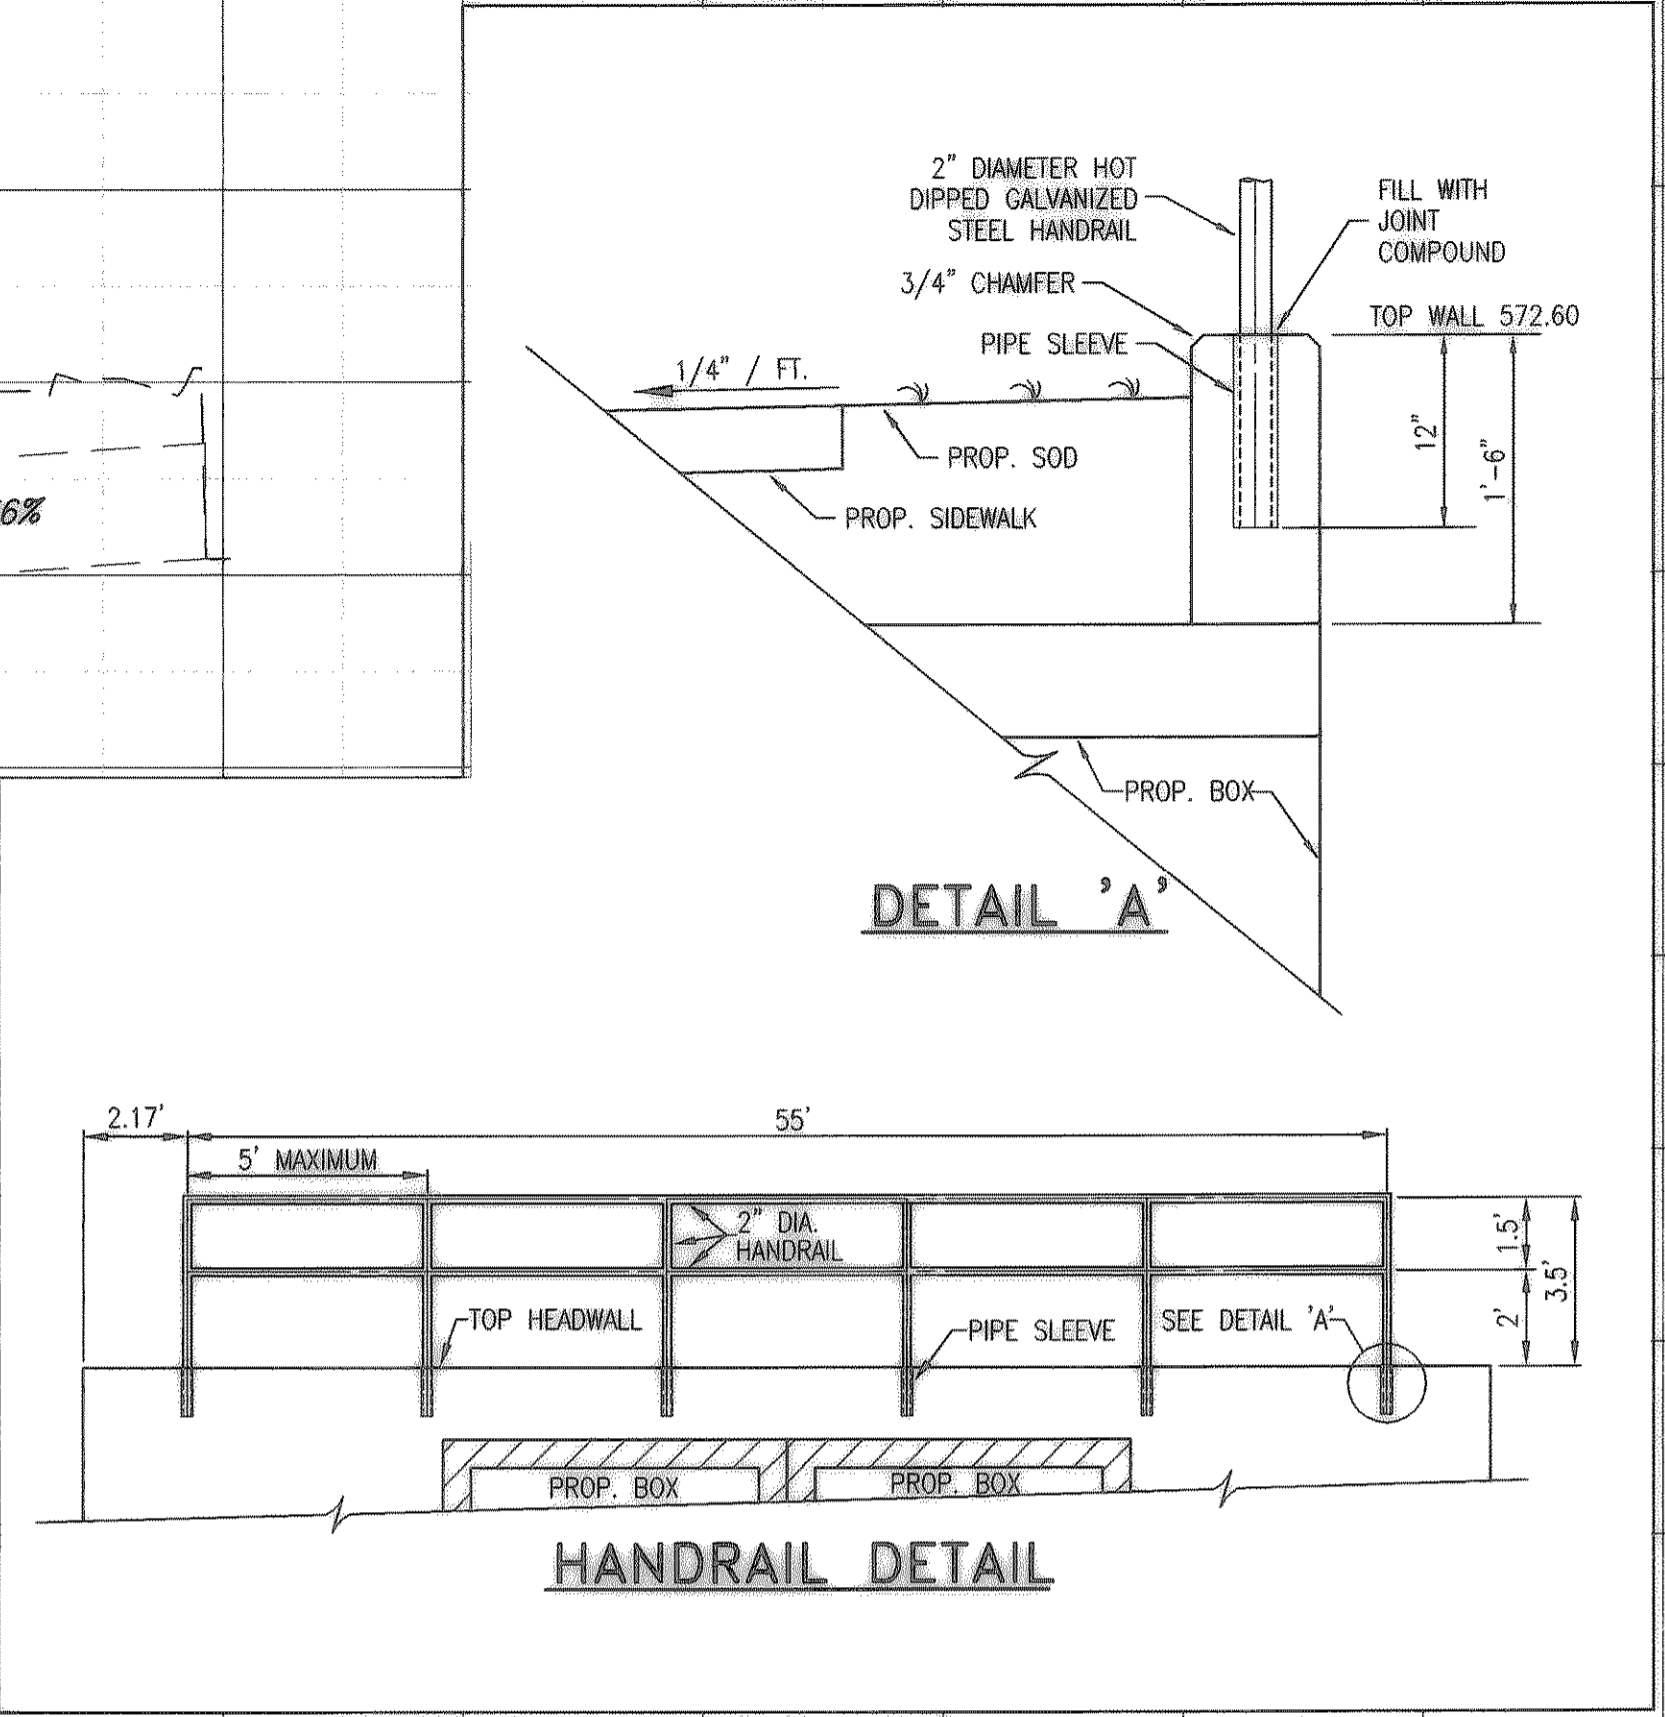


08/27/04 RUL H:\ROCKWALL\2003120\PLAN-SHEETS\2003120-STM9.DWG SCALE: 1=20 BLOCKS: ROCKWALL\2003120\X-Y XREF: ROCKWALL\2003120\X-Y

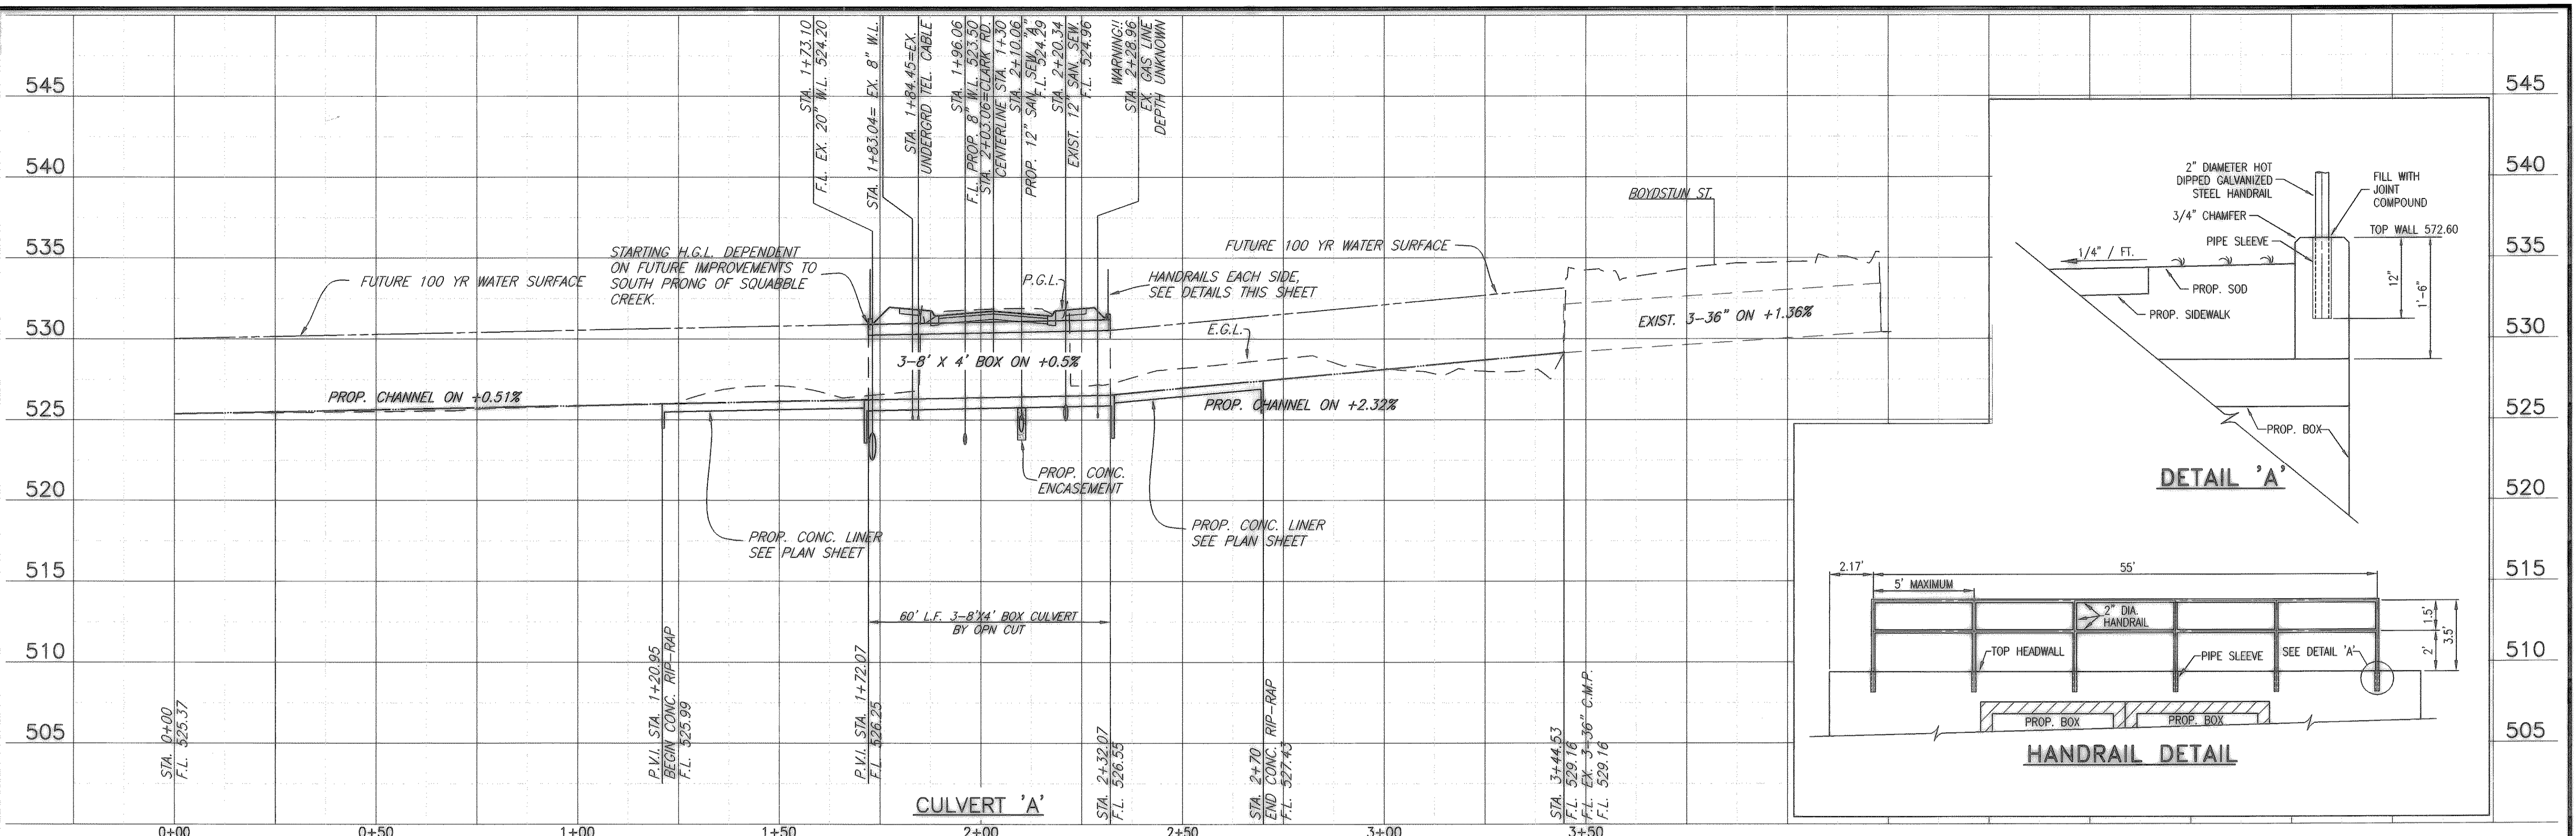


These plans and related specifications were prepared for construction of this specific project only. Reuse of these documents is not permitted without written authorization of Birkhoff, Hendricks & Conway, L.L.P.

REVISED TO CONFORM TO CONSTRUCTION RECORDS BY M.H. DATE 12/04/2006

CULVERT AT WILLIAMS ST. (S.H. 66)

THESE DOCUMENTS ARE FOR BIDDING, CONSTRUCTION, AND PERMIT PURPOSES.
 DATE: 8/6/04
 Matthew Hickey

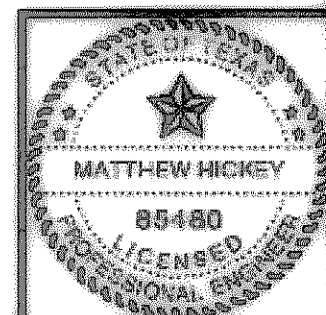

CITY OF ROCKWALL, TEXAS

**CLARK STREET-STORM SEWER
 PROFILE SHEET
 CULVERT 'A', 'B' & WILLIAMS ST. (S.H. 66)**

BIRKHOFF, HENDRICKS & CONWAY, L.L.P.
 CONSULTING ENGINEERS
 Dallas, Texas

DESIGNED BY: M.H.	PROJECT: 2003-120	SHEET NO. 76
DRAWN BY: B.H.C.	DATE: AUGUST, 2004	OF X SHEETS

08/25/05 FIELD CHANGE NO. 3

09/12/05 FIELD CHANGE NO. 9