
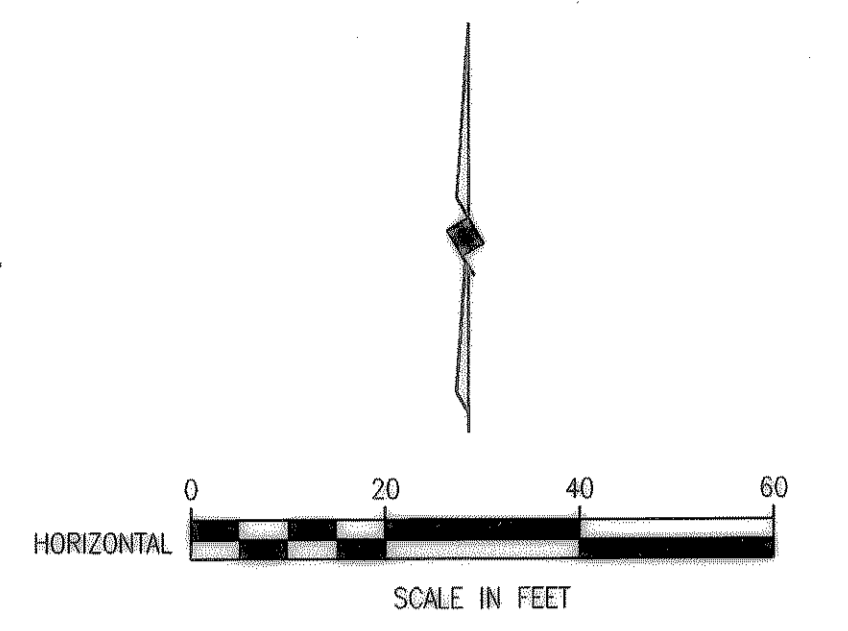



REF: ROCKWALL\2003120\1.X

SCALE: 1"=20' BLOCKS: ROCKWALL\2003120\1.X

01/17/05 R.L. H:\ROCKWALL\2003120\PLAN-SHEETS\2003120--SAN-WL-9.DWG

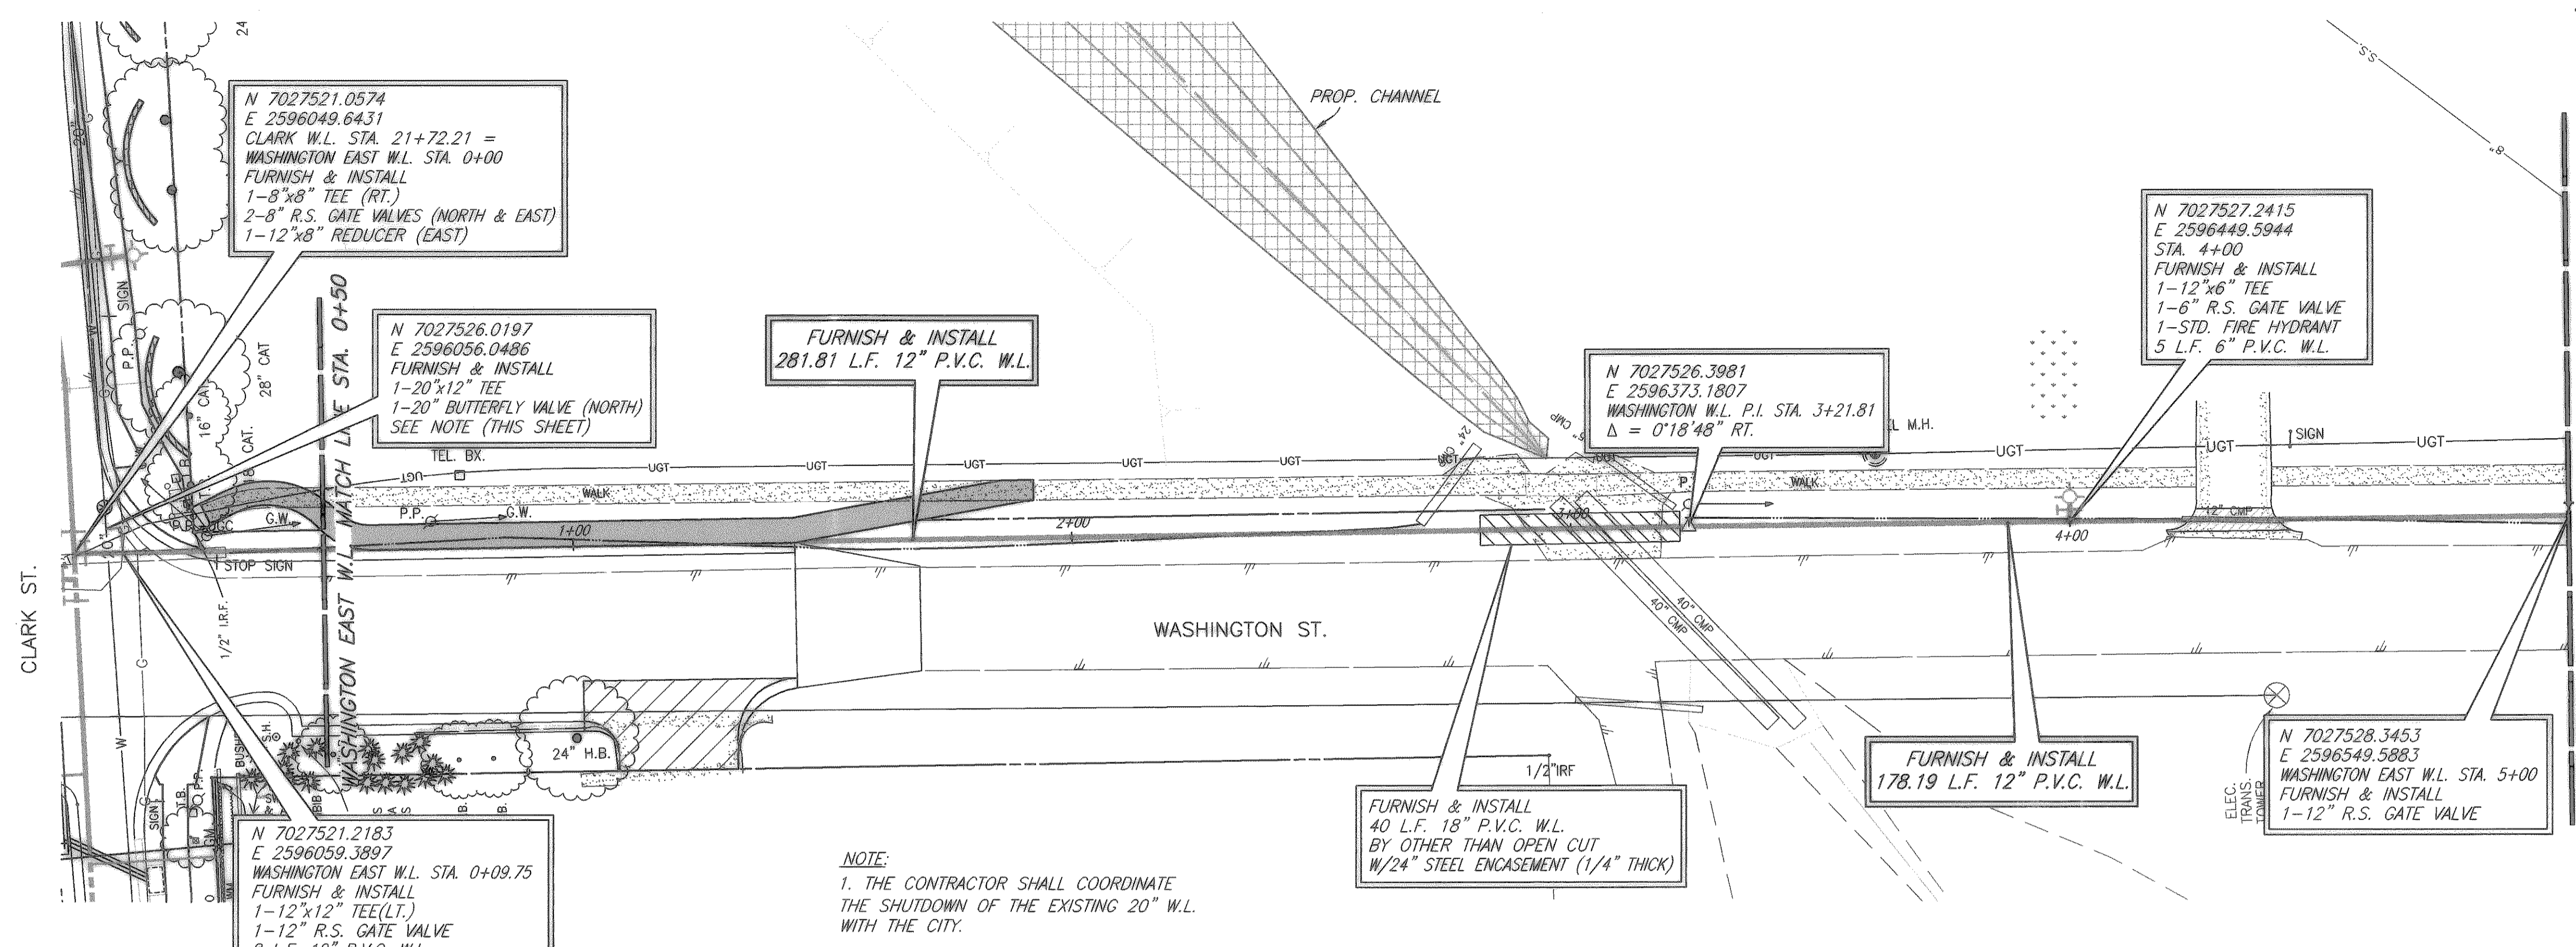


These plans and related specifications were prepared for construction of this specific project only. Reuse of these documents is not permitted without written authorization of Birkhoff, Hendricks & Conway, L.L.P.

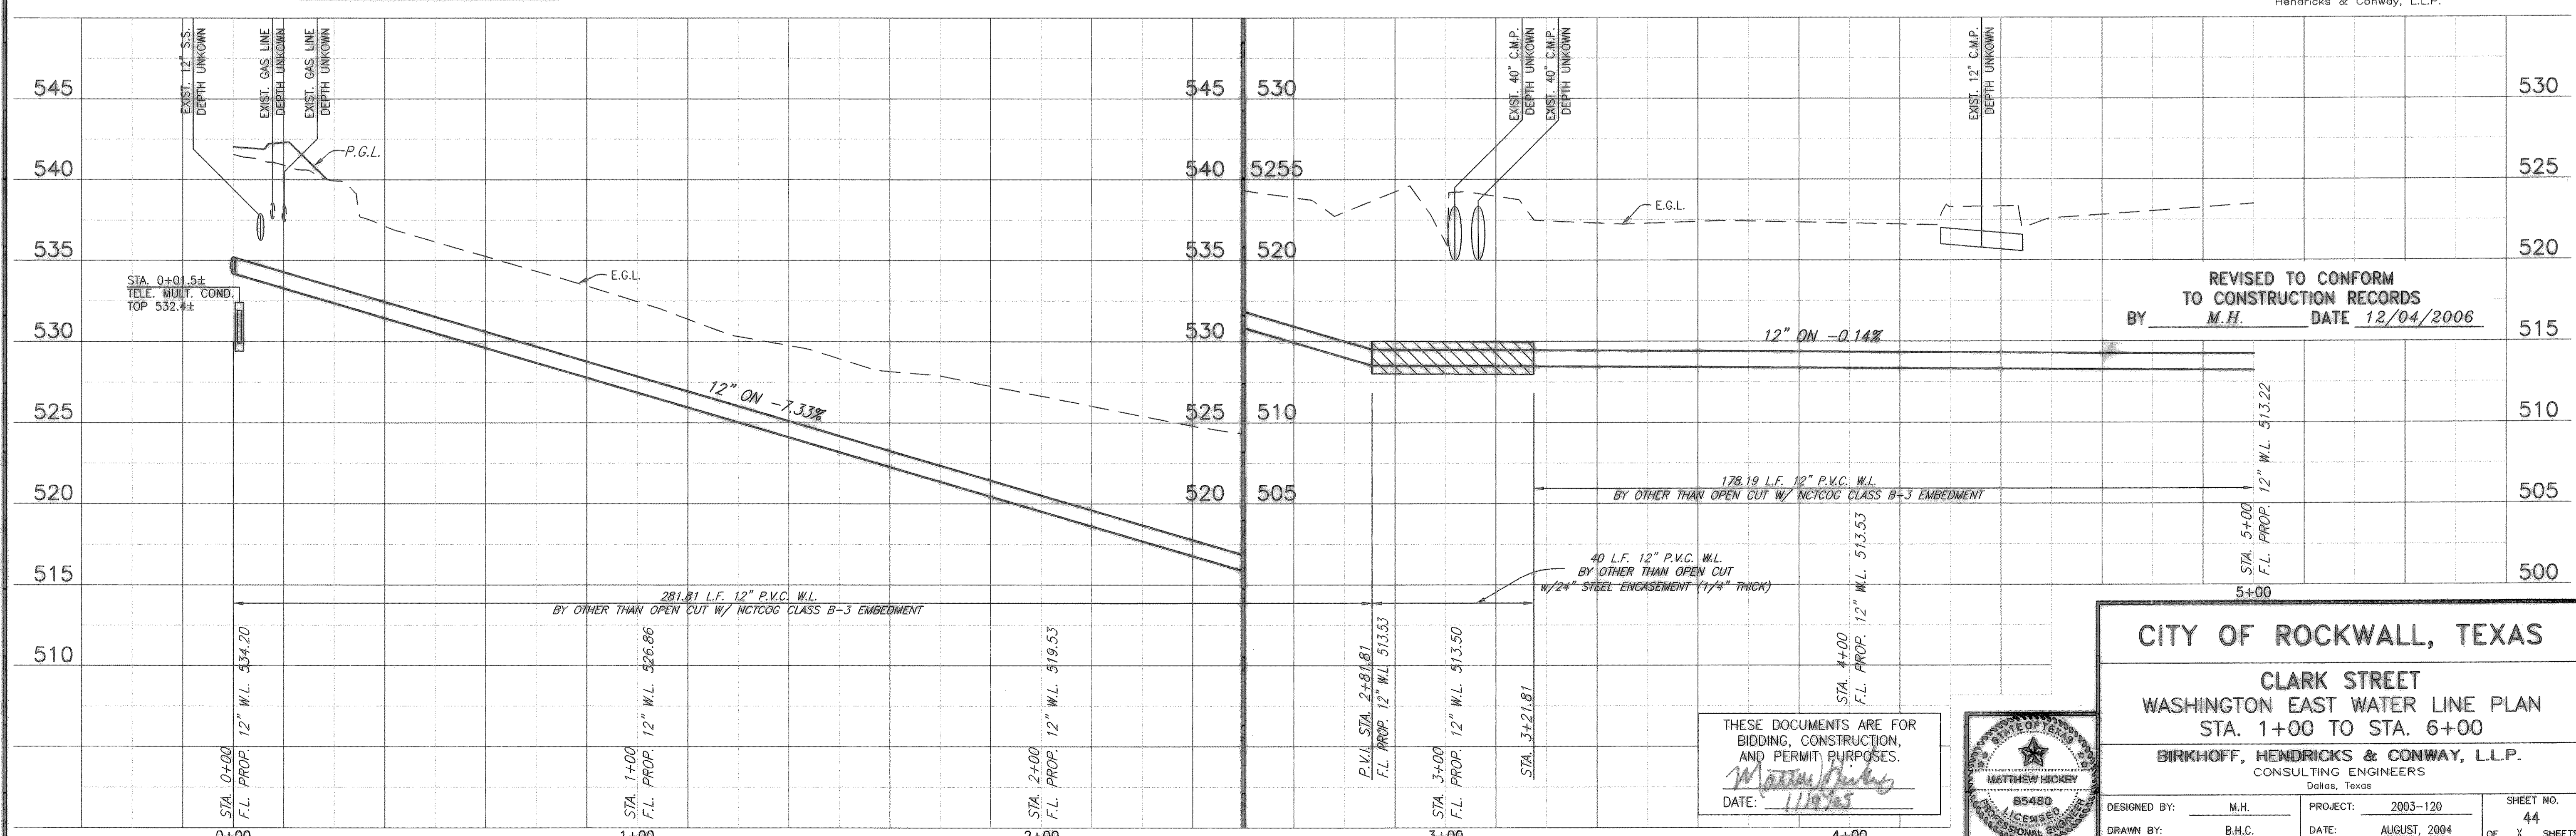

REVISED TO CONFORM TO CONSTRUCTION RECORDS  
BY M.H. DATE 12/04/2006

THESE DOCUMENTS ARE FOR BIDDING, CONSTRUCTION, AND PERMIT PURPOSES.  
*Matthew Hickey*  
DATE: 1/19/05

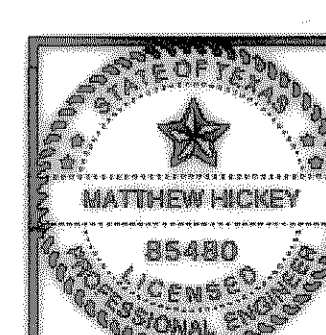

**CITY OF ROCKWALL, TEXAS**

**CLARK STREET**  
**WASHINGTON EAST WATER LINE PLAN**  
STA. 1+00 TO STA. 6+00

**BIRKHOFF, HENDRICKS & CONWAY, L.L.P.**  
CONSULTING ENGINEERS  
Dallas, Texas

DESIGNED BY: M.H. PROJECT: 2003-120 SHEET NO. 44  
DRAWN BY: B.H.C. DATE: AUGUST, 2004 OF X SHEETS